KEYED NOTES	
NOTE #	DESCRIPTION (FOR FINISH CODE SEE A11.01)
1	CIP CONC COLUMN OR BEAM, SSD
2	CIP CONC WALL, SSD
3	PT CIP CONC FLOOR, SSD
22	CIP BAS-RELIEF MEDALLION (TYPE 3)
26	RAIL : TENSIONED CABLES, SSD
30	LIGHT FIXTURE, SED TO MATCH PTD 4
31	LIGHT FIXTURE POLE, SED TO MATCH PTD 4
32	SIGN : CLEARANCE WARNING PIPE, SEE AG-502
33	PHOTOVOLTAIC PANELS ON SHADE STRUCTURE

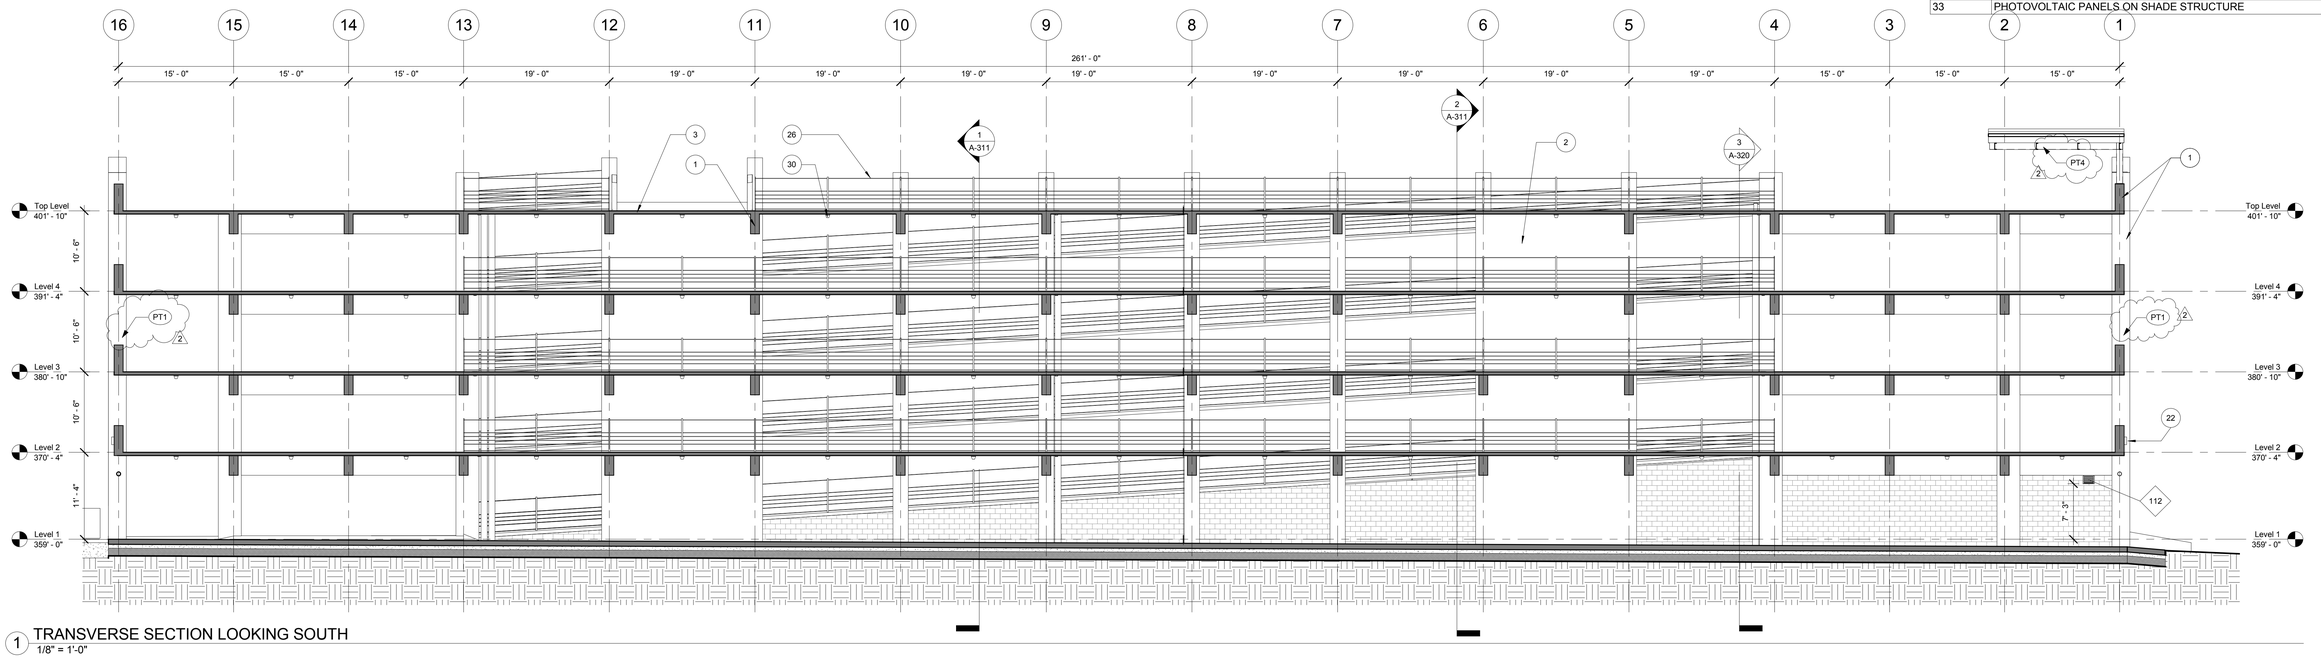

1 TRANSVERSE SECTION LOOKING SOUTH
1/8" = 1'-0"

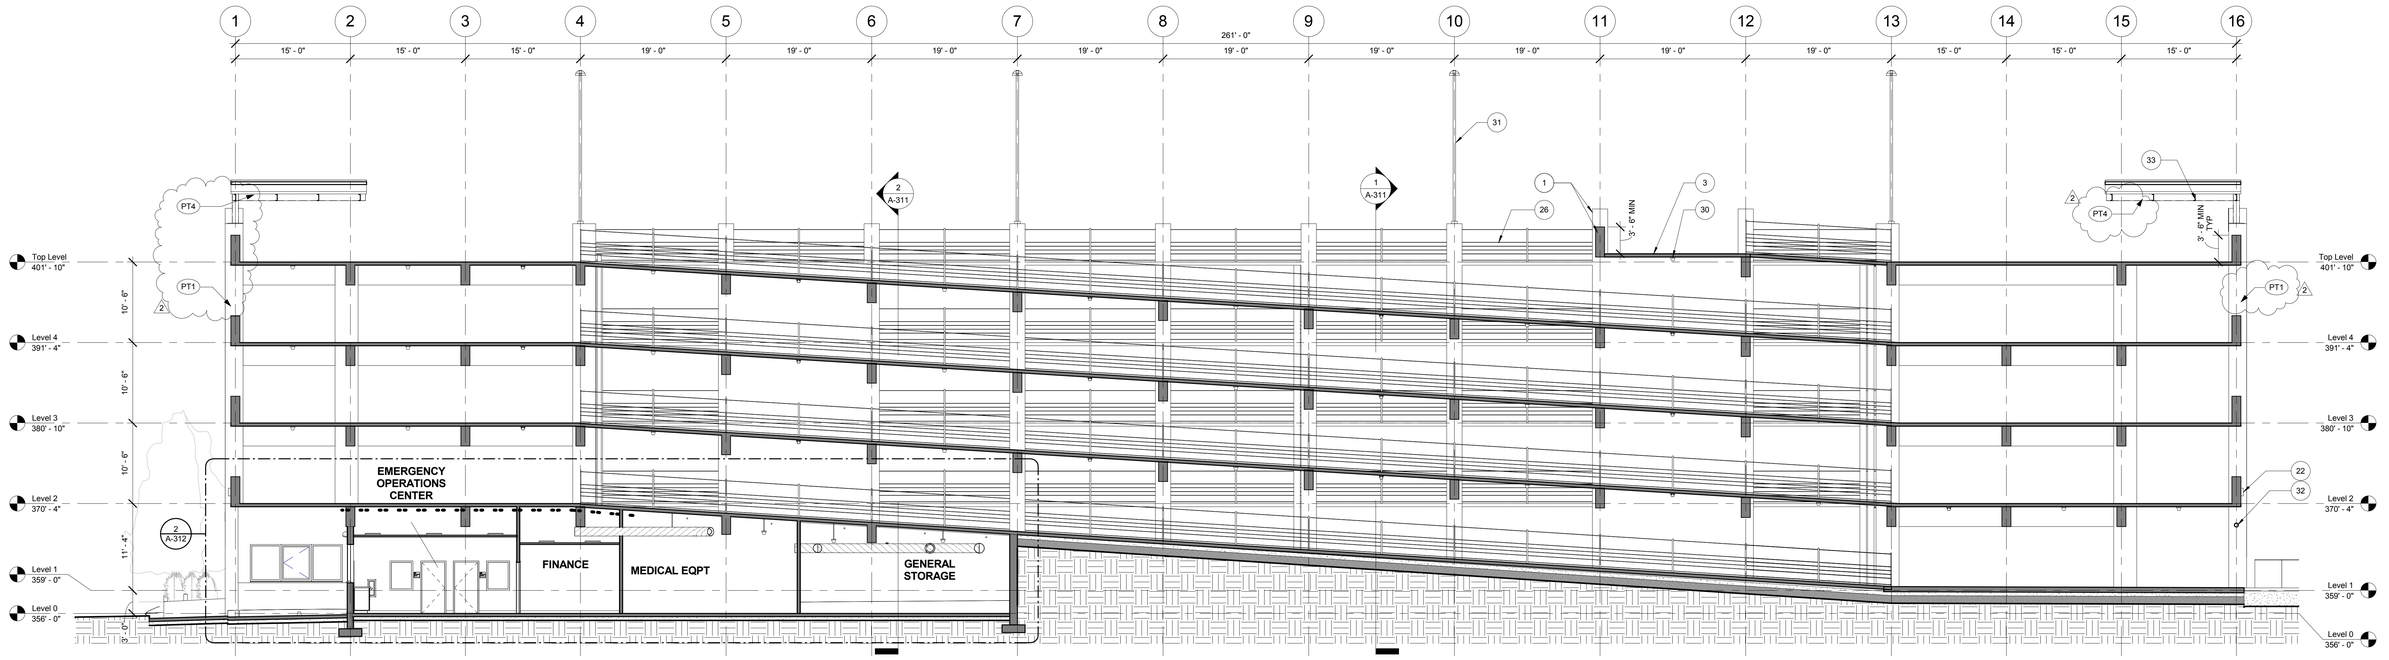

2 TRANSVERSE SECTION LOOKING NORTH
1/8" = 1'-0"

Revisions:	Date
2 Amendment 2	1.22.13

CONSULTANTS:

BSA ARCHITECTS
BULL STOCKWELL ALLEN
ARCHITECTURE + PLANNING
501 Folsom Street 4th Floor
San Francisco CA 94105
415.281.4720
www.bsaarchitects.com

LICENSED ARCHITECT ROBERT E. ALLEN No. C5304 REN. 11-30-11 STATE OF CALIFORNIA

KEY PLAN

ARCHITECT:

WALKER
PARKING CONSULTANTS
135 Main Street
Suite 1030
San Francisco, CA 94105
415.644.0630 Ph
415.644.0637 Fax

Drawing Title: **BUILDING SECTIONS**

Approved: Project Director
Medical Center Director: LAWRENCE H. CARROLL
Chief Engineer: DIRK MINNEMA

Project Title: **PARKING AND EMERGENCY RESPONSE STRUCTURE**

Location: **SFVA MEDICAL CENTER**

Date: 4/28/11 | Checked: MP@BSA | Drawn: JDW@BSA

Project Number: 662-611
Building Number: 211
Drawing Number: **A-310**
Sht -33- of 120

Office of Construction and Facilities Management
Department of Veterans Affairs

VA FORM 08-6231, OCT. 1978