



one eighth inch = one foot
one quarter inch = one foot
three eighths inch = one foot
one half inch = one foot
three quarters inch = one foot
one inch = one foot
one and one half inches = one foot
two inches = one foot
three inches = one foot

1 2 3 4 5 6 7 8 9

1
2
3
4
5
6
7
8
9

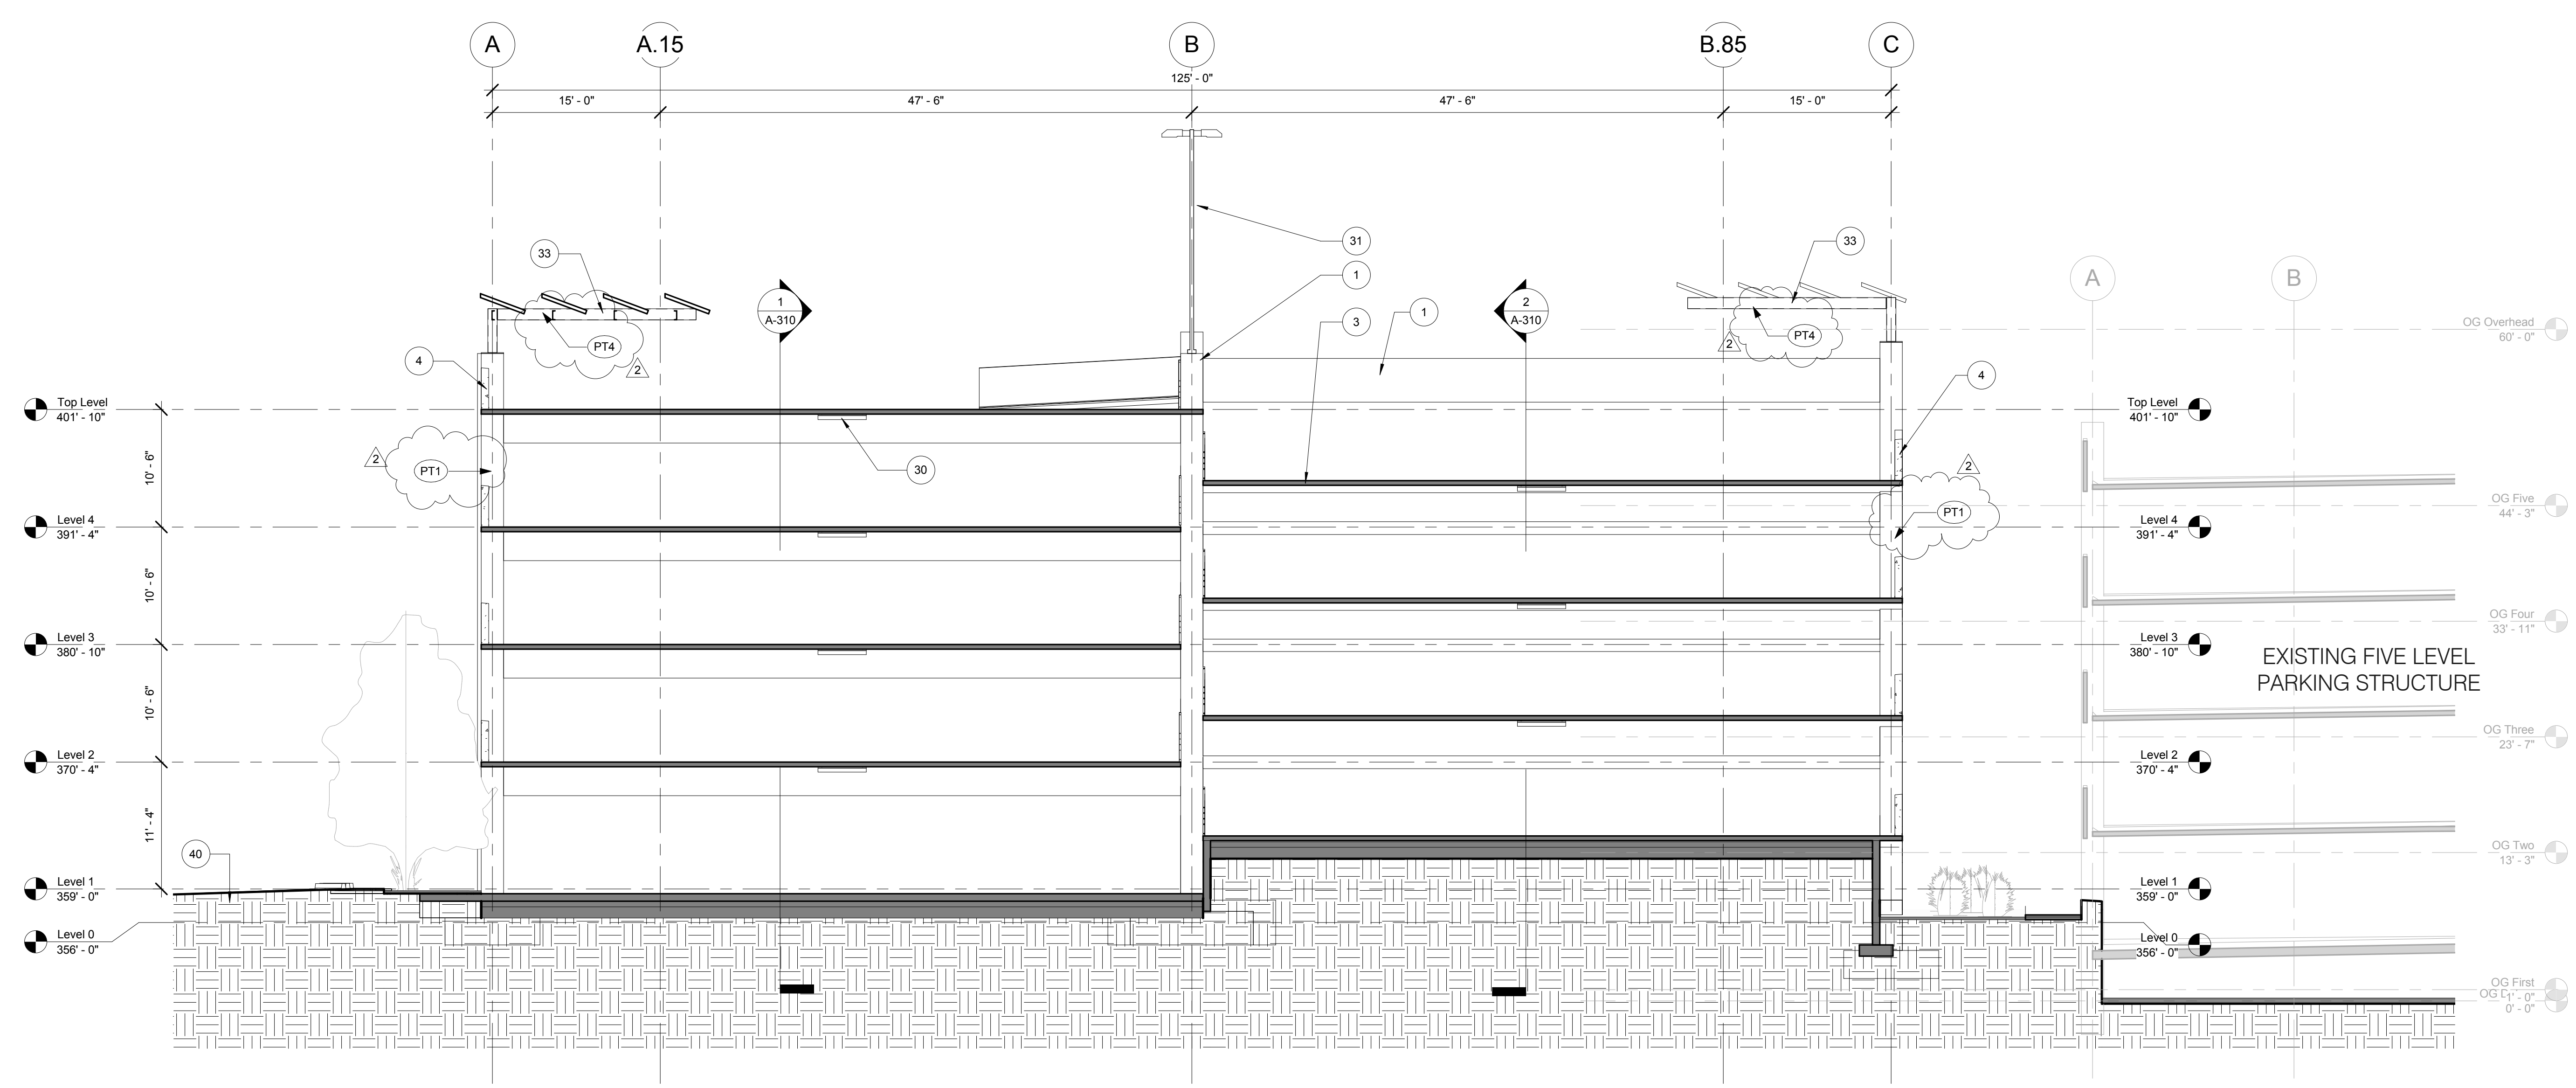

1 CROSS SECTION LOOKING EAST
1/8" = 1'-0"

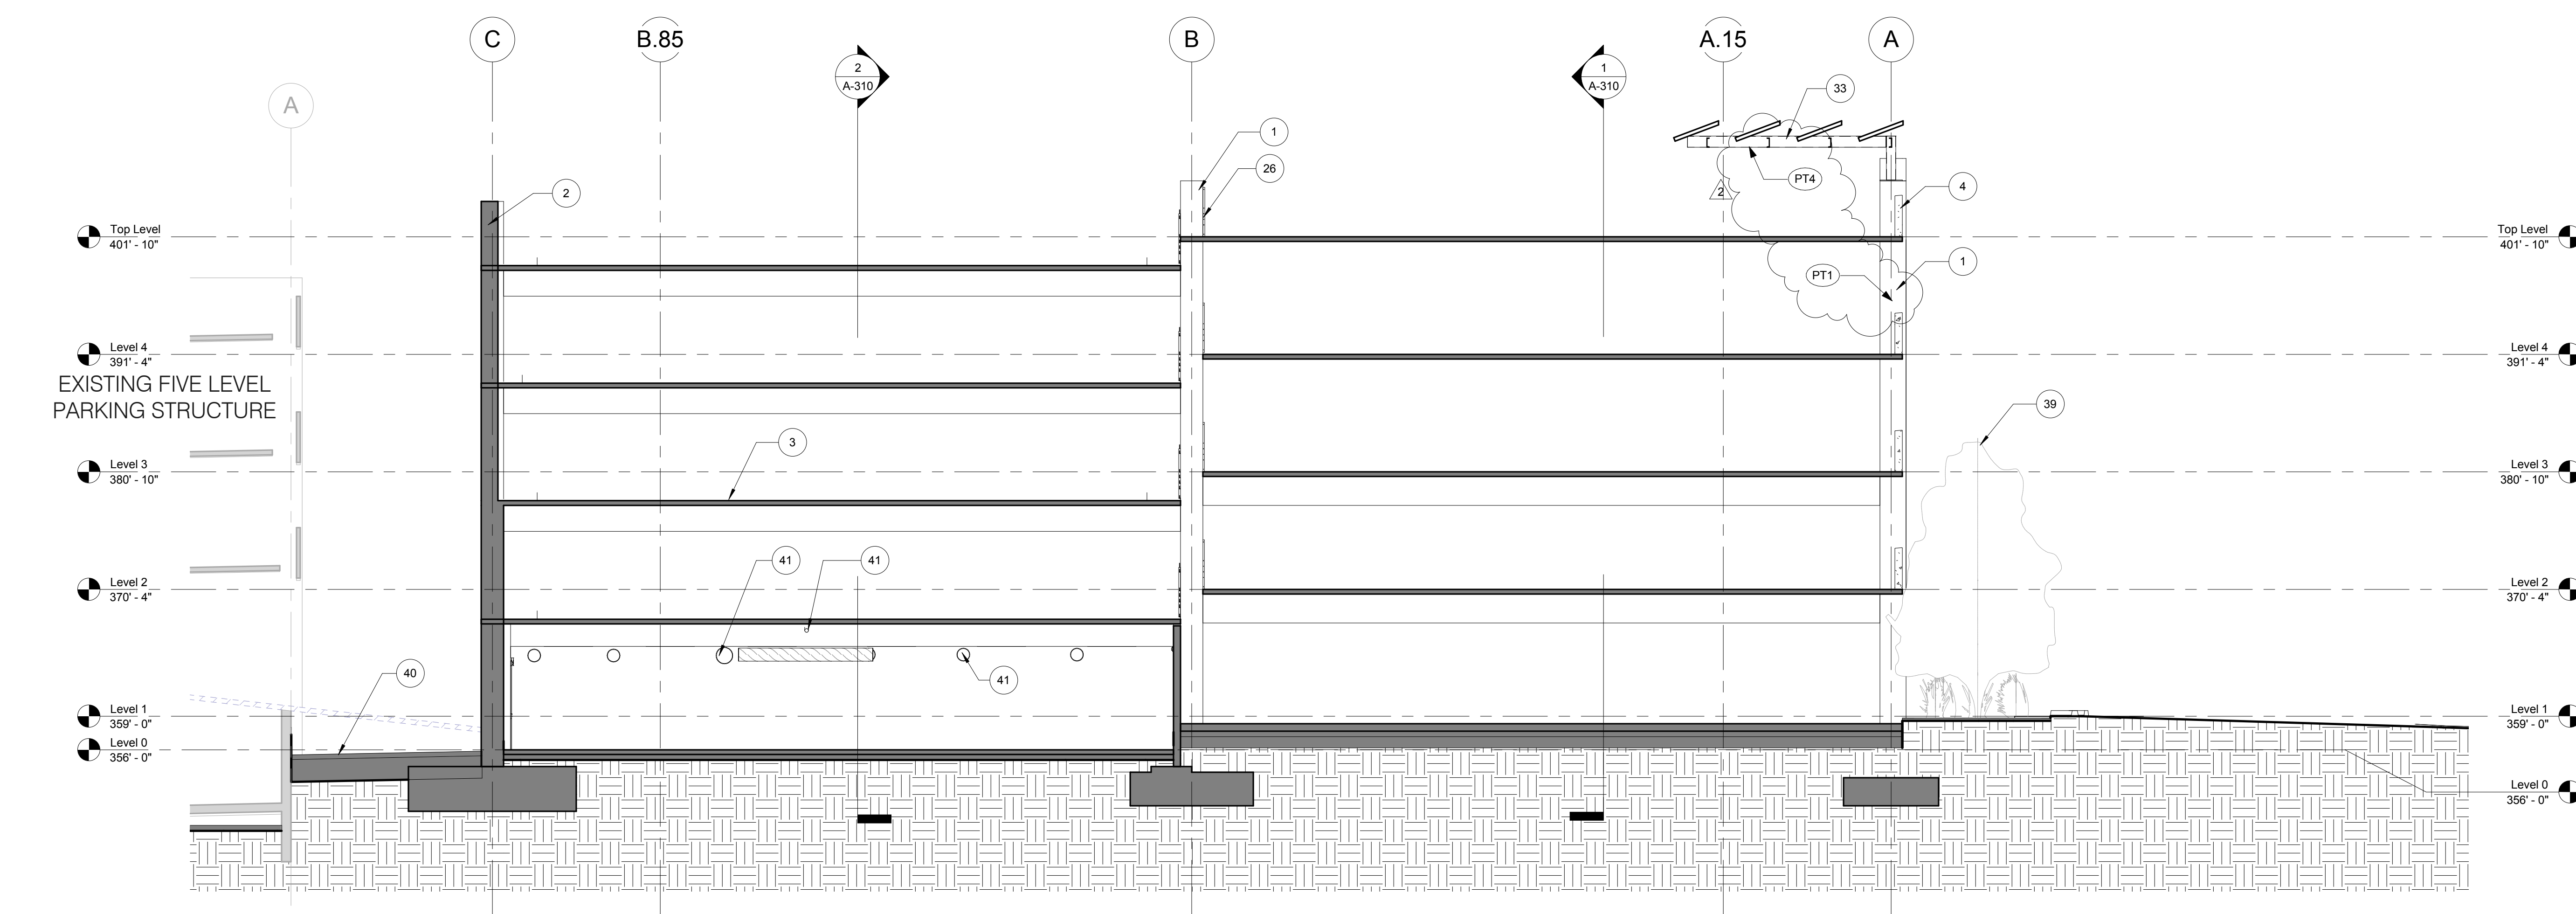

2 CROSS SECTION LOOKING WEST
1/8" = 1'-0"

KEYED NOTES	
NOTE #	DESCRIPTION (FOR FINISH CODE SEE A11.01)
1	CIP CONC COLUMN OR BEAM, SSD
2	CIP CONC WALL, SSD
3	PT CIP CONC FLOOR, SSD
4	CIP CONC CRASH WALL
26	RAIL - TENSIONED CABLES, SSD
30	LIGHT FIXTURE, SED TO MATCH PTD 4
31	LIGHT FIXTURE POLE, SED TO MATCH PTD 4
33	PHOTOVOLTAIC PANELS ON SHADE STRUCTURE
39	PLANTING AREA OR PLANTING, SLD
40	FINISH SURFACE / GRADE, SCD
41	MECHANICAL EQUIPMENT, SMD

CONSULTANTS: BSA ARCHITECTS BULL STOCKWELL ALLEN ARCHITECTURE + PLANNING 501 Folsom Street 4th Floor San Francisco CA 94105 415.281.4720 www.bsaarchitects.com		ARCHITECT: WALKER PARKING CONSULTANTS 135 Main Street Suite 1030 San Francisco, CA 94105 415.644.0630 Ph 415.644.0637 Fax		Office of Construction and Facilities Management Department of Veterans Affairs	
Revisions: 2 Amendment 2 1.22.13 Date		KEY PLAN		PROJECT INFORMATION Project Title: PARKING AND EMERGENCY RESPONSE STRUCTURE Building Number: 211 Location: SFVA MEDICAL CENTER Date: 4/28/11 Checked: MP@BSA Drawn: JDW@BSA Drawing Number: A-311 Sht -34- of 120	
CONSULTANTS:		ARCHITECT:		PROJECT INFORMATION	
BSA ARCHITECTS		WALKER		PARKING AND EMERGENCY RESPONSE STRUCTURE	
BULL STOCKWELL ALLEN		PARKING CONSULTANTS		Building Number	
ARCHITECTURE + PLANNING		135 Main Street		211	
501 Folsom Street 4th Floor		Suite 1030		Location	
San Francisco CA 94105		San Francisco, CA 94105		SFVA MEDICAL CENTER	
415.281.4720		415.644.0630 Ph		Date	
www.bsaarchitects.com		415.644.0637 Fax		4/28/11	
