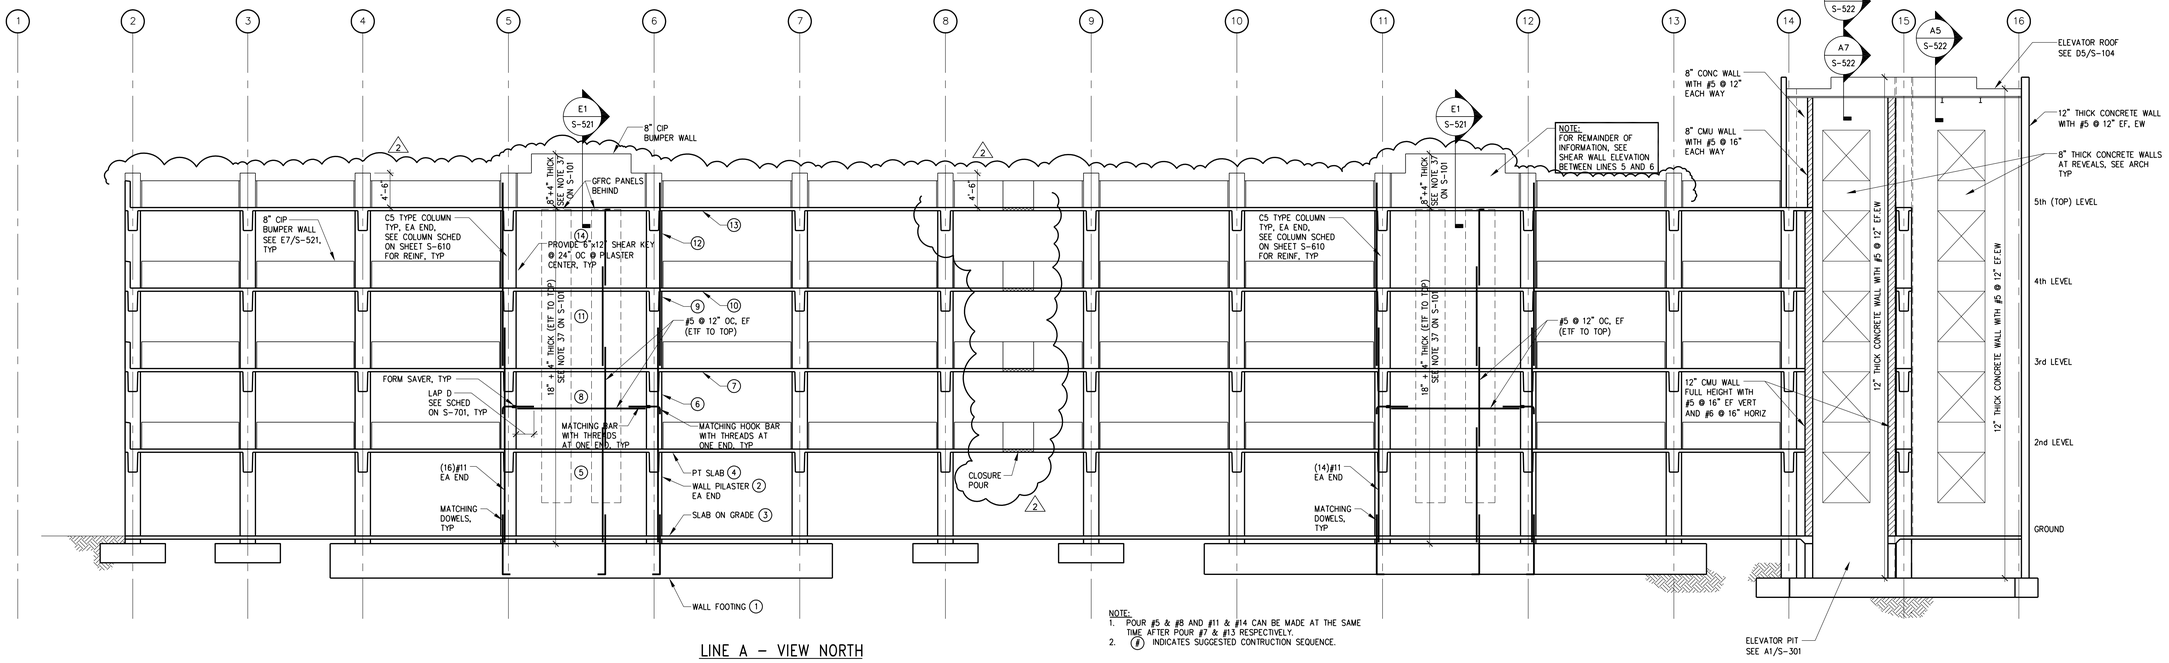

NOTE:
1. POUR #5 & #8 AND #11 & #14 CAN BE MADE AT THE SAME TIME AFTER POUR #7 & #13 RESPECTIVELY.
2. (#) INDICATES SUGGESTED CONTRUCTION SEQUENCE.

LINE A – VIEW NORTH

D3 SHEAR WALL ELEVATION

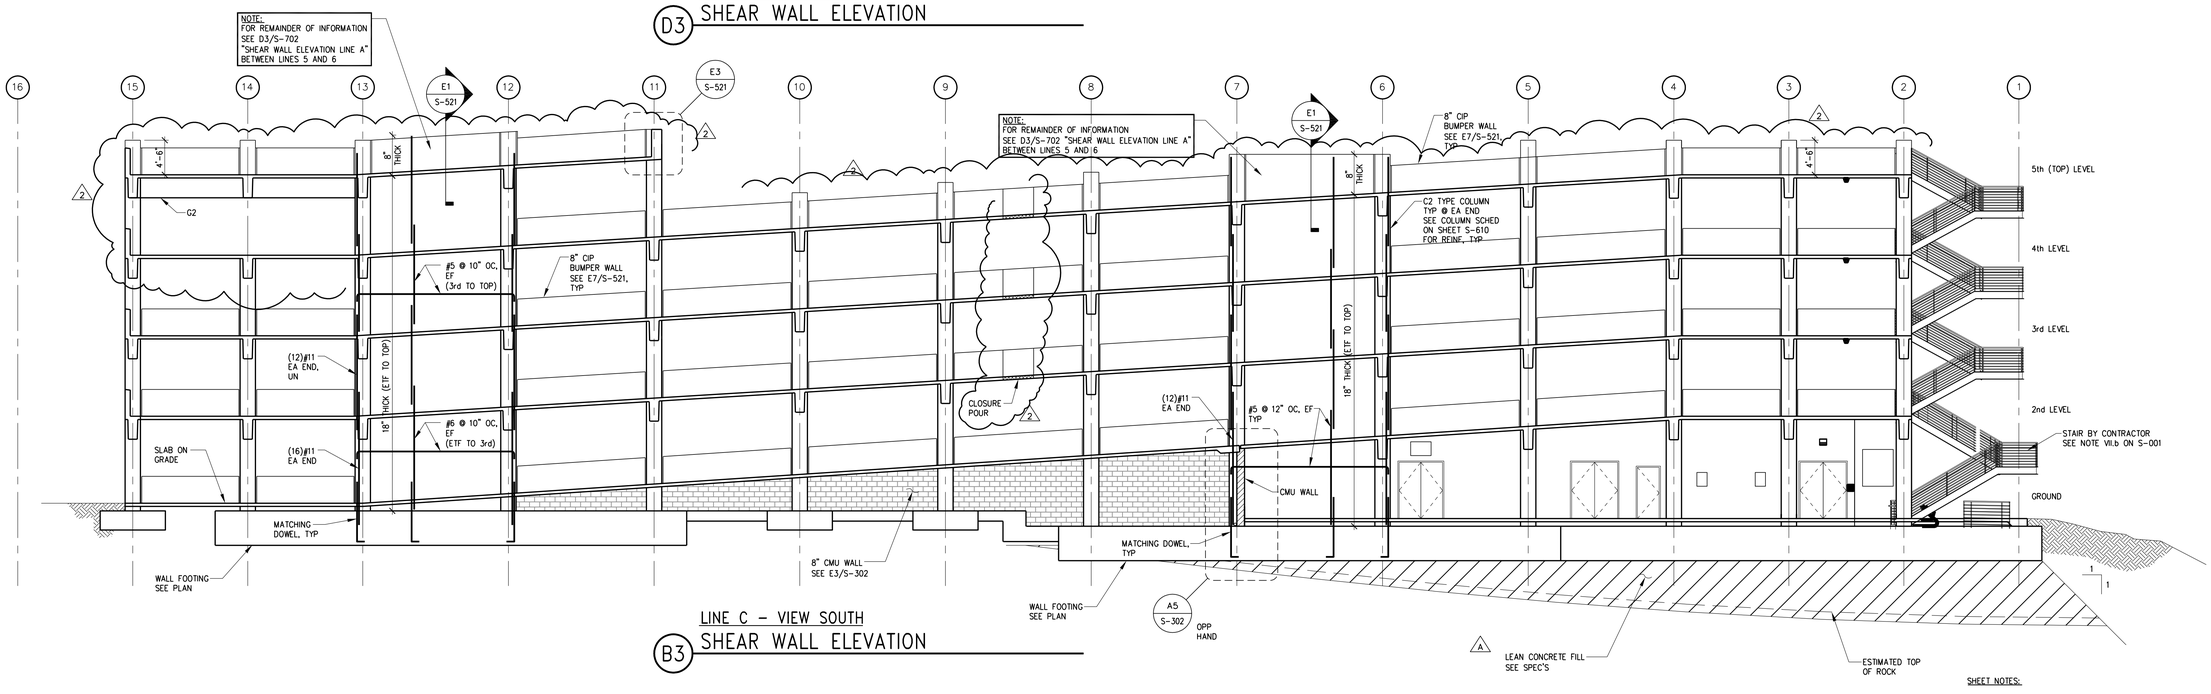

LINE C – VIEW SOUTH

B3 SHEAR WALL ELEVATION

SHEET NOTES:

1. SEE SHEET S-001 FOR GENERAL NOTES.
2. VERIFY ALL DIMENSIONS WITH ARCHITECTURAL DRAWINGS.
3. FOR REINFORCING LAP SPLICES, EMBEDMENT LENGTHS, HOOKS, DETAILS, ETC, SEE THE TYPICAL SHEAR WALL DETAILS AND REINFORCING SCHEDULE ON SHEET S-701.
4. REINFORCING AT WALL INTERSECTIONS SHALL BE PER A6/S-002.
5. REINFORCING AROUND WALL OPENINGS SHALL BE PER A4/S-002.
6. CONTINUE BEAM TOP AND BOTTOM LONGITUDINAL REINFORCING CONTINUOUS THROUGH WALLS, TYPICAL AT ALL LEVELS. BEAM STIRRUPS SHALL START 2" FROM FACE OF WALL. SEE DETAILS A2/S-701 AND C2/S-701.
7. ALL TIES IN THE END OF WALL REINFORCING ARE #4 AT 4" ON CENTER, UNLESS NOTED.

A

AMENDMENT 2	01/22/13
Revisions:	Date

CONSULTANTS:

KEY PLAN

ARCHITECT/ENGINEERS:

WALKER
PARKING CONSULTANTS
135 Main Street
Suite 1030
San Francisco, CA 94105
415.644.0630 Ph
415.644.0637 Fax

REGISTERED PROFESSIONAL ENGINEER KENNETH E. NAYFOR No. 2669 Exp. 3/2008 STRUCTURAL STATE OF CALIFORNIA

Drawing Title: **SHEAR WALL ELEVATIONS**

Approved Project Director
Medical Center Director: LAWRENCE H. CARROLL
Chief Engineer: DIRK MINNEMA

Project Title: PARKING AND EMERGENCY RESPONSE STRUCTURE

Location: SFVA MEDICAL CENTER

Date: OCTOBER 2012 | Checked | Drawn

Project Number: 662-611
Building Number: 211
Drawing Number: **S-702**
Sht. 84 of 120

Office of Construction and Facilities Management
Department of Veterans Affairs

VA FORM 08-6231