




three inches = one foot
one and one half inches = one foot
one inch = one foot
three quarters inch = one foot
one half inch = one foot
three eighths inch = one foot
one quarter inch = one foot
one eighth inch = one foot

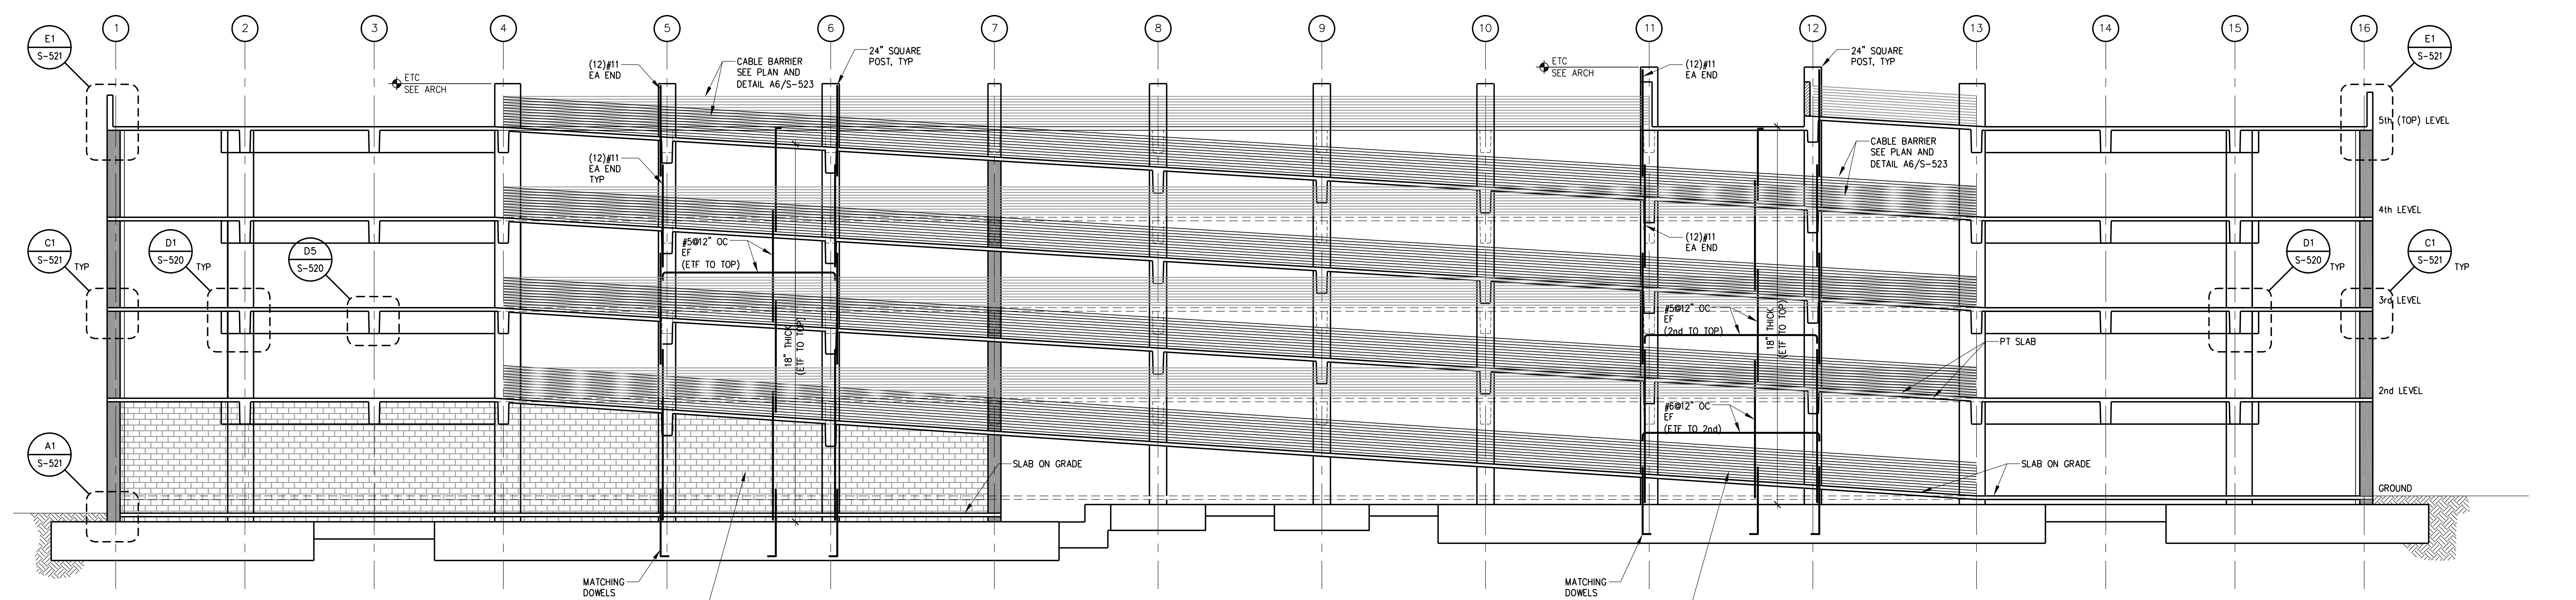

LINE B - VIEW NORTH
D3 SHEAR WALL ELEVATION

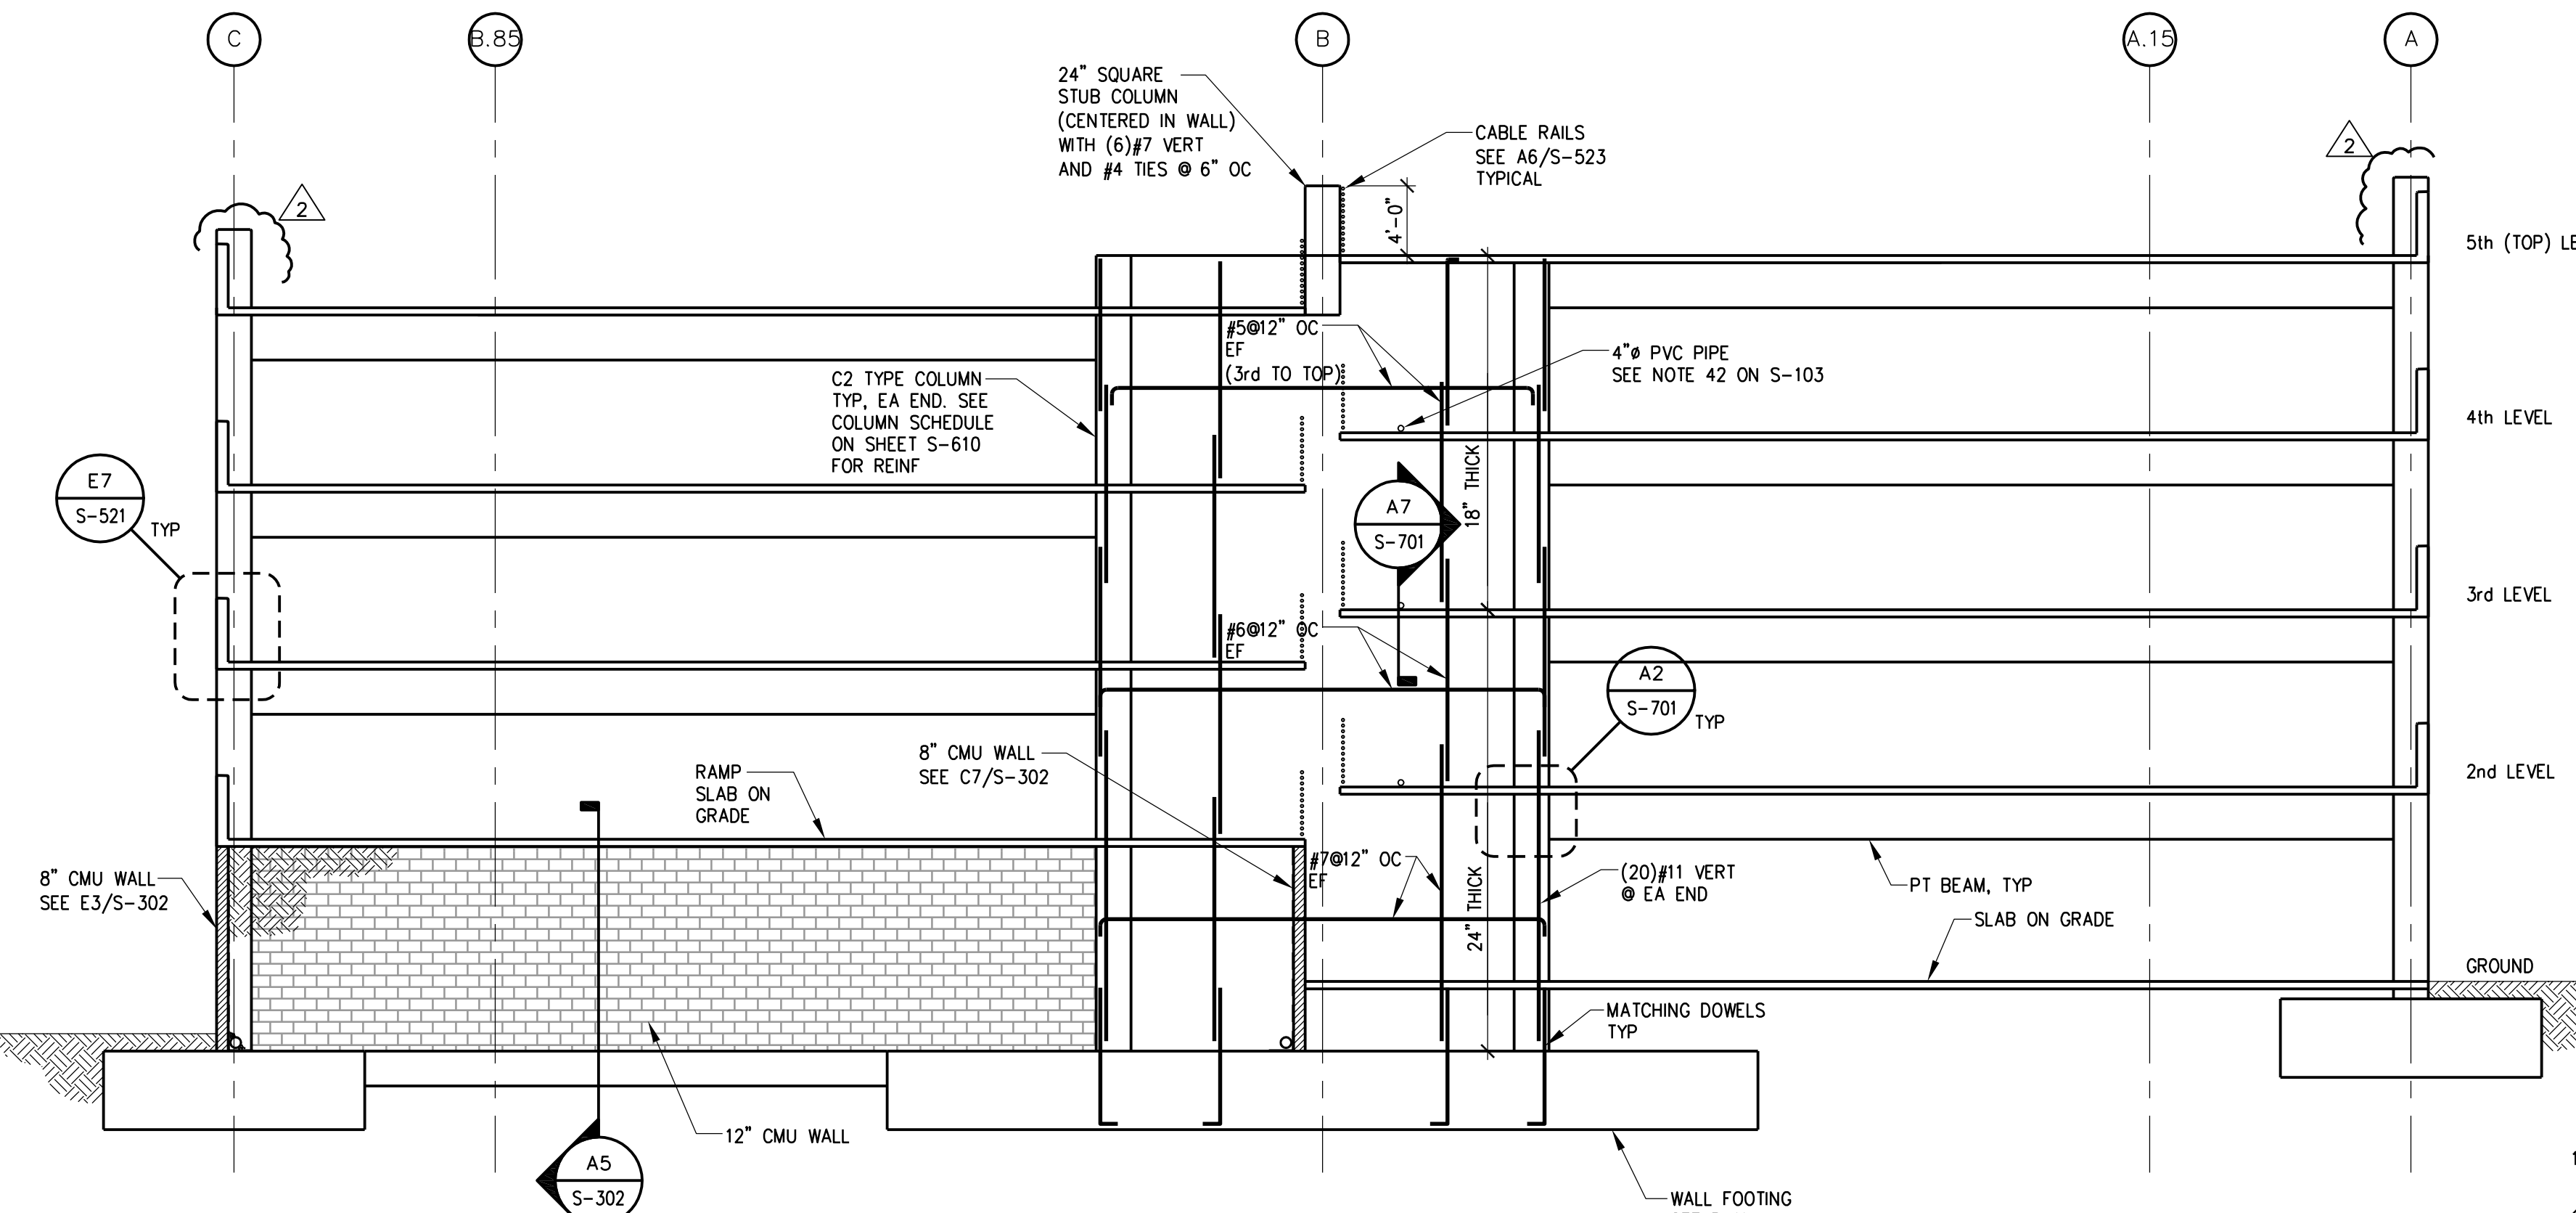

LINE 7 - VIEW WEST
A2 SHEAR WALL ELEVATION

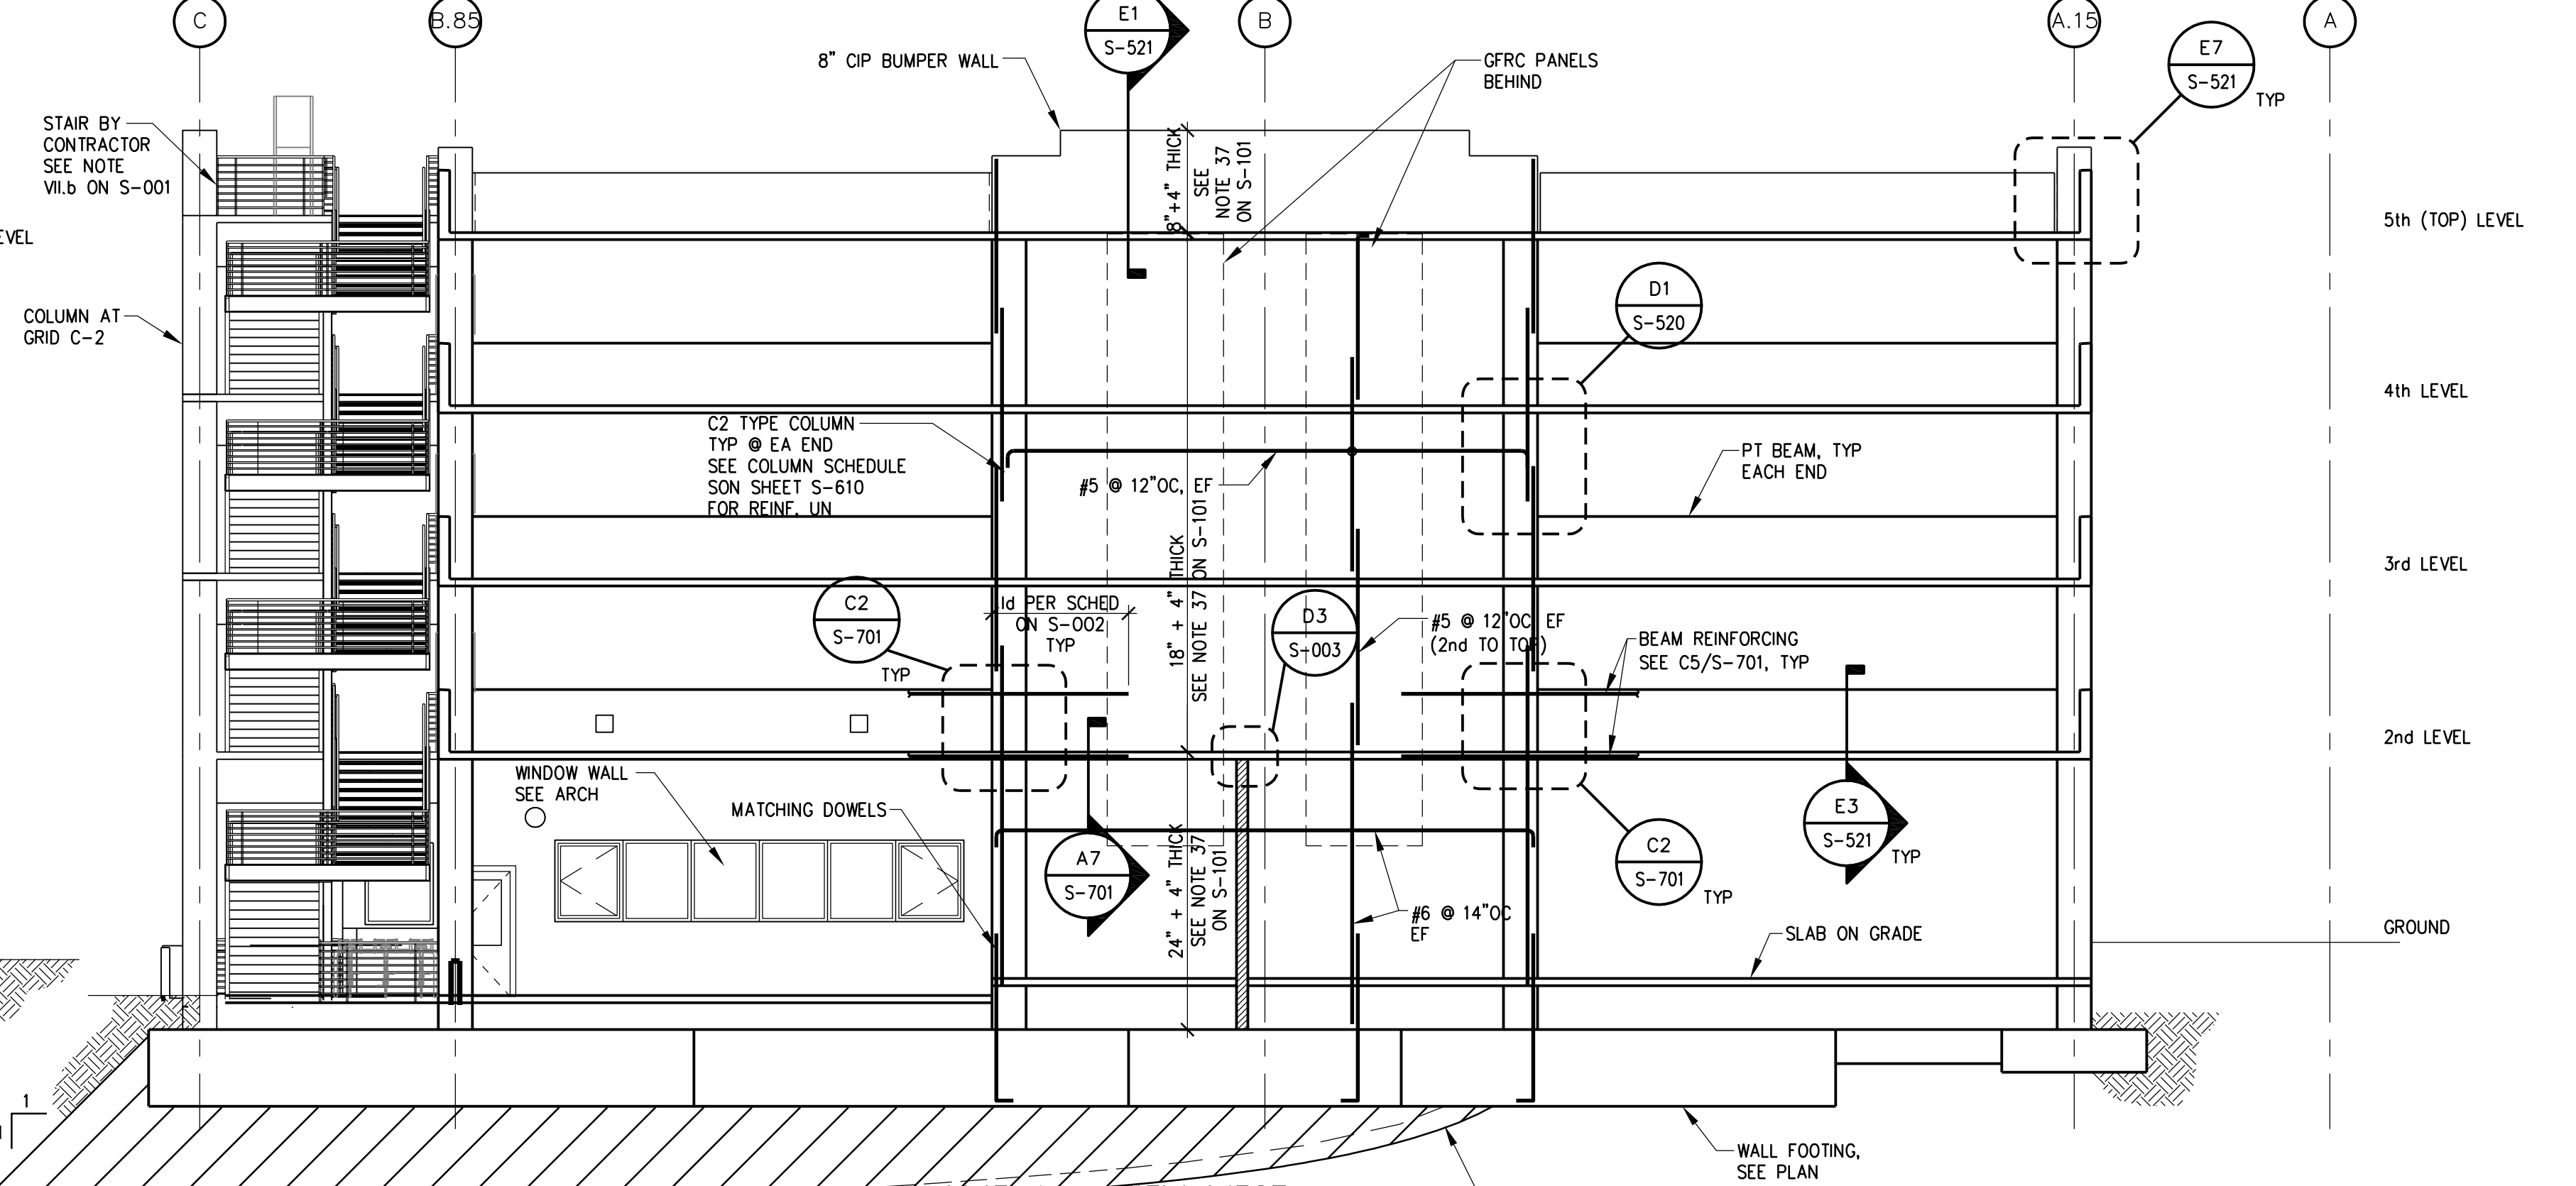


LINE 1 - VIEW WEST
A6 SHEAR WALL ELEVATION


- SHEET NOTES:
1. SEE SHEET S-001 FOR GENERAL NOTES.
 2. VERIFY ALL DIMENSIONS WITH ARCHITECTURAL DRAWINGS.
 3. FOR REINFORCING LAP SPICES, EMBEDMENT LENGTHS, HOOKS, DETAILS, ETC. SEE THE TYPICAL SHEAR WALL DETAILS AND REINFORCING SCHEDULE ON SHEET S-701.
 4. REINFORCING AT WALL INTERSECTIONS SHALL BE PER A6/S-002.
 5. REINFORCING AROUND WALL OPENINGS SHALL BE PER A4/S-002.
 6. CONTINUE BEAM TOP AND BOTTOM LONGITUDINAL REINFORCING CONTINUOUS THROUGH WALLS, TYPICAL AT ALL LEVELS. BEAM STIRRUPS SHALL START 2" FROM FACE OF WALL. SEE DETAILS A2/S-701 AND C2/S-701.
 7. ALL TIES IN THE END OF WALL REINFORCING ARE #4 AT 4" ON CENTER, UNLESS NOTED.

| | |
|-------------|----------|
| AMENDMENT 2 | 01/22/18 |
| Revisions | Date |

CONSULTANTS:

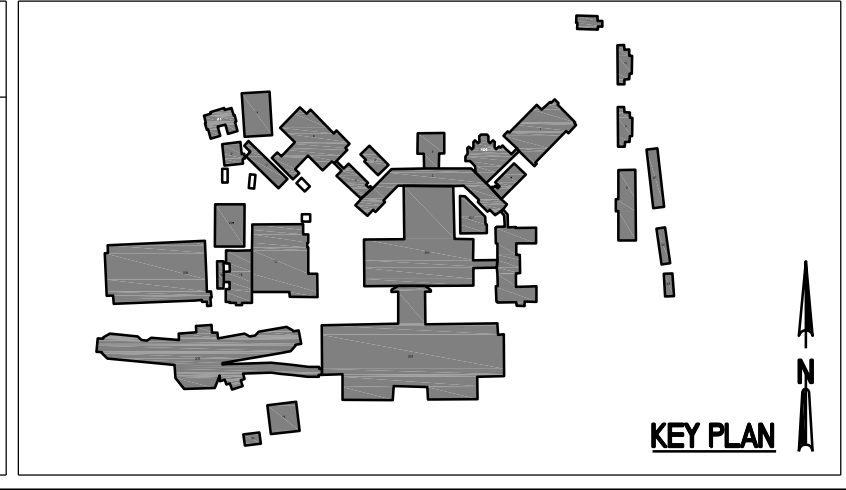

ARCHITECT/ENGINEERS:
WALKER
PARKING CONSULTANTS
135 Main Street
Suite 1030
San Francisco, CA 94105
415.644.0630 Ph
415.644.0637 Fax

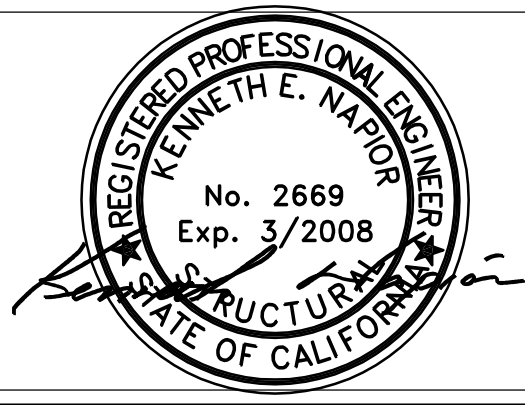

Drawing Title
SHEAR WALL ELEVATIONS
Approved Project Director
Medical Center Director: LAWRENCE H. CARROLL
Chief Engineer: DRK MINEMA

Project Title
PARKING AND EMERGENCY RESPONSE STRUCTURE
Location
SFVA MEDICAL CENTER
Date
OCTOBER 2012

Project Number
662-611
Building Number
211
Drawing Number
S-703
Sht. 85 of 120

Office of
Construction
and Facilities
Management
Department of
Veterans Affairs