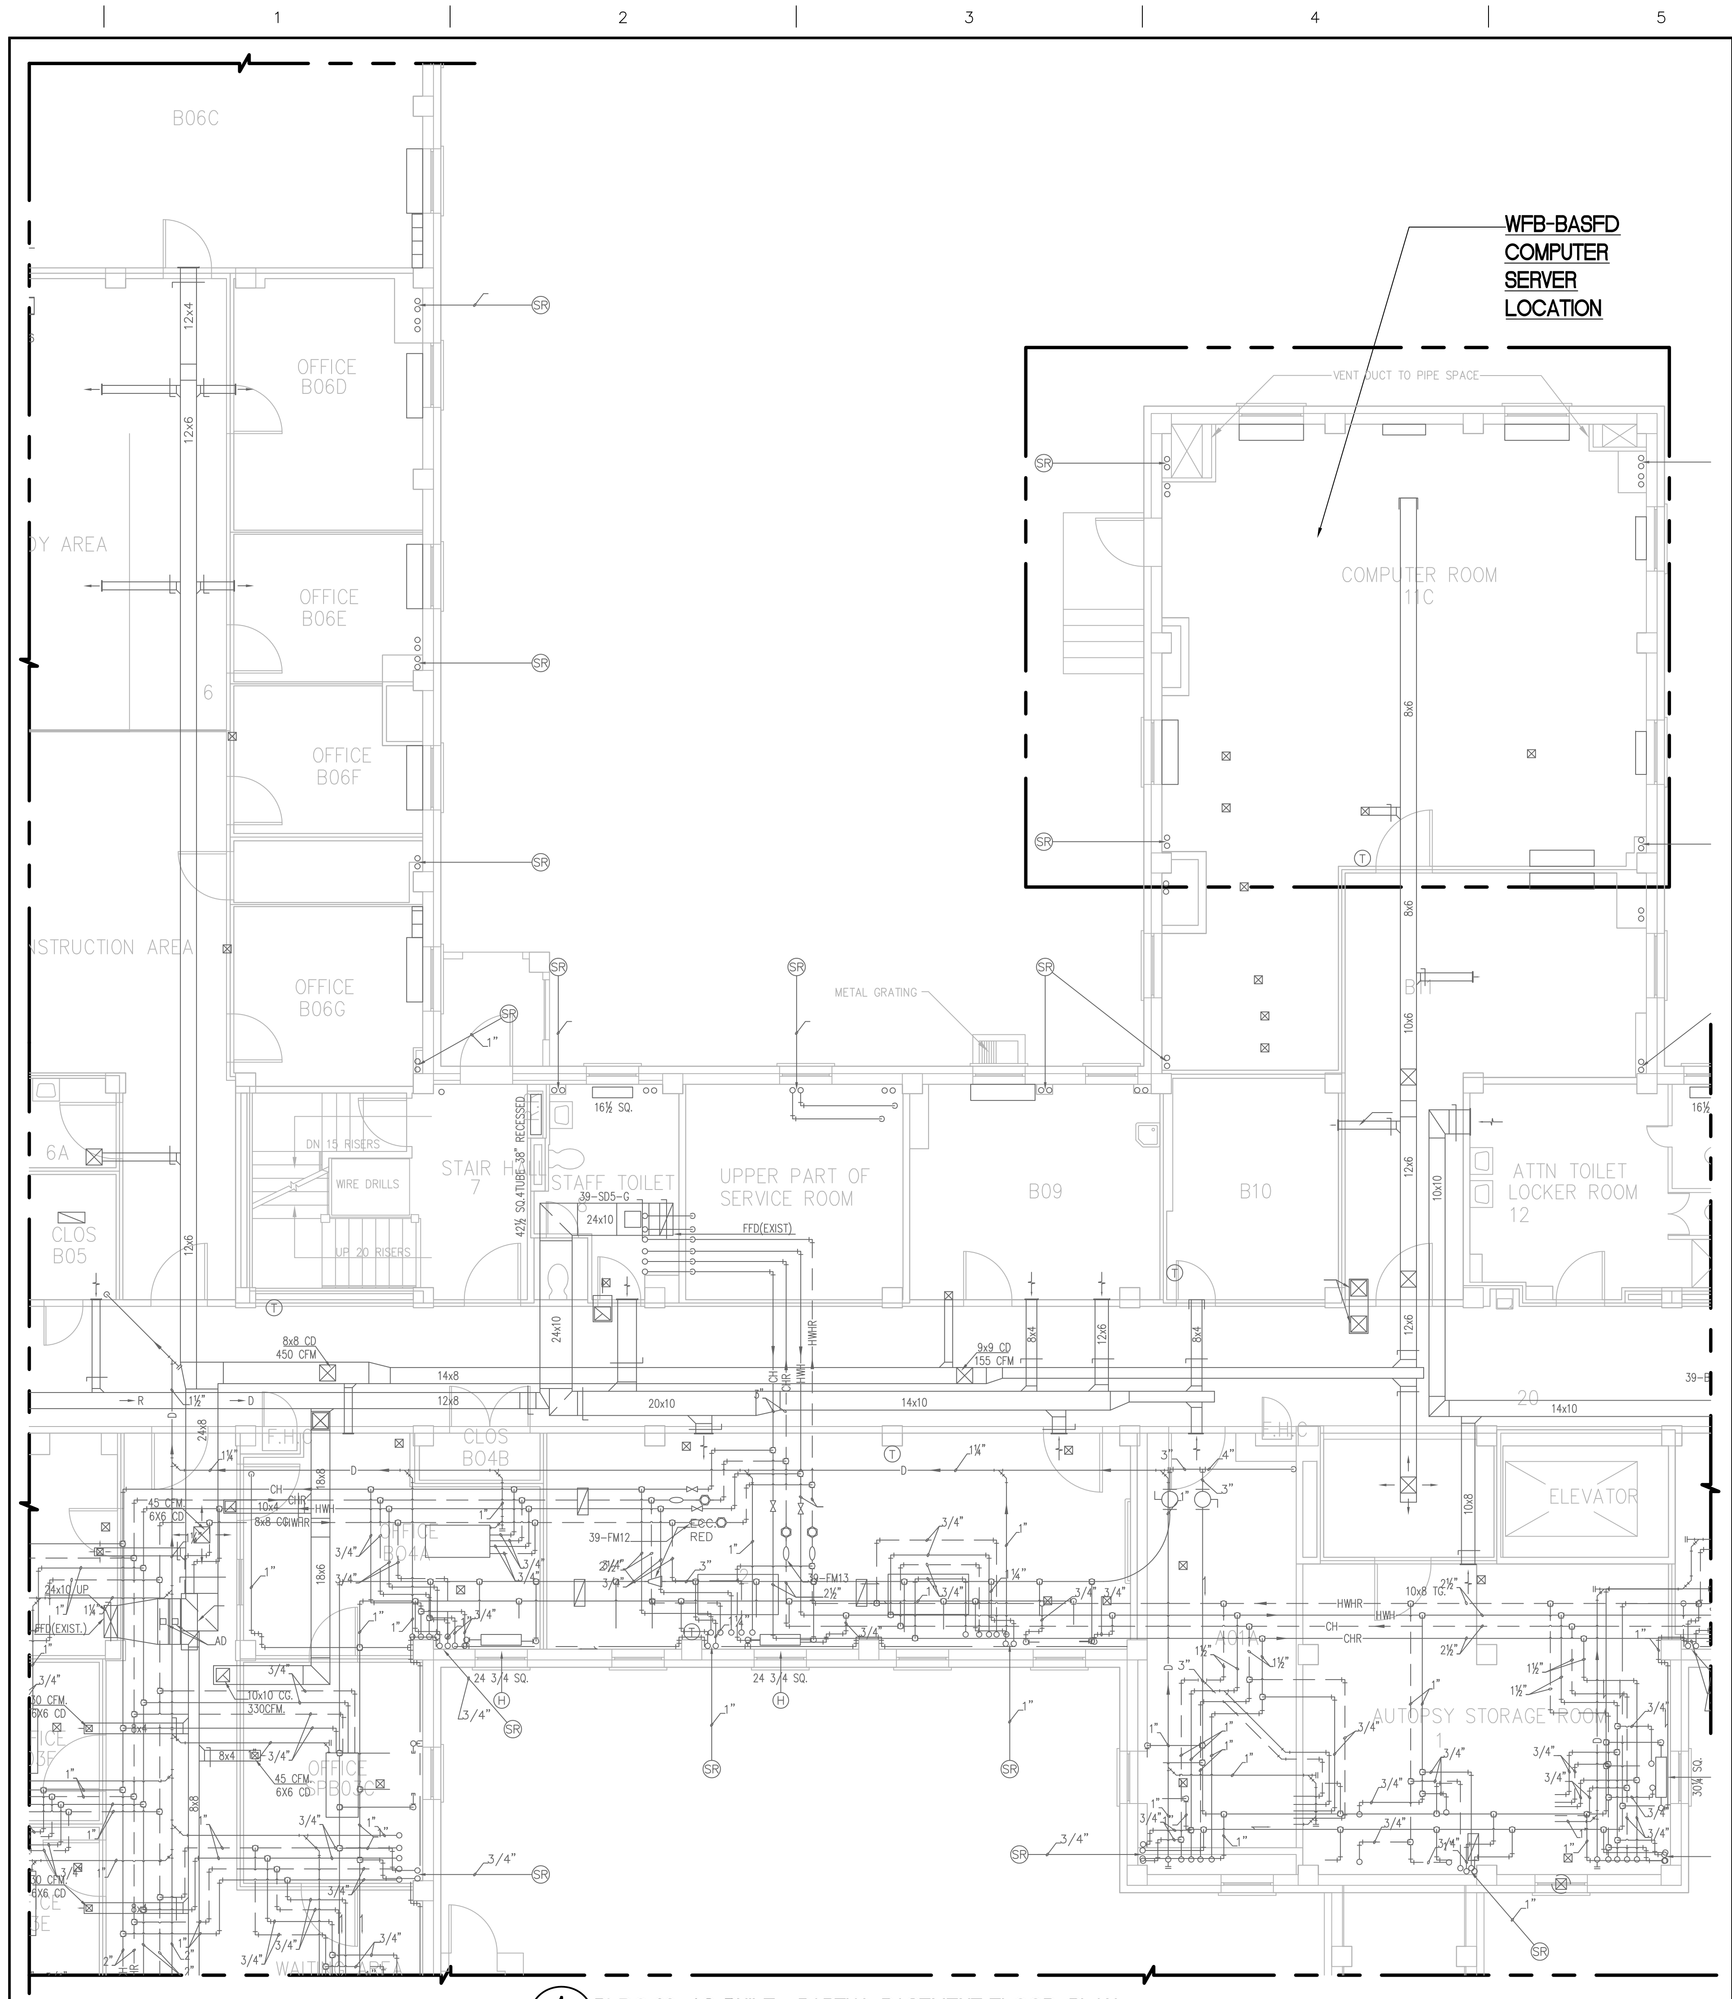


1 M1101 **BLDG 39 AS-BUILT - PARTIAL BASEMENT FLOOR PLAN**

SCALE 3/16"=1'-0"

**LEGENDS:**

- EXISTING CONSTRUCTION
- NEW CONSTRUCTION
- T — TELEPHONE LINE
- IC — INTRANET COMM. LINE
- CAT5 — CAT-5 ETHERNET LINE

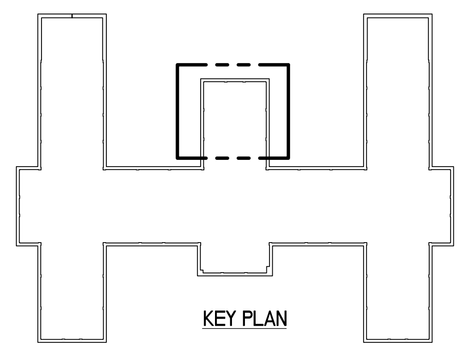

KEY PLAN

ONSTRUCTION DOCUMENTS

| Revisions | Date |
|---|---|
| | |

A/E SEAL

A/E ADDRESS

CHU AND GASSMAN, INC
1526 WALNUT ST., SUITE 625, PHILADELPHIA, PA 19102
T. (215) 356-0912 F. (732) 563-4549
559 UNION AVENUE, MIDDLESEX, NJ 08846
T. (732) 563-4550 F. (732) 563-4549

| | | | |
|---|---|---|---|
| Drawing Title: INSTRUMENTATION BUILDING 39 EQUIPMENT LOCATION MODIFICATIONS | | Project Title: VAMC WEB BASED DIRECT DIGITAL CO | Date: 6/7/2012 |
| | | | Project No.: 542-07-109 |
| Approved: Chief Engineering Service | Drawn: T. CHU | Building Number: 39 | DRAWING No.: 39MI101 |
| Approved: Medical Center Director | Checked: W. KEITH | Location: COATESVILLE, PENNSYLVANIA | Dwg. 11 Of 17 |

VA