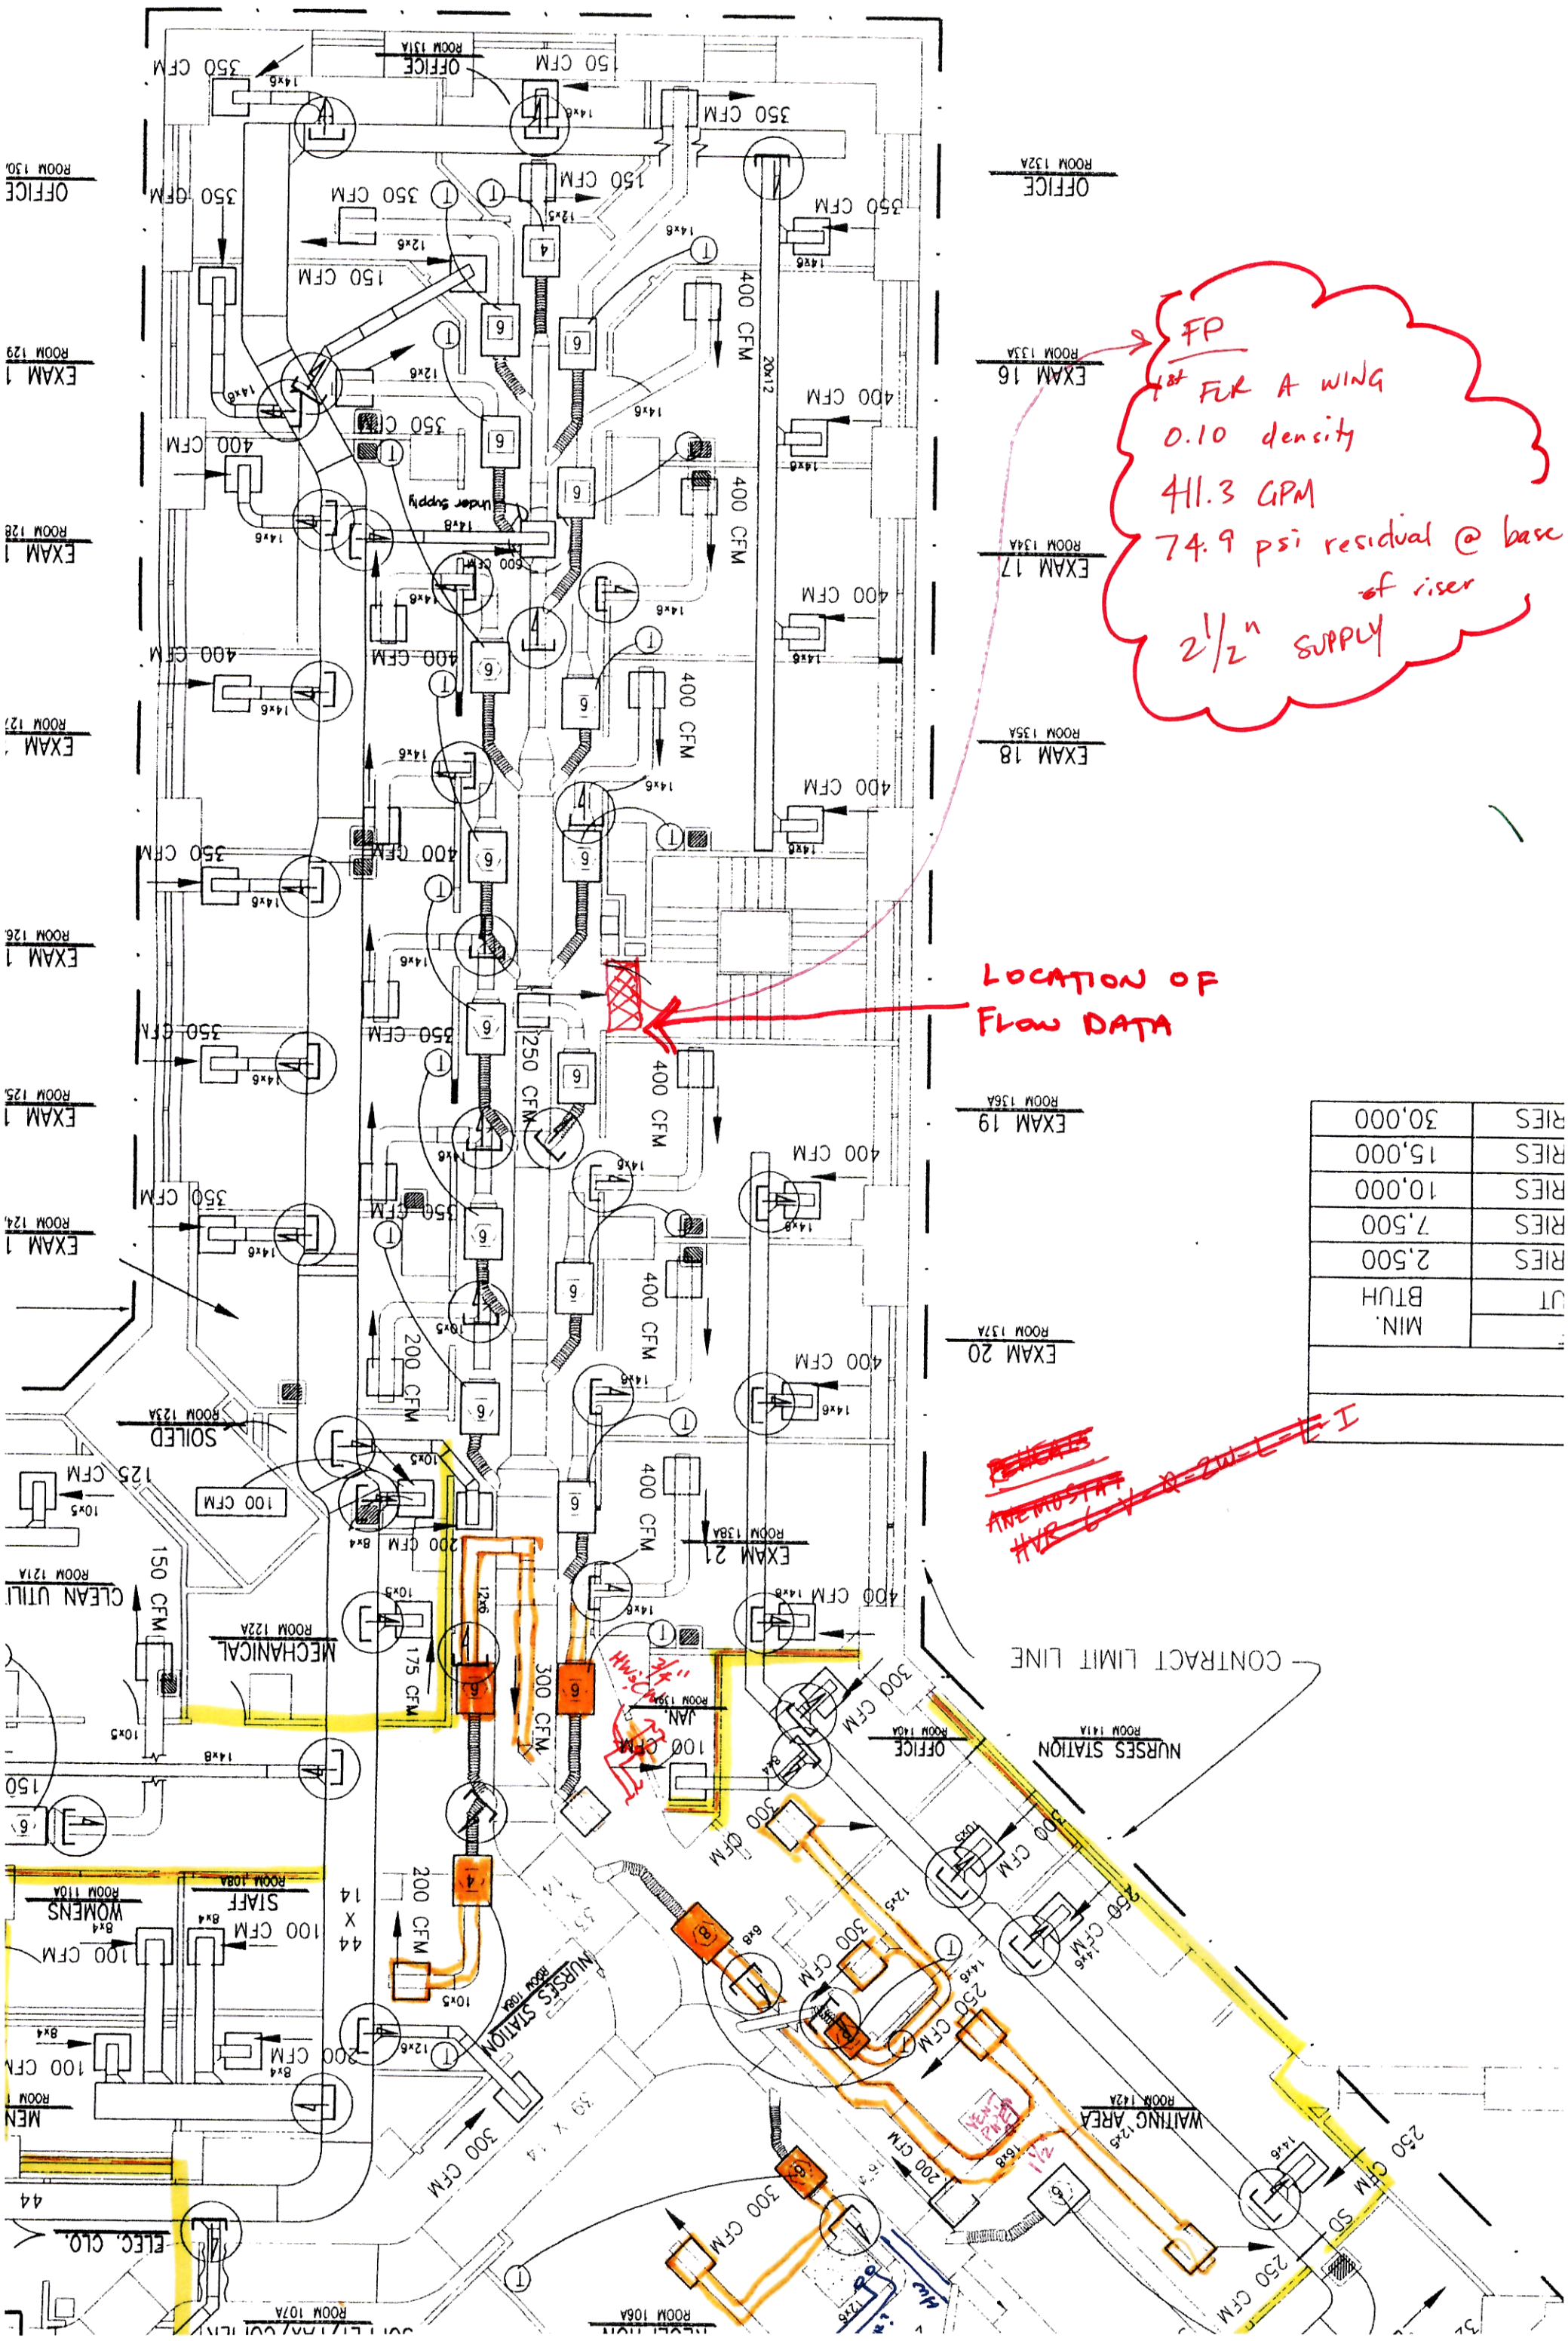
FP
1st FLR A WING
0.10 density
411.3 GPM
74.9 psi residual @ base of riser
2 1/2" SUPPLY
LOCATION OF FLOW DATA
CONTRACT LIMIT LINE
EXAM 16
EXAM 17
EXAM 18
EXAM 19
EXAM 20
EXAM 21
OFFICE
NURSES STATION
WAITING AREA
MECHANICAL
SOILED
CLEAN UTIL.
ELEC. CLO.
MEN
WOMENS
STAFF
JAN.
MIN. BTUH
RIES 2,500
RIES 7,500
RIES 10,000
RIES 15,000
RIES 30,000