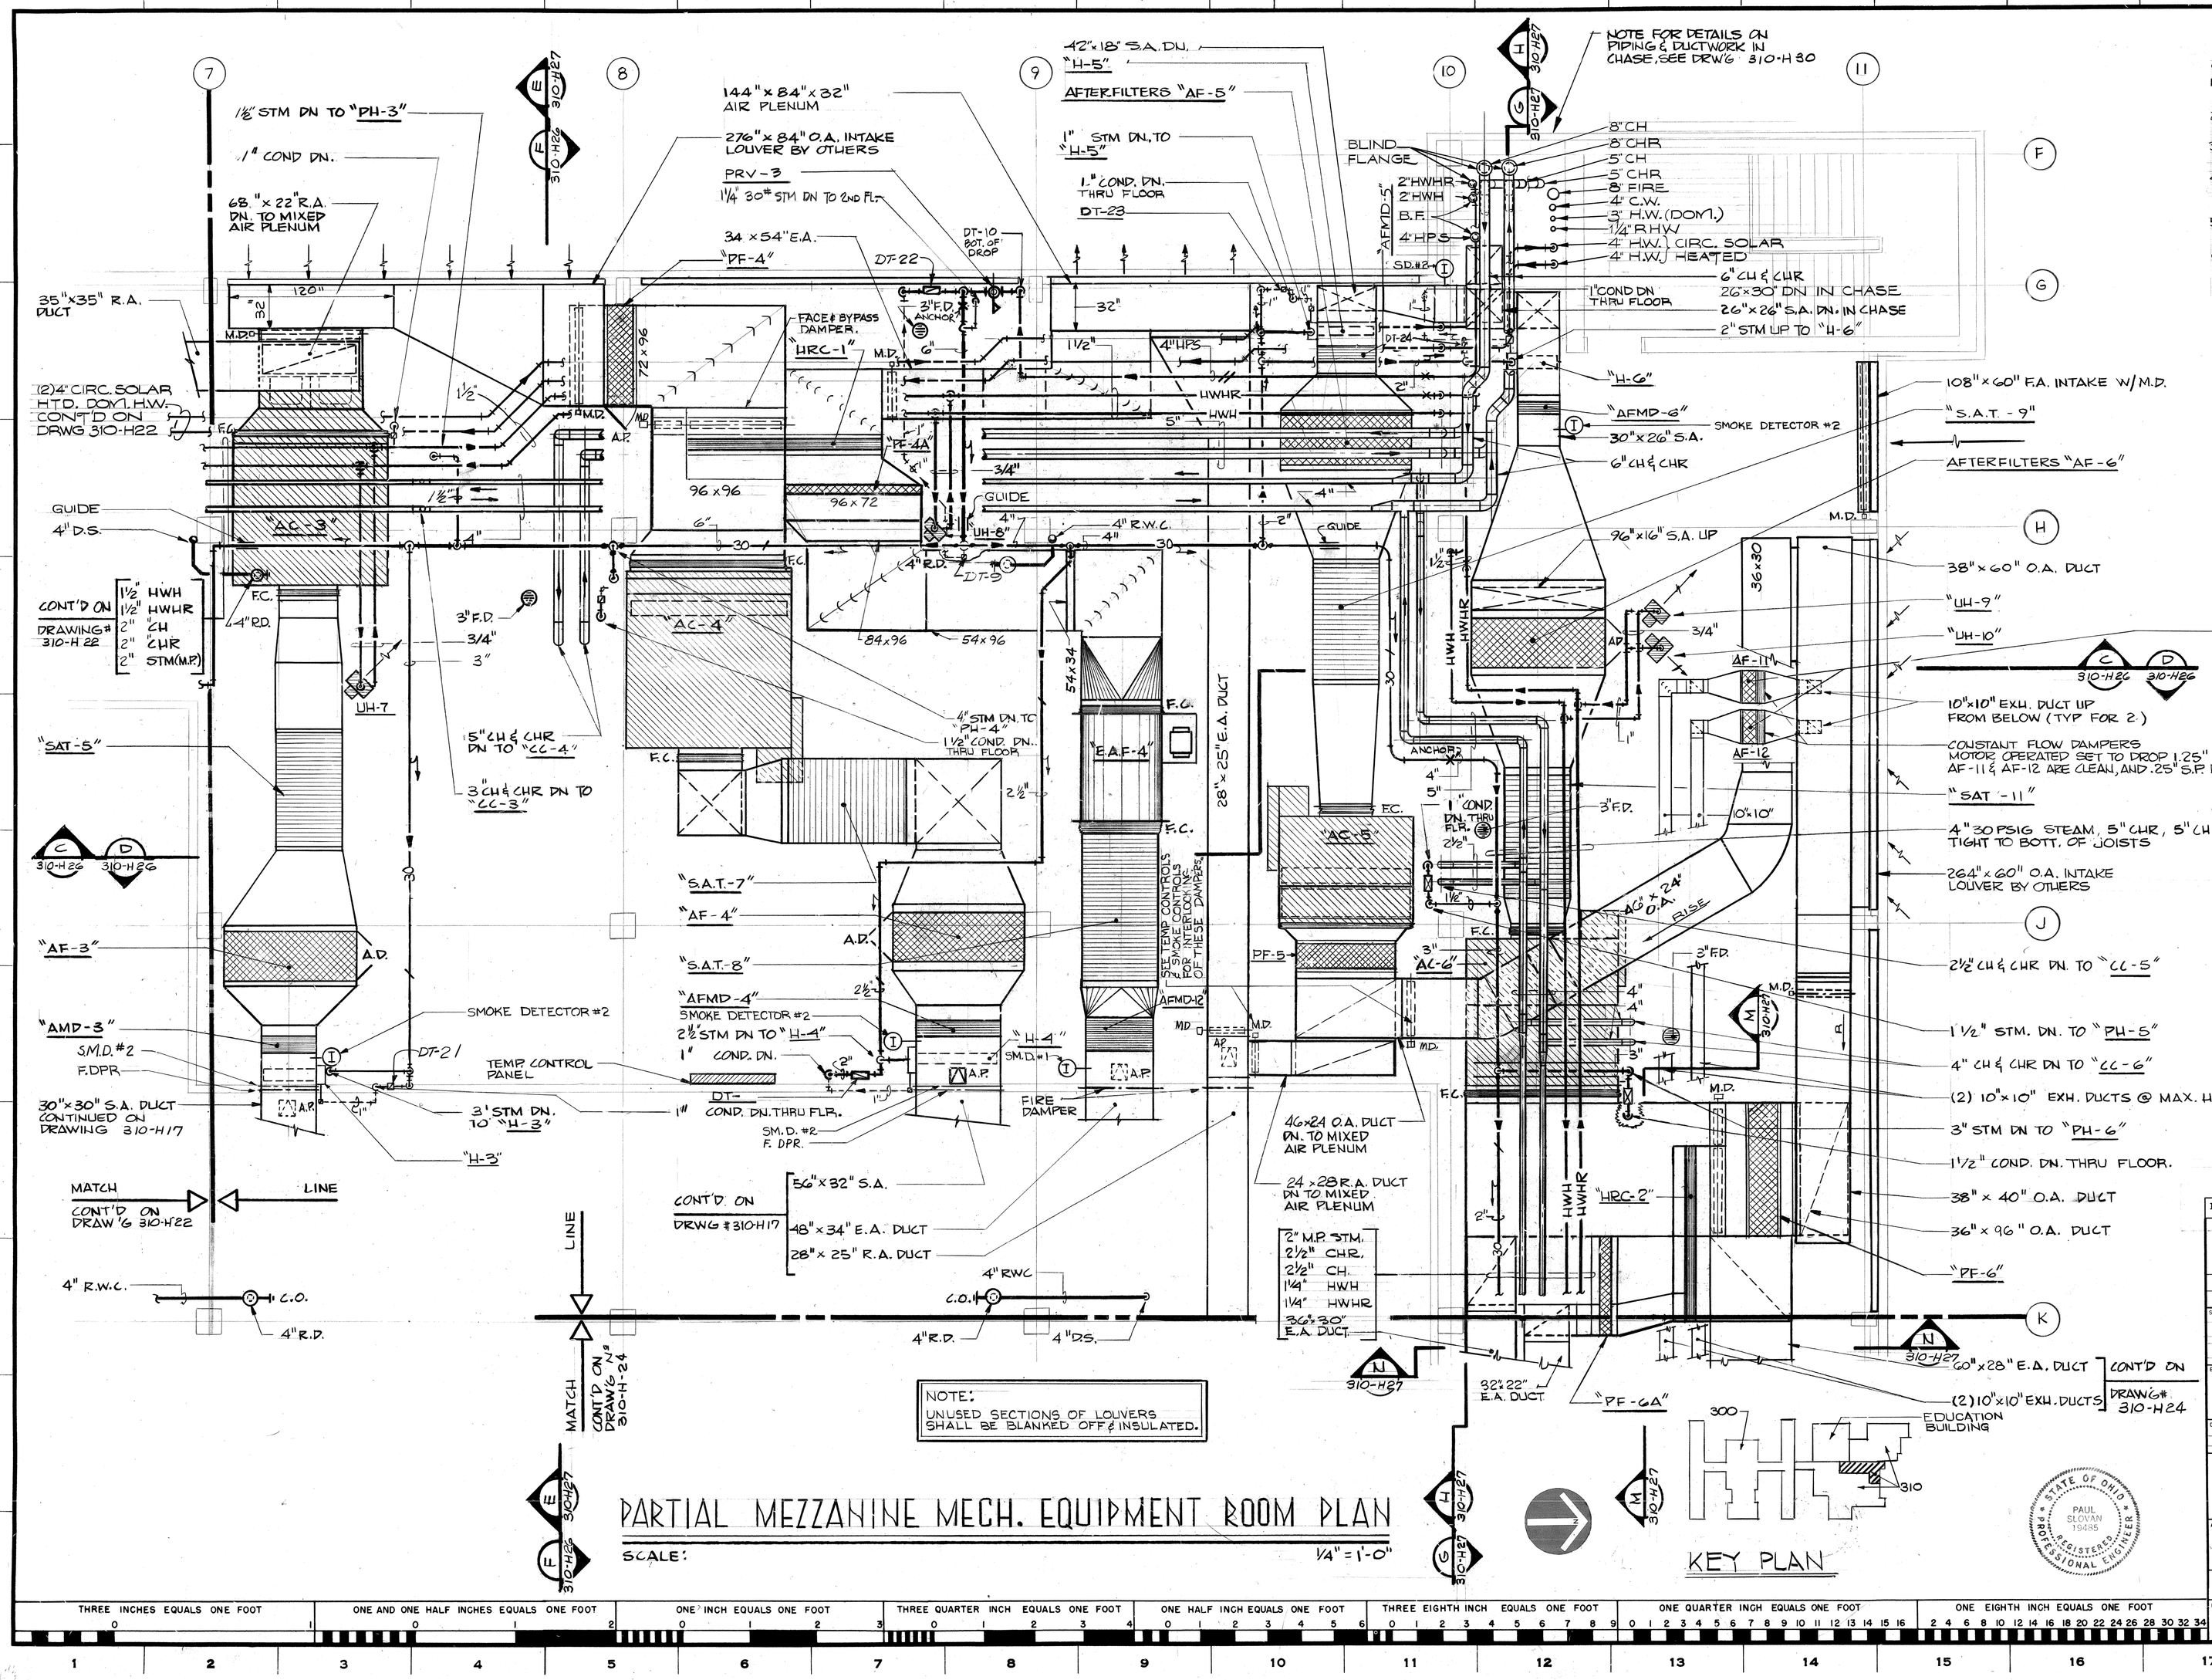

GENERAL NOTES:

1. REFER TO DRAWING Nº H-6 FOR TYPICAL PREHEAT COIL PIPING HOOK-UP DIAGRAM.
2. REFER TO DRAWING Nº H-9 FOR TYPICAL COOLING COIL PIPING HOOK-UP DIAGRAM.
3. REFER TO DRAWING Nº H-6 FOR TYPICAL HUMIDIFER PIPING HOOK-UP DIAGRAM.
4. REFER TO DRAWING Nº H-6 FOR TYPICAL END OF MAIN DRIP & TRAP PIPING HOOK-UP DIAGRAM.
5. REFER TO DRAWING Nº H-6 FOR TYPICAL UNIT HEATER PIPING HOOK-UP DIAGRAM.
6. REFER TO DRAWING Nº H-6 FOR TYPICAL PRV PIPING DETAIL

ABSOLUTE FILTER & PRE-FILTER IN FACTORY HOUSING 2 REQ'D @ 500 CFM EACH. EACH FILTER 24"×24"×6" D. SERVICE HOUSING BY FILTER MFG'R.. FILTERS FOR 99.99% EFFICIENCY, RESISTANT TO 100% R.H.. 1.0" S.P. CLEAN, 2.0" S.P. DIRTY.

5-8-1-2260

PARTIAL MEZZANINE MECH. EQUIPMENT ROOM PLAN

SCALE: 1/4" = 1'-0"

KEY PLAN

RECORD DRAWINGS	1-83 DATE	WWP BY
NO.	DATE	DESCRIPTION

REVISIONS

SHEET TITLE: HVAC MECHANICAL MEZZANINE PLAN

BLDG. NO. 310 — PROJECT TITLE: CLINICAL ADDITION

DRAWN: RW & JS — CHECKED: JAW — DATE: 12/5/77

DALTON DALTON LITTLE NEWPORT
3605 WARRENSVILLE CENTER RD.
CLEVELAND, OHIO 44122

DRAWING NUMBER: 310-H-23 — DWG. 23 OF 34

APPROVED PROJECT DIRECTOR — PROJECT NUMBER: 552-081

VETERANS ADMINISTRATION

LOCATION: VAC, DAYTON, OHIO

THREE INCHES EQUALS ONE FOOT | ONE AND ONE HALF INCHES EQUALS ONE FOOT | ONE INCH EQUALS ONE FOOT | THREE QUARTER INCH EQUALS ONE FOOT | ONE HALF INCH EQUALS ONE FOOT | THREE EIGHTH INCH EQUALS ONE FOOT | ONE QUARTER INCH EQUALS ONE FOOT | ONE EIGHTH INCH EQUALS ONE FOOT

150

VA FORM 08-6231, FEB 1973

☆ U. S. GOVERNMENT PRINTING OFFICE : 1973 O - 487-169