

(NORTH SIDE)

CANTEEN IS  
A PART OF B7

B7







B7

PART  
OF  
B7

(WEST  
SIDE)

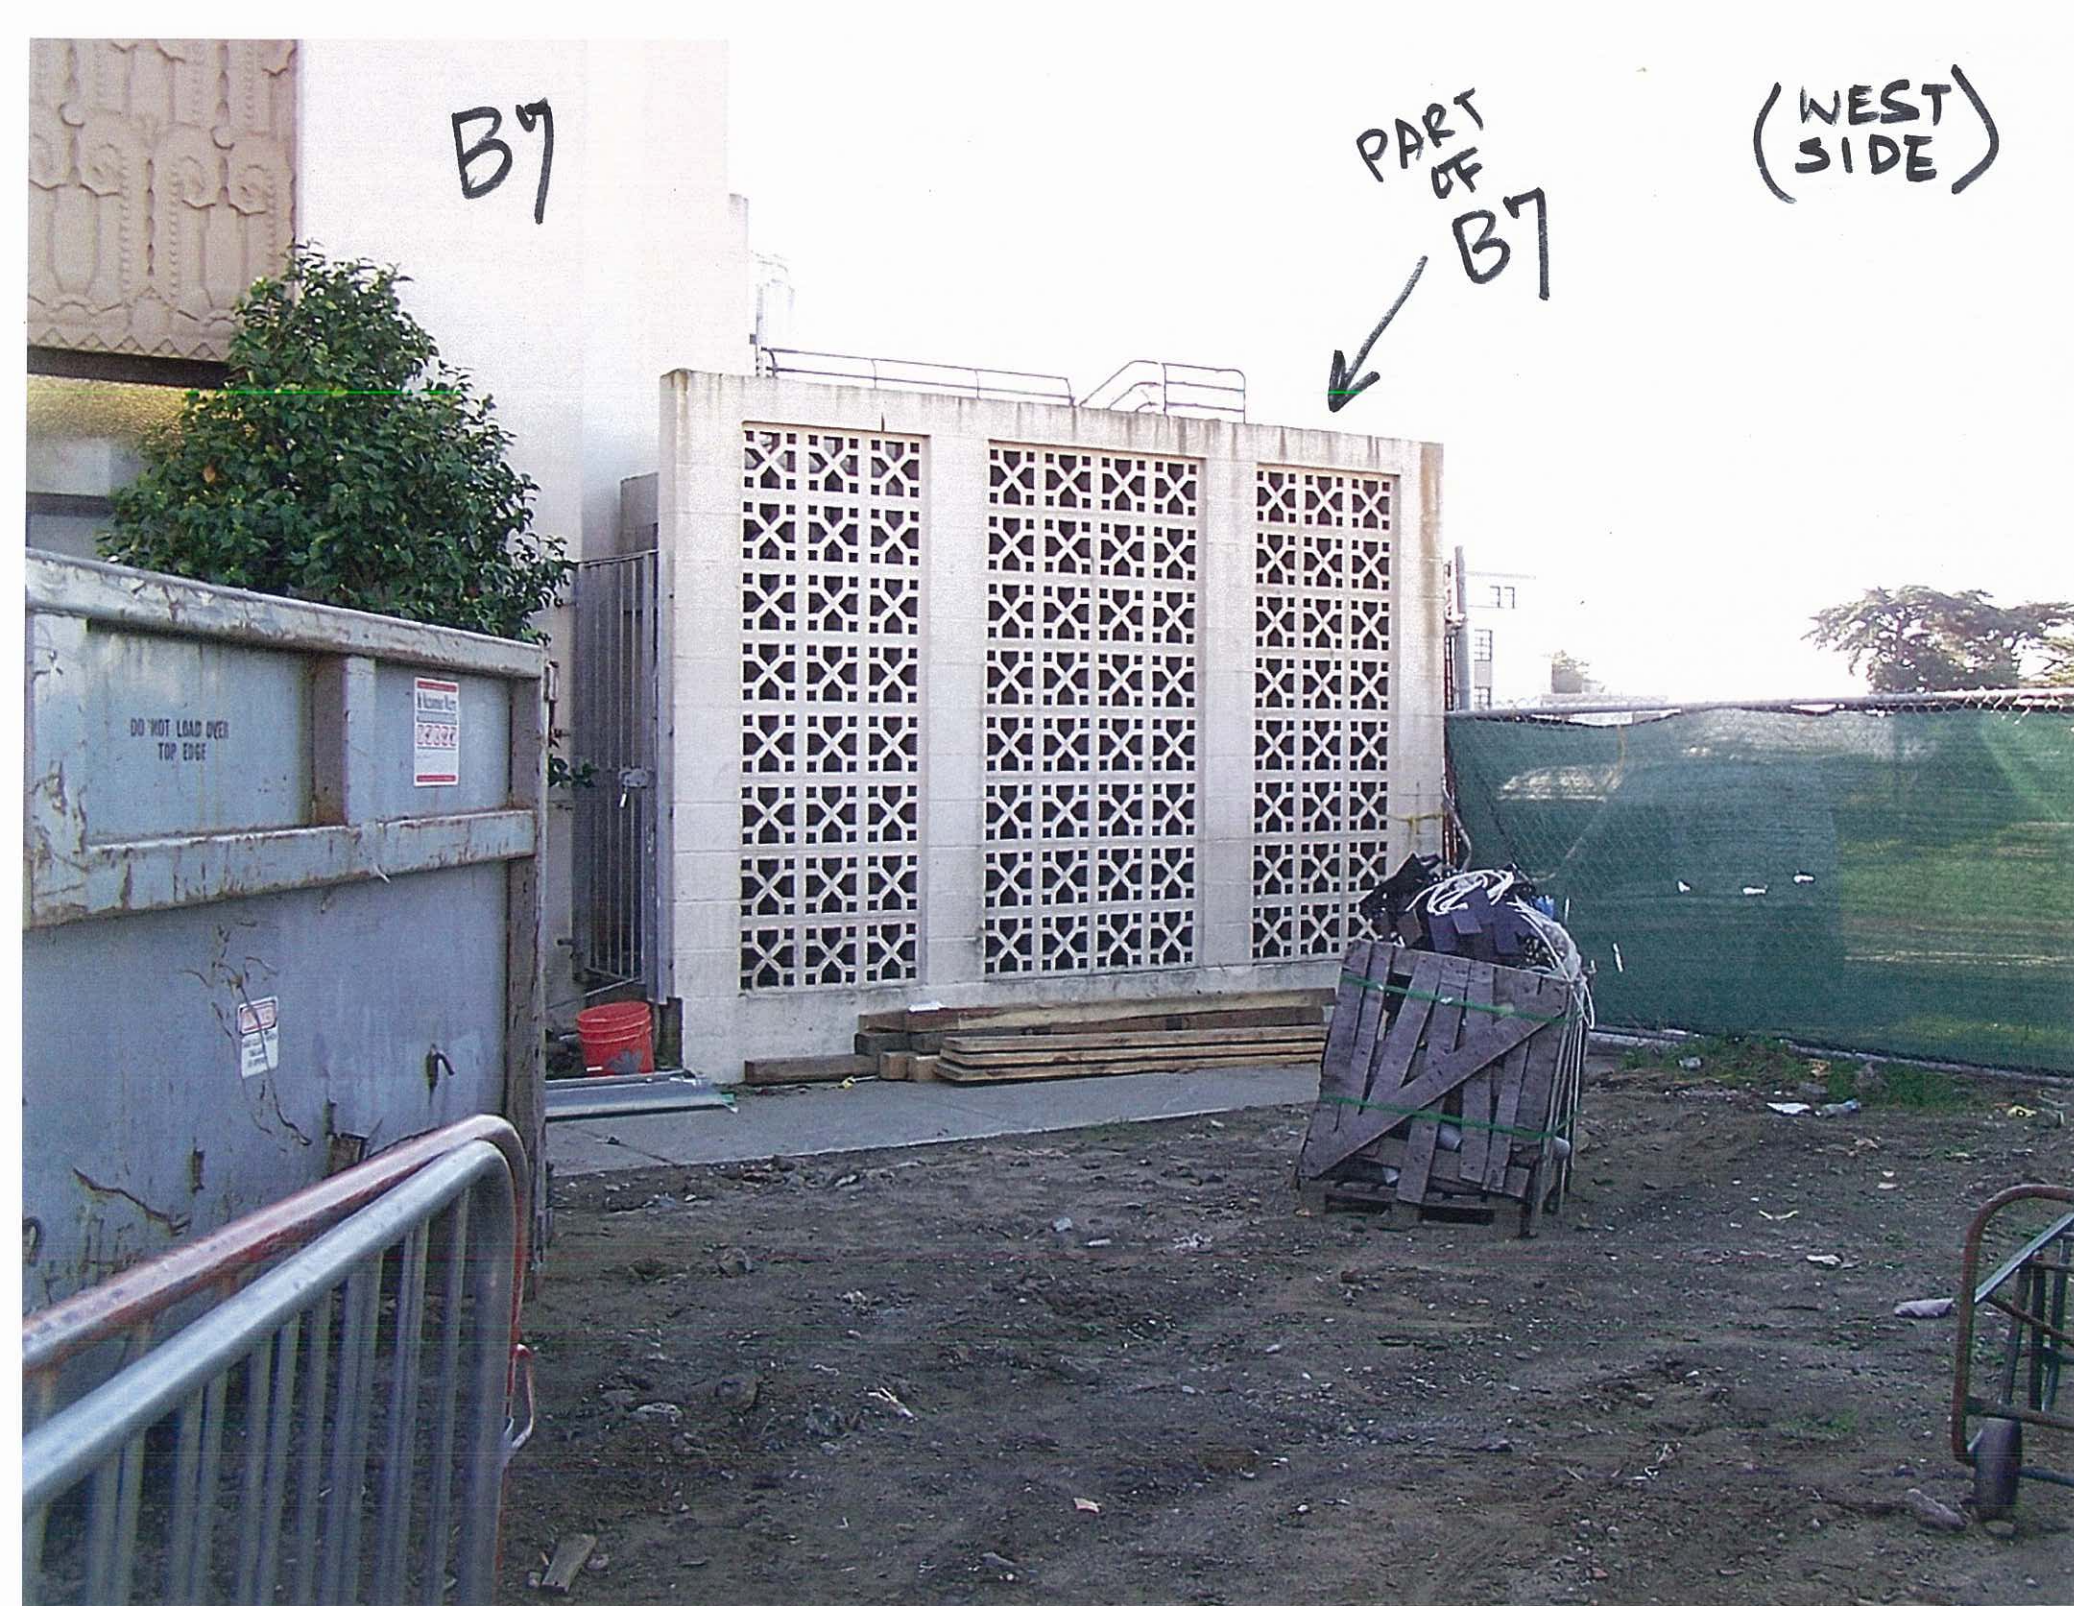





REPLACE  
B7 NORTH UPPER FLOOR  
CORROSION ON SHEET METAL  
(ABOVE CANTEEN)



# B7 LOUVER S SOUTH WALL

