



B210

**ASBESTOS-CONTAINING MATERIALS SURVEY  
VETERANS AFFAIRS MEDICAL CENTER  
4150 CLEMENT STREET  
BUILDING 210  
SAN FRANCISCO, CALIFORNIA**

Submitted to:

Floyd Devenbeck, PE  
Engineer  
Veterans Affairs Medical Center  
4150 Clement Street  
San Francisco, California 94121

Prepared By:

A handwritten signature in blue ink, appearing to read "M.S. Benefield".

Michael S. Benefield, PE, CAC #06-3938  
Senior Project Manager

Reviewed By:


A handwritten signature in black ink, appearing to read "Dario A. Oakley".

Dario A. Oakley, CHMM, REA  
Asbestos and Lead Program Manager

IHI Project No. 09B-2173

May 7, 2010

#133-1,2,3,4,5,6

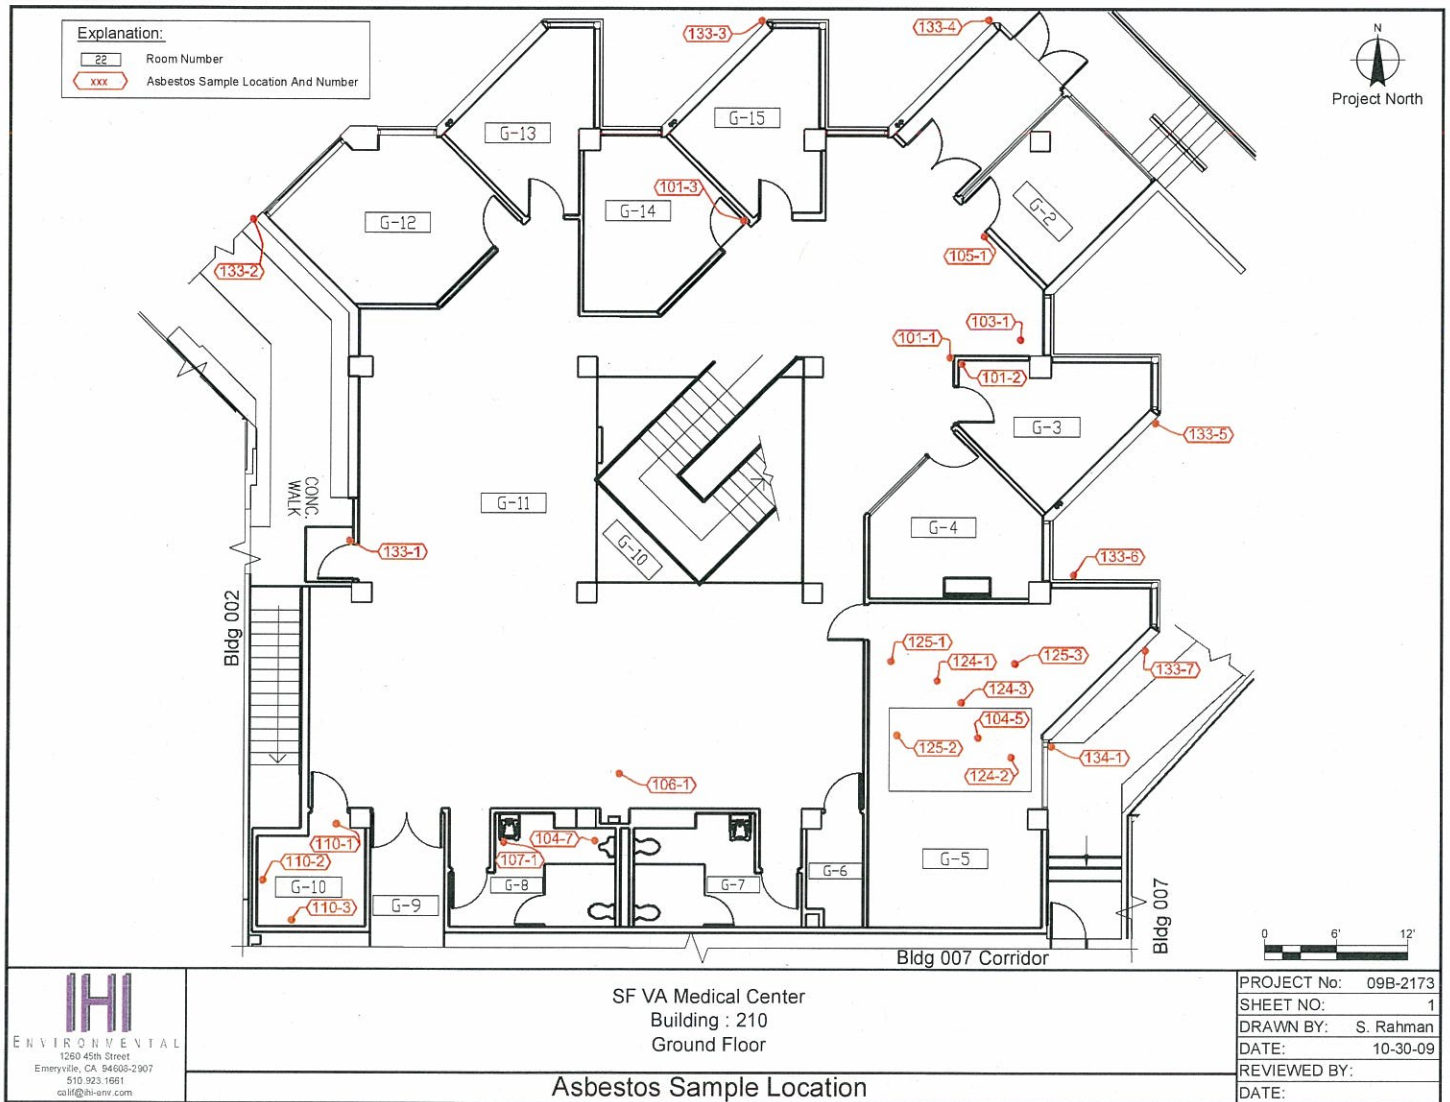

**IHI**  
ENVIRONMENTAL  
1260 45th Street  
Emeryville, CA 94608-2907  
510.923.1661  
calif@ihi-env.com

SF VA Medical Center  
Building : 210  
Ground Floor

**Asbestos Sample Location**

PROJECT No:	09B-2173
SHEET NO:	1
DRAWN BY:	S. Rahman
DATE:	10-30-09
REVIEWED BY:	
DATE:	

\\ut-server\asbestos\OuterOffice\CAD\Emeryville\2009\09B-2173\09B-2173 Bldg 001,002,004,005,006,007,010,200.dwg, 010 FPGM, 10/30/2009 2:26:40 PM, sylvar

Project Name:

Building 210

Survey Segment:

A: Building 210

Address:

4150 Clement St, San Francisco, CA

<u>Sample #</u>	<u>Homogeneous Area #</u>	<u>Material Description</u>	<u>Location /Description</u>	<u>Asbestos Results</u>
210-130-2	130B	Vinyl stair tread Black (Split Layer: Glue-Clear)	2-4: East Stairs Stairwell Throughout Space: 3rd Floor, E Stairs	ND None Detected
210-130-3	130	Vinyl stair tread Black	2-4: East Stairs Stairwell Throughout Space: 4th Floor, E Stairs	ND None Detected
210-130-3	130B	Vinyl stair tread Black (Split Layer: Glue-Clear)	2-4: East Stairs Stairwell Throughout Space: 4th Floor, E Stairs	ND None Detected
210-131-1	131	HVAC Duct Sealant Tan	Roof: Roof Roof Throughout Space: On Duct, N	ND None Detected
210-132-1	132	HVAC Duct Sealant Grey	Roof: Roof Roof Throughout Space: On Duct, E	ND None Detected
210-133-1	133	Stucco Beige	Exterior: Exterior Exterior Exterior: SW Outside Room G-11	ND None Detected
210-133-2	133	Stucco Beige	Exterior: Exterior Exterior Exterior: W Outside Room G-12	ND None Detected
210-133-3	133	Stucco Beige	Exterior: Exterior Exterior Exterior: NW Outside Room G-15	ND None Detected
210-133-4	133	Stucco Beige	Exterior: Exterior Exterior Exterior: N Outside Vestibule	ND None Detected
210-133-5	133	Stucco Beige	Exterior: Exterior Exterior Exterior: NE Outside Room G-3	ND None Detected
210-133-6	133	Stucco Beige	Exterior: Exterior Exterior Exterior: E Outside Room G-4	ND None Detected
210-133-7	133	Stucco Beige	Exterior: Exterior Exterior Exterior: SE Outside Room G-5	ND None Detected
210-134-1	134	Caulk Gray	Exterior: Exterior Exterior Exterior: SE Outside G-5	ND None Detected

Total Samples: 123