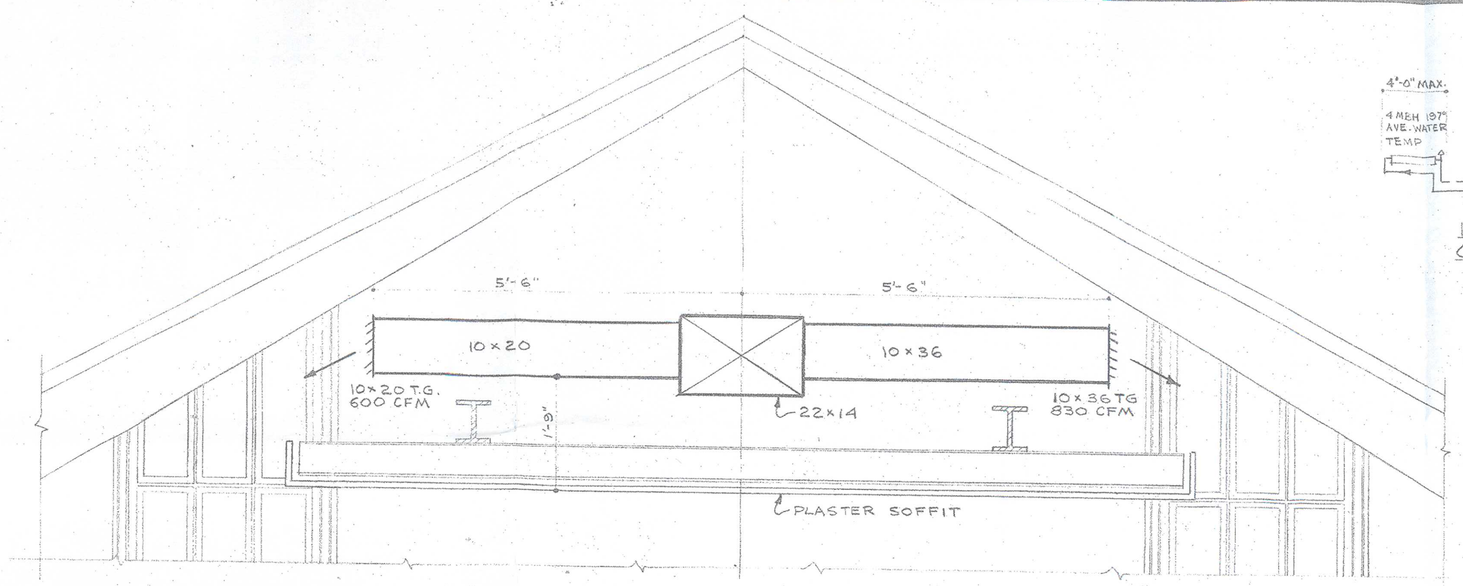

SECTION "Q-Q"
SCALE: 3/4" = 1'-0"

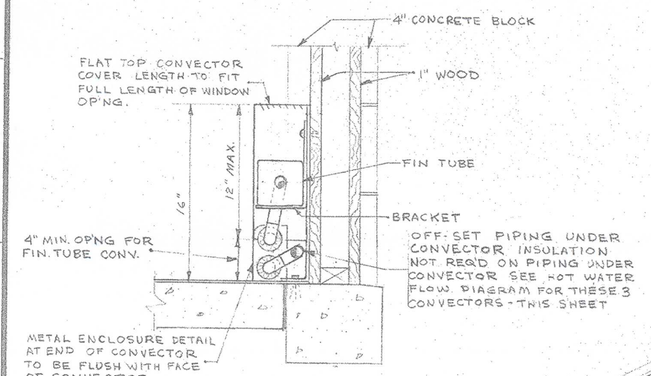

SECTION T-T
1½" = 1'-0"

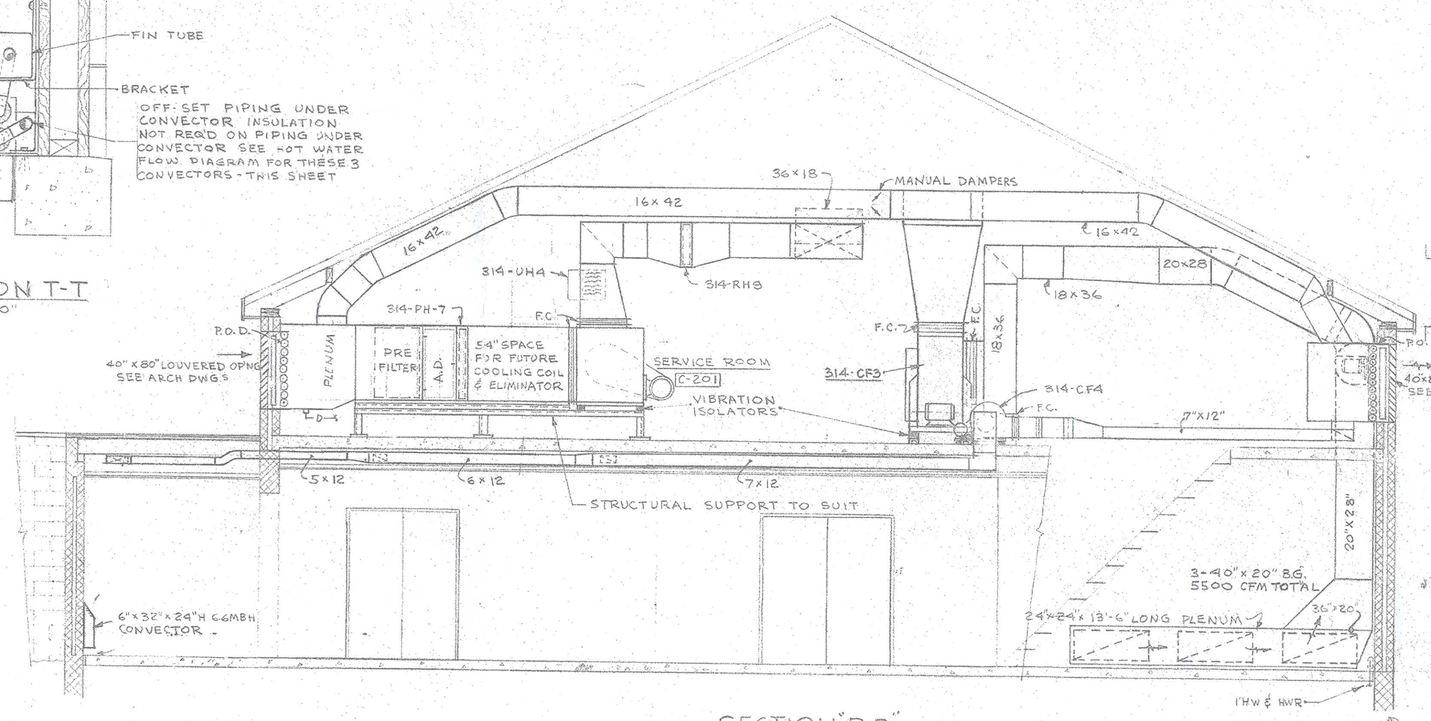

SECTION "R R"
SCALE ½" = 1'-0"

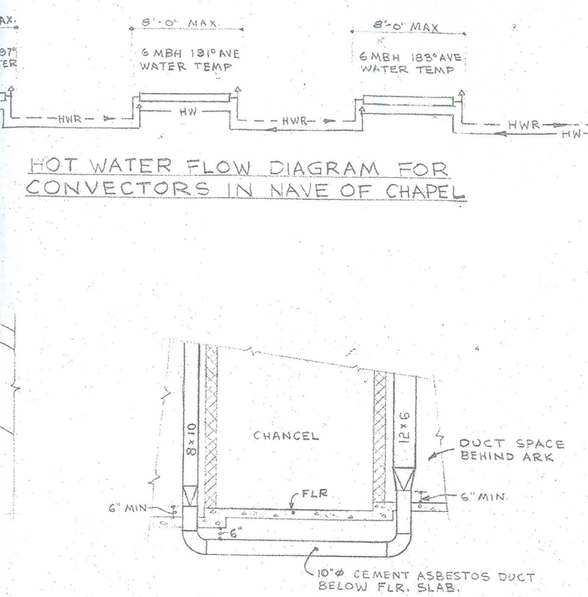

SECTION "S-S"

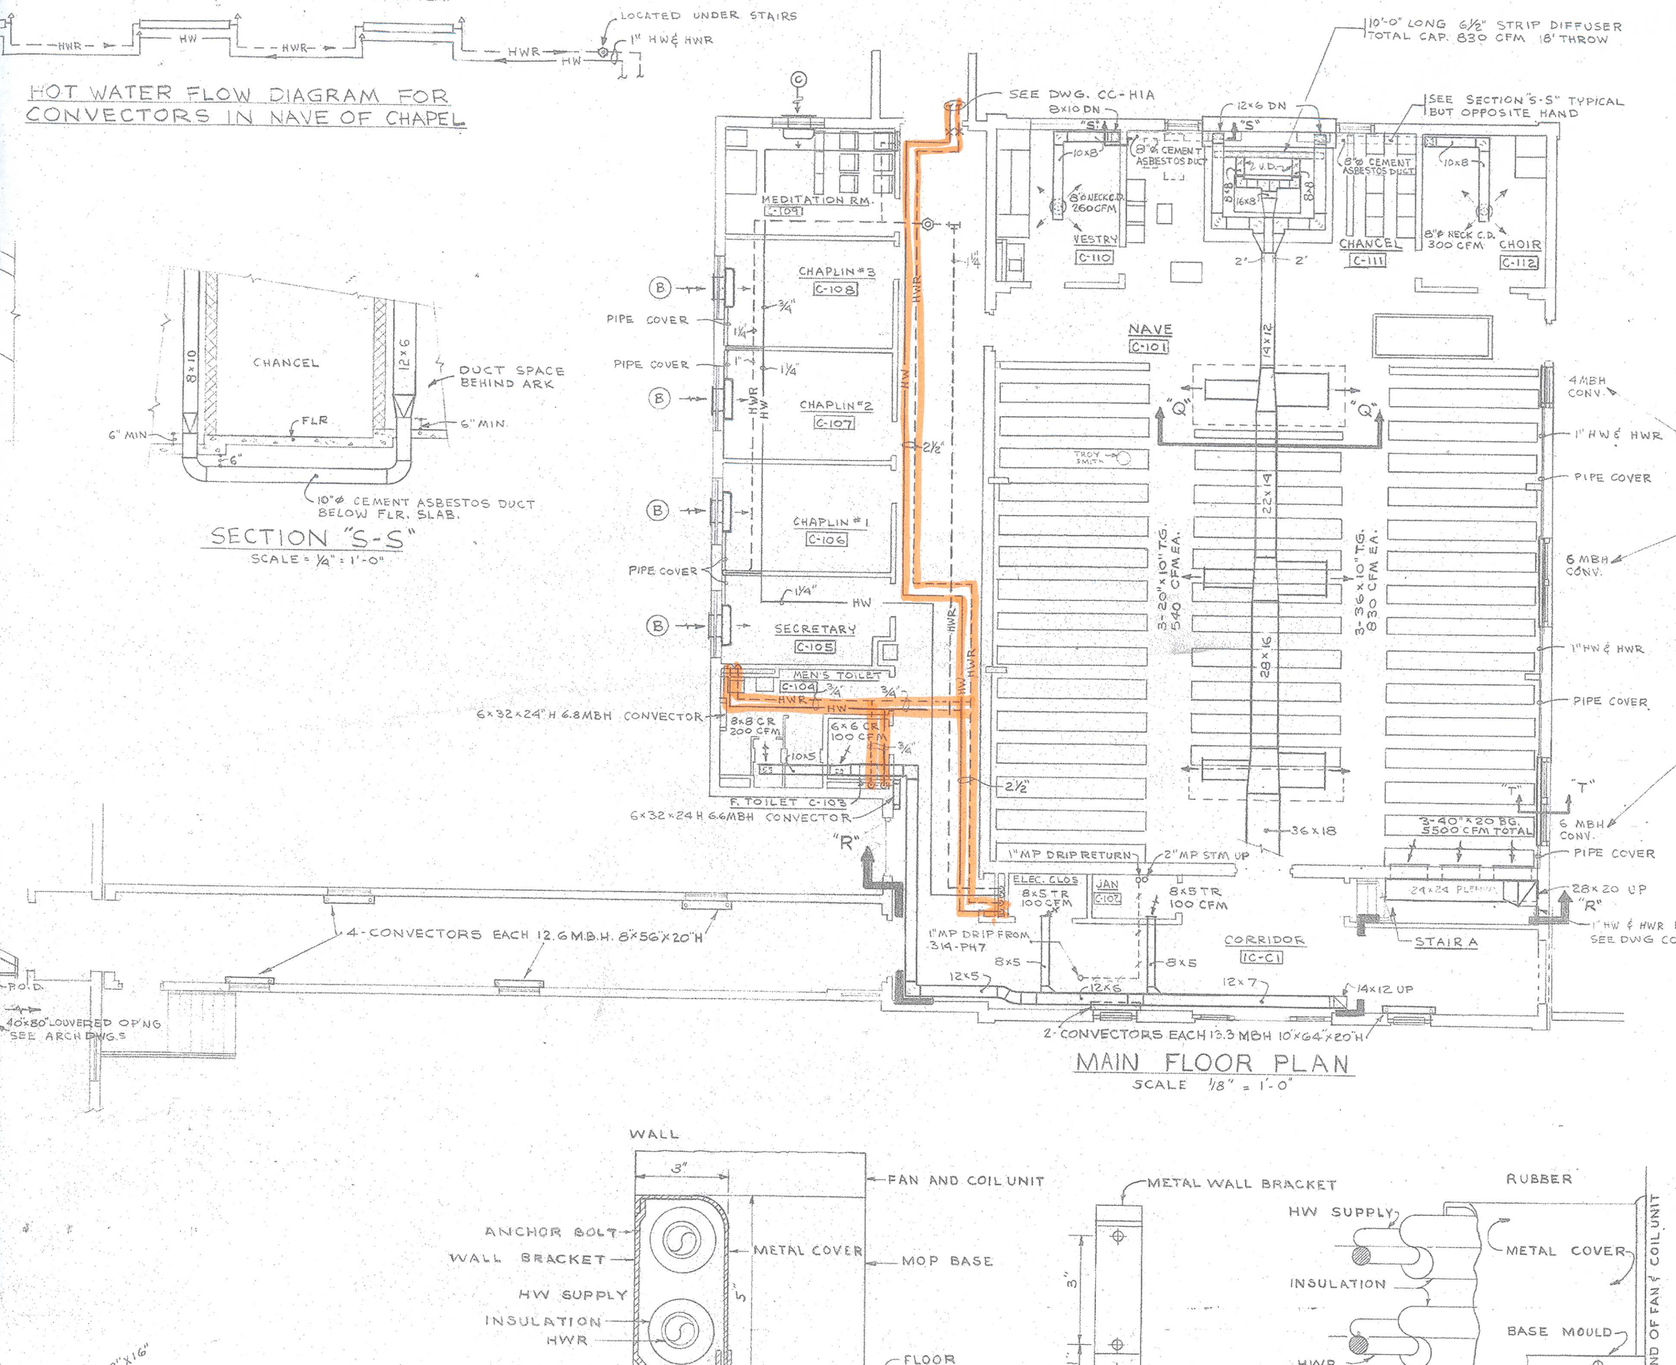

MAIN FLOOR PLAN
SCALE 1/8" = 1'-0"

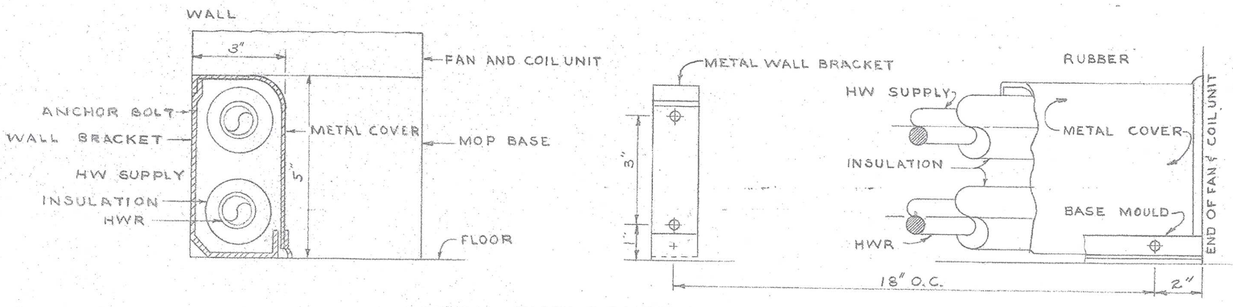

METAL ENCLOSURE DETAIL
NOT TO SCALE

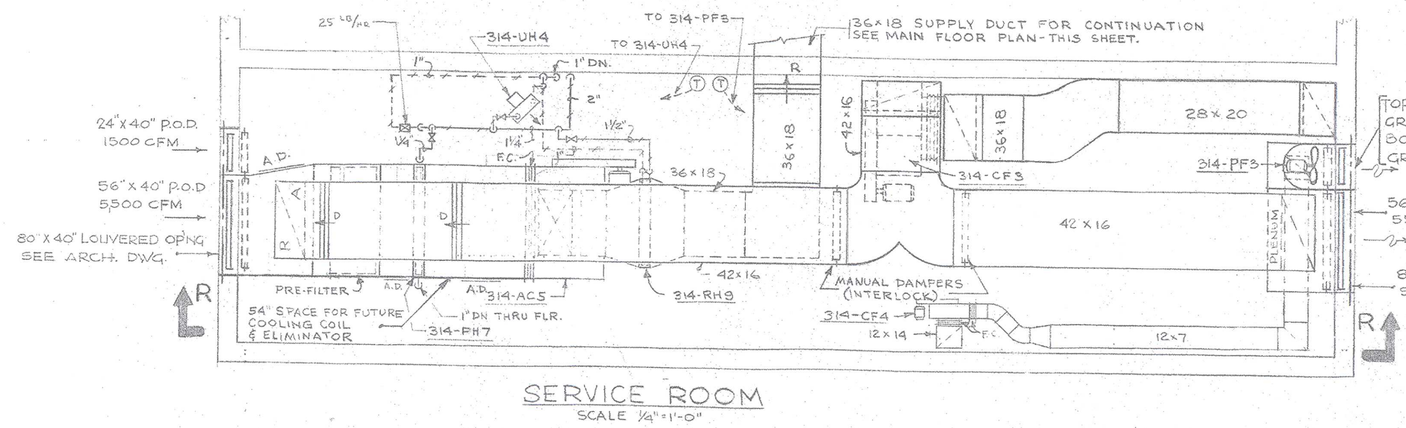

SERVICE ROOM

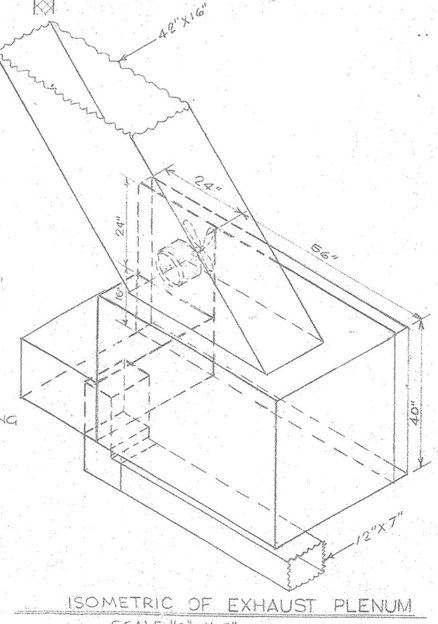

ISOMETRIC OF EXHAUST PLENUM
SCALE ½" = 1'-0"

THIS DWG. APPLIES FOR BID ITEM II ONLY

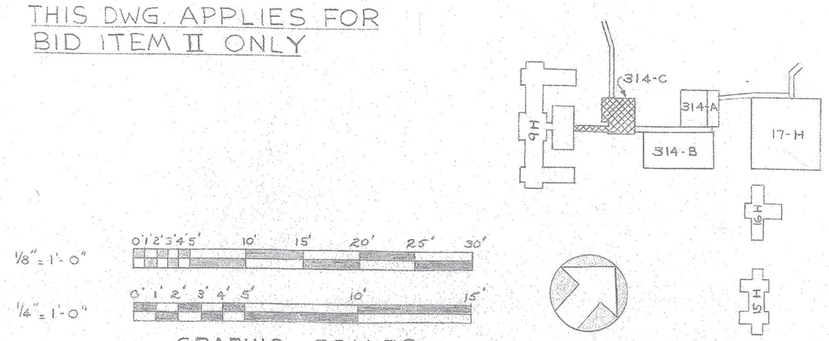

PLANS AND SECTIONS
CHAPEL - BUILDING No 314-C
SPECIAL ACTIVITIES COMPLEX 314 CONNECTING CORRIDORS AND ALTERATIONS TO BUILDINGS 15H, 17H
VETERANS ADMINISTRATION
PERRY POINT, MD.

Drawn A.P.S. L.G.S.		REVISIONS
Checked R.K.	Date 4/27/67	
DIVISION CHIEF-A/C & REFRIG DIVISION		DRAWING NUMBER 314C-H1R
APPROVED DIRECTOR, MECH-ELECT SERV		Sheet 1 Of 1
		Proj. No. 15-5144

VA FORM 10-6231, DEC. 1962
U.S. GOVERNMENT PRINTING OFFICE: 1963 O—686865