



three inches = one foot
one and one half inches = one foot
one inch = one foot
three quarters inch = one foot
one half inch = one foot
one quarter inch = one foot
one eighth inch = one foot
one eighth inch = one foot

- GENERAL NOTES**
1. FIELD VERIFY ALL DIMENSIONS PRIOR TO FABRICATION.
 2. REFER TO ARCHITECTURAL DRAWINGS FOR ROOM DIMENSIONS, CONSTRUCTION, AND FINISHES.
 3. PROVIDE FILLER PANELS AS REQUIRED ADJACENT TO WALLS AND ADJACENT CABINETRY.
 4. AT ALL COUNTER AREAS WITH UNDER COUNTER (U/C) COMPACT REFRIGERATORS, ADJUST COUNTER HEIGHT AND OPENING WIDTH OF CABINETS TO ALLOW FOR REQUIRED CLEARANCE. VERIFY IF CLEARANCES REQUIRED WITH EQUIPMENT MANUFACTURER.
 5. IN ALL OPENINGS IN BASE CABINETS, PROVIDE FINISHED END PANELS AT ALL EXPOSED VERTICAL SURFACES.
 6. ALL EXPOSED COUNTERTOP CORNERS TO RECEIVE 2" EASED EDGE UNLESS NOTED OTHERWISE.
 7. ALL CASEWORK TO BE LOCKABLE EXCEPT IN C904 MULTIPURPOSE ROOM.
 8. ALL CASEWORK BELOW SINKS SHALL BE FIXED PANELS SECURED AGAINST OPERATION.


10 C905 CORRIDOR
1/4" = 1'-0"

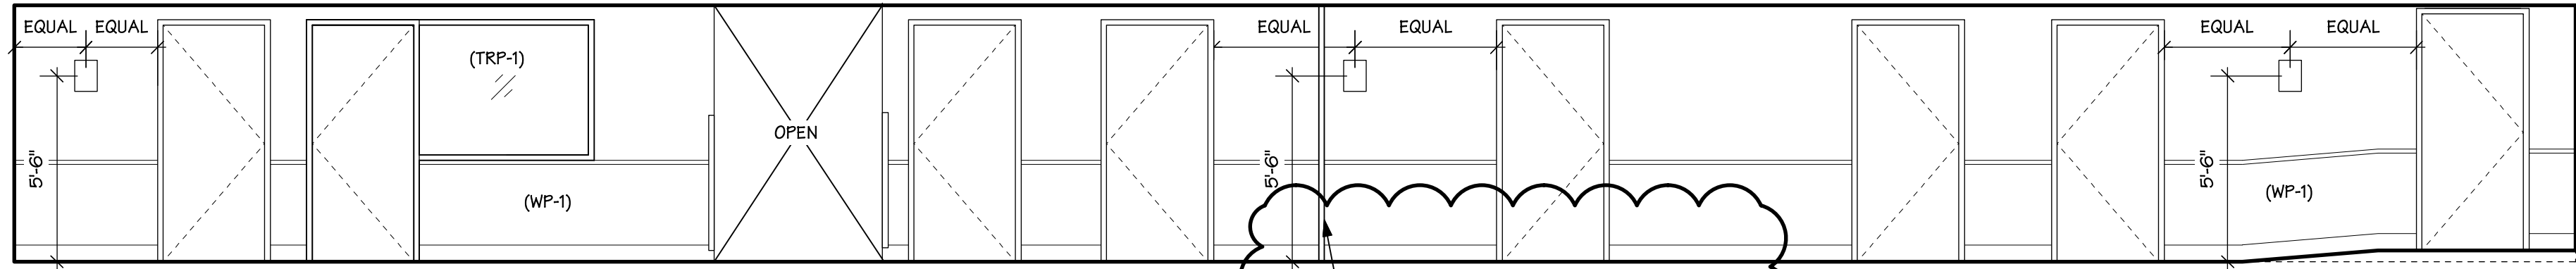


9 C905 CORRIDOR
1/4" = 1'-0"

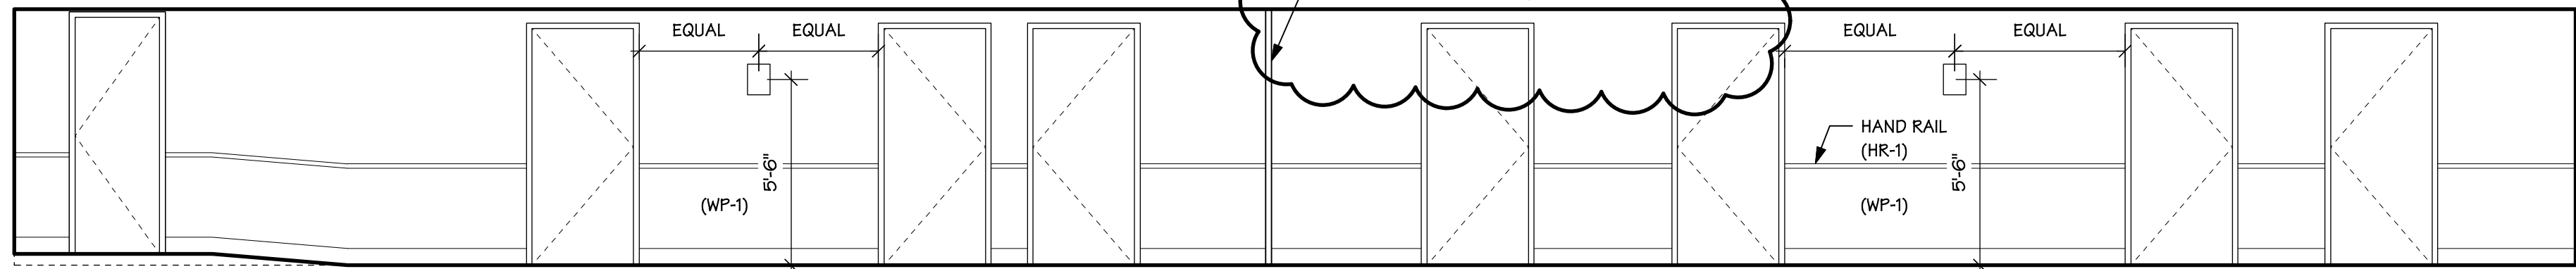


8 C906A EQUIPMENT ALCOVE
1/4" = 1'-0"

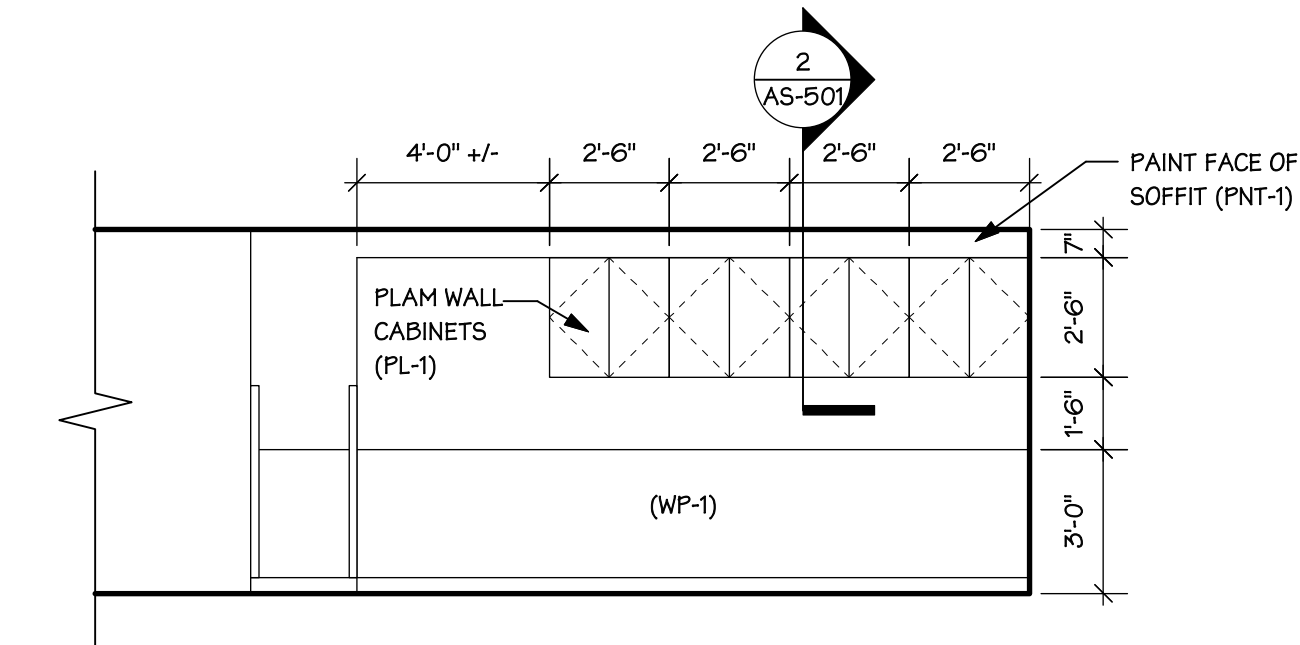


7 C924 MULTIPURPOSE ROOM
1/4" = 1'-0"

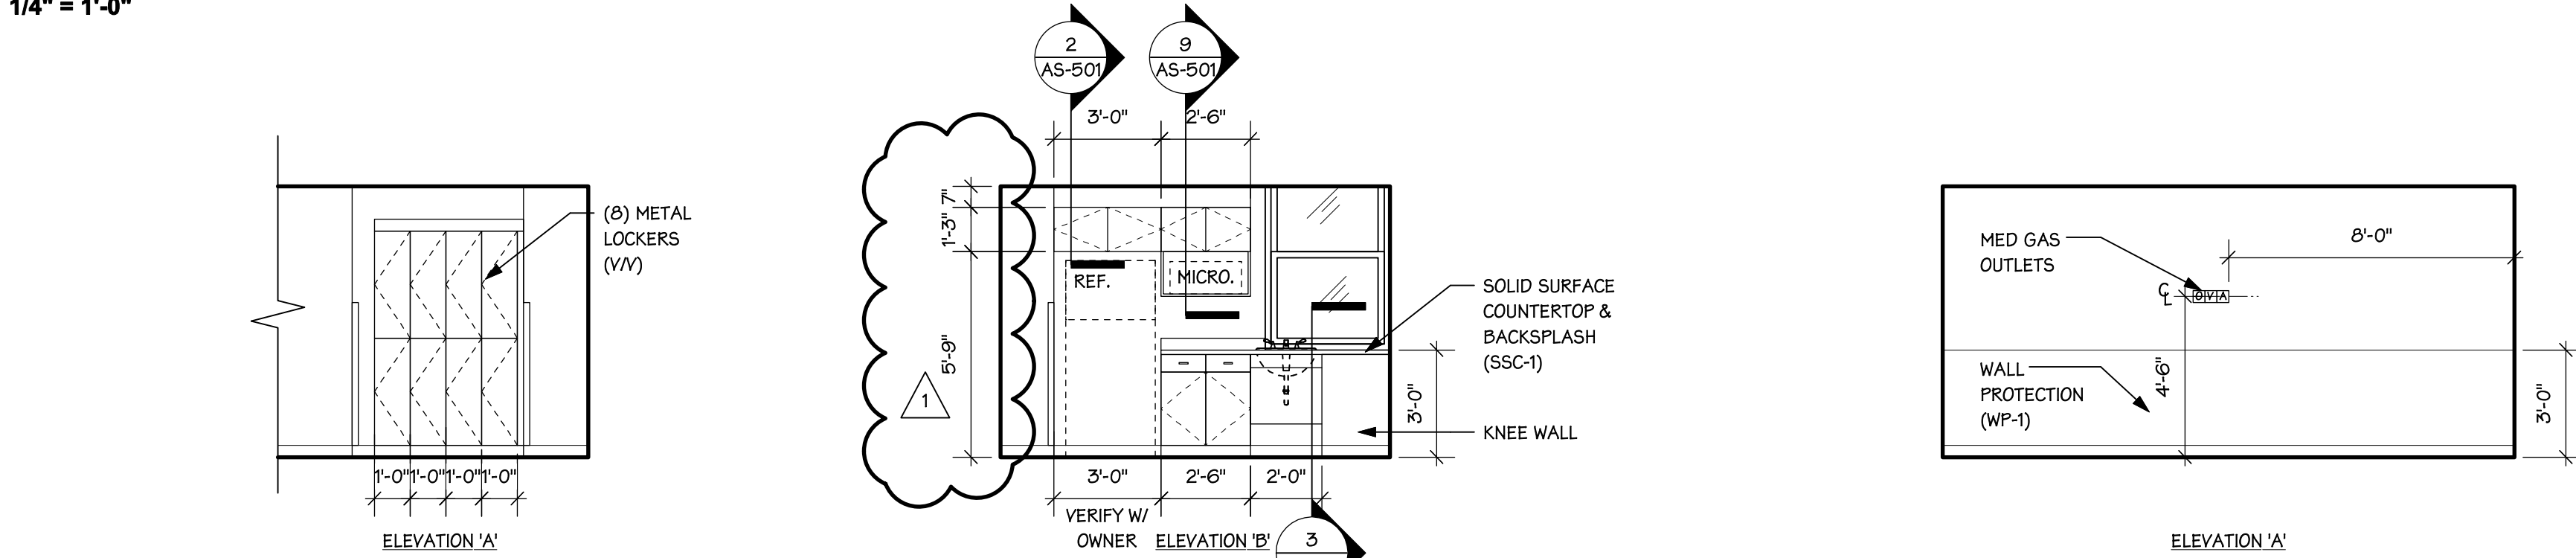


6 TYPICAL PROCEDURE ROOM
1/4" = 1'-0"

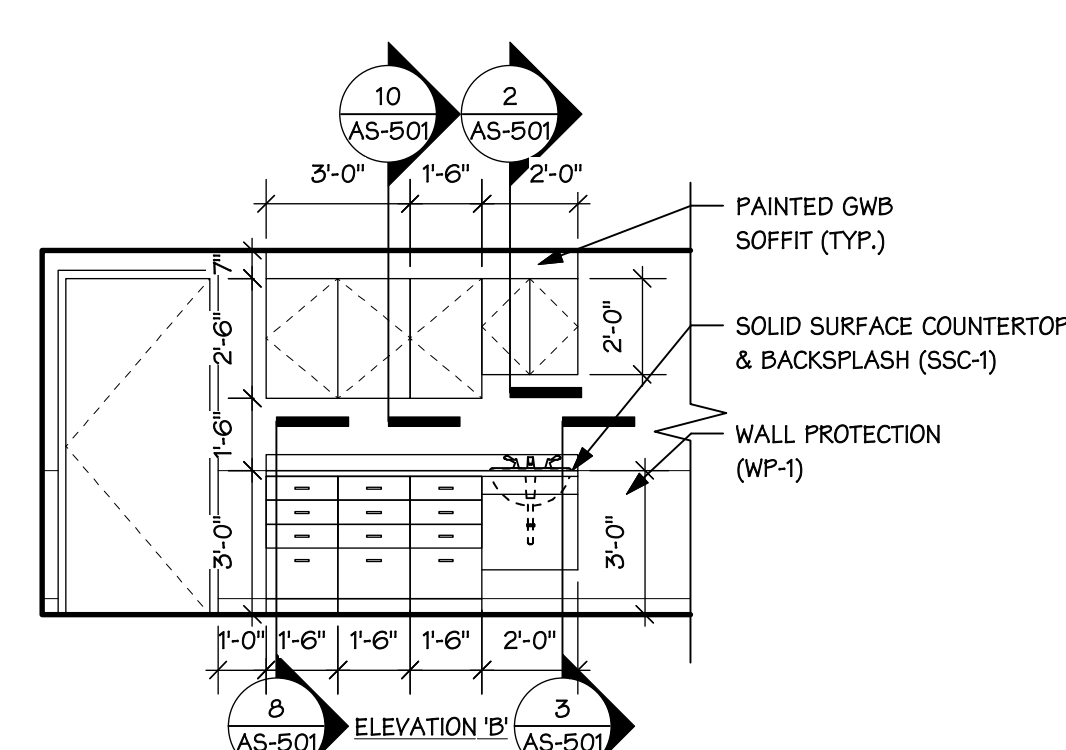


5 TYPICAL EXAM ROOM
1/4" = 1'-0"

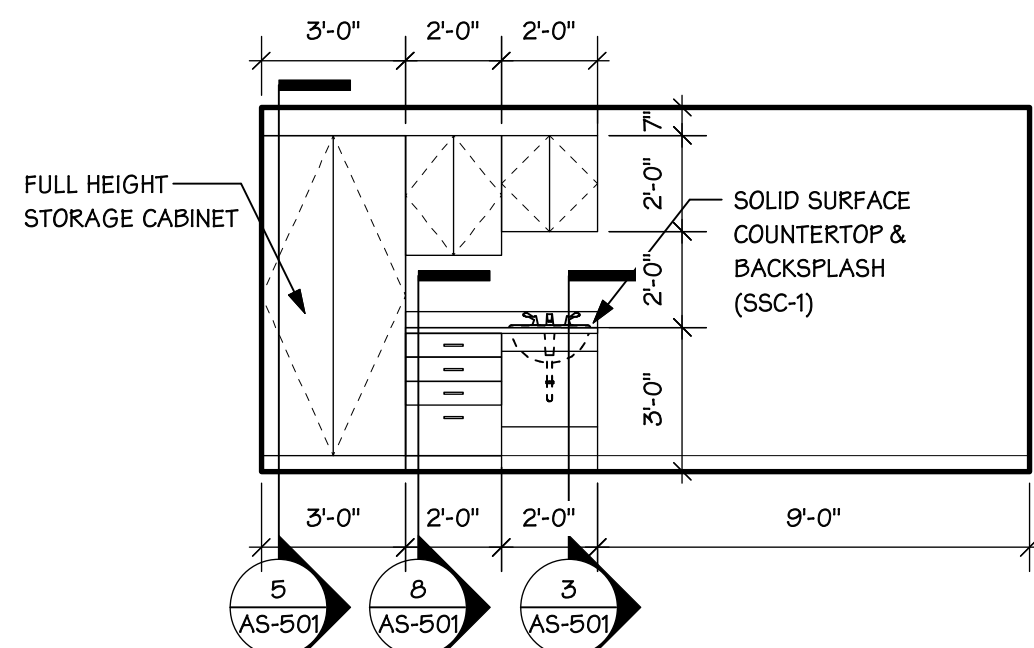


4 C912 SHARED DOCUMENTATION ROOM
1/4" = 1'-0"

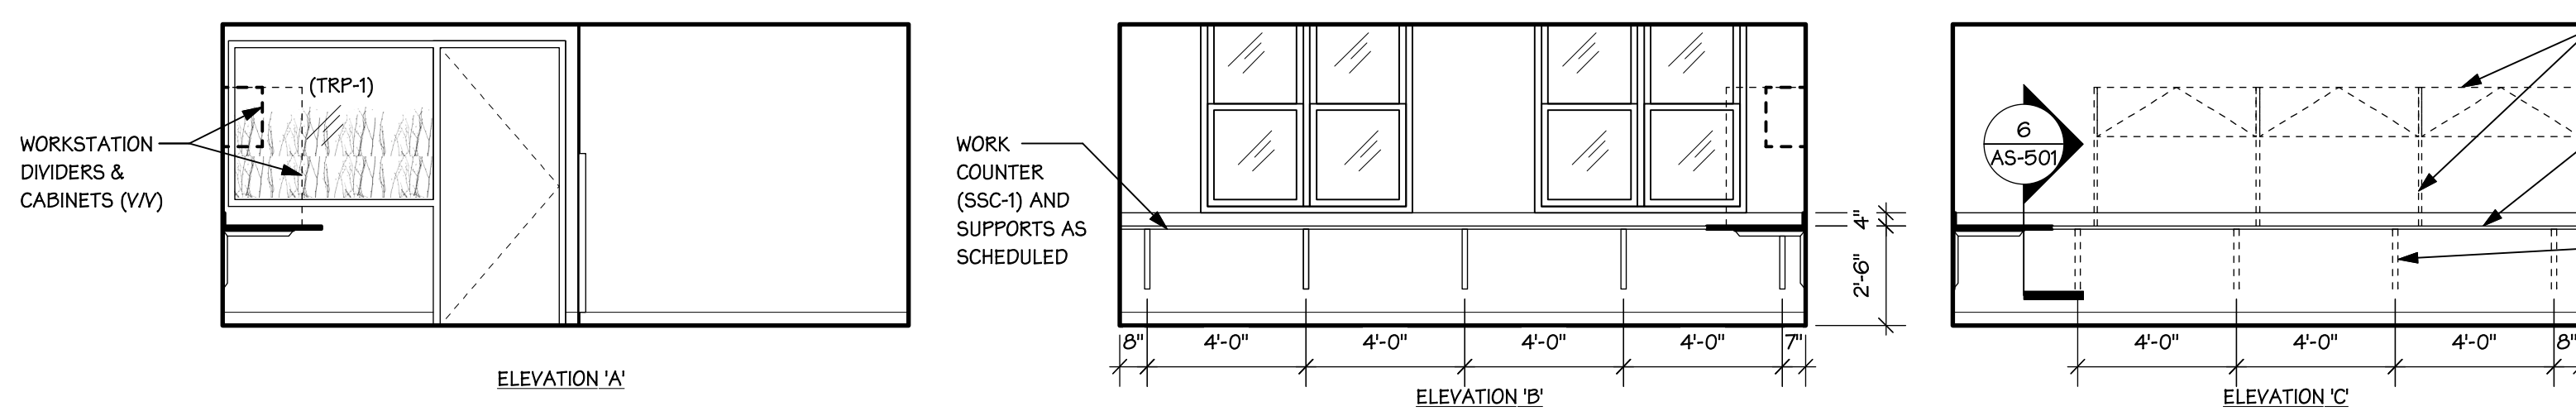


3 C910 TRIAGE
1/4" = 1'-0"

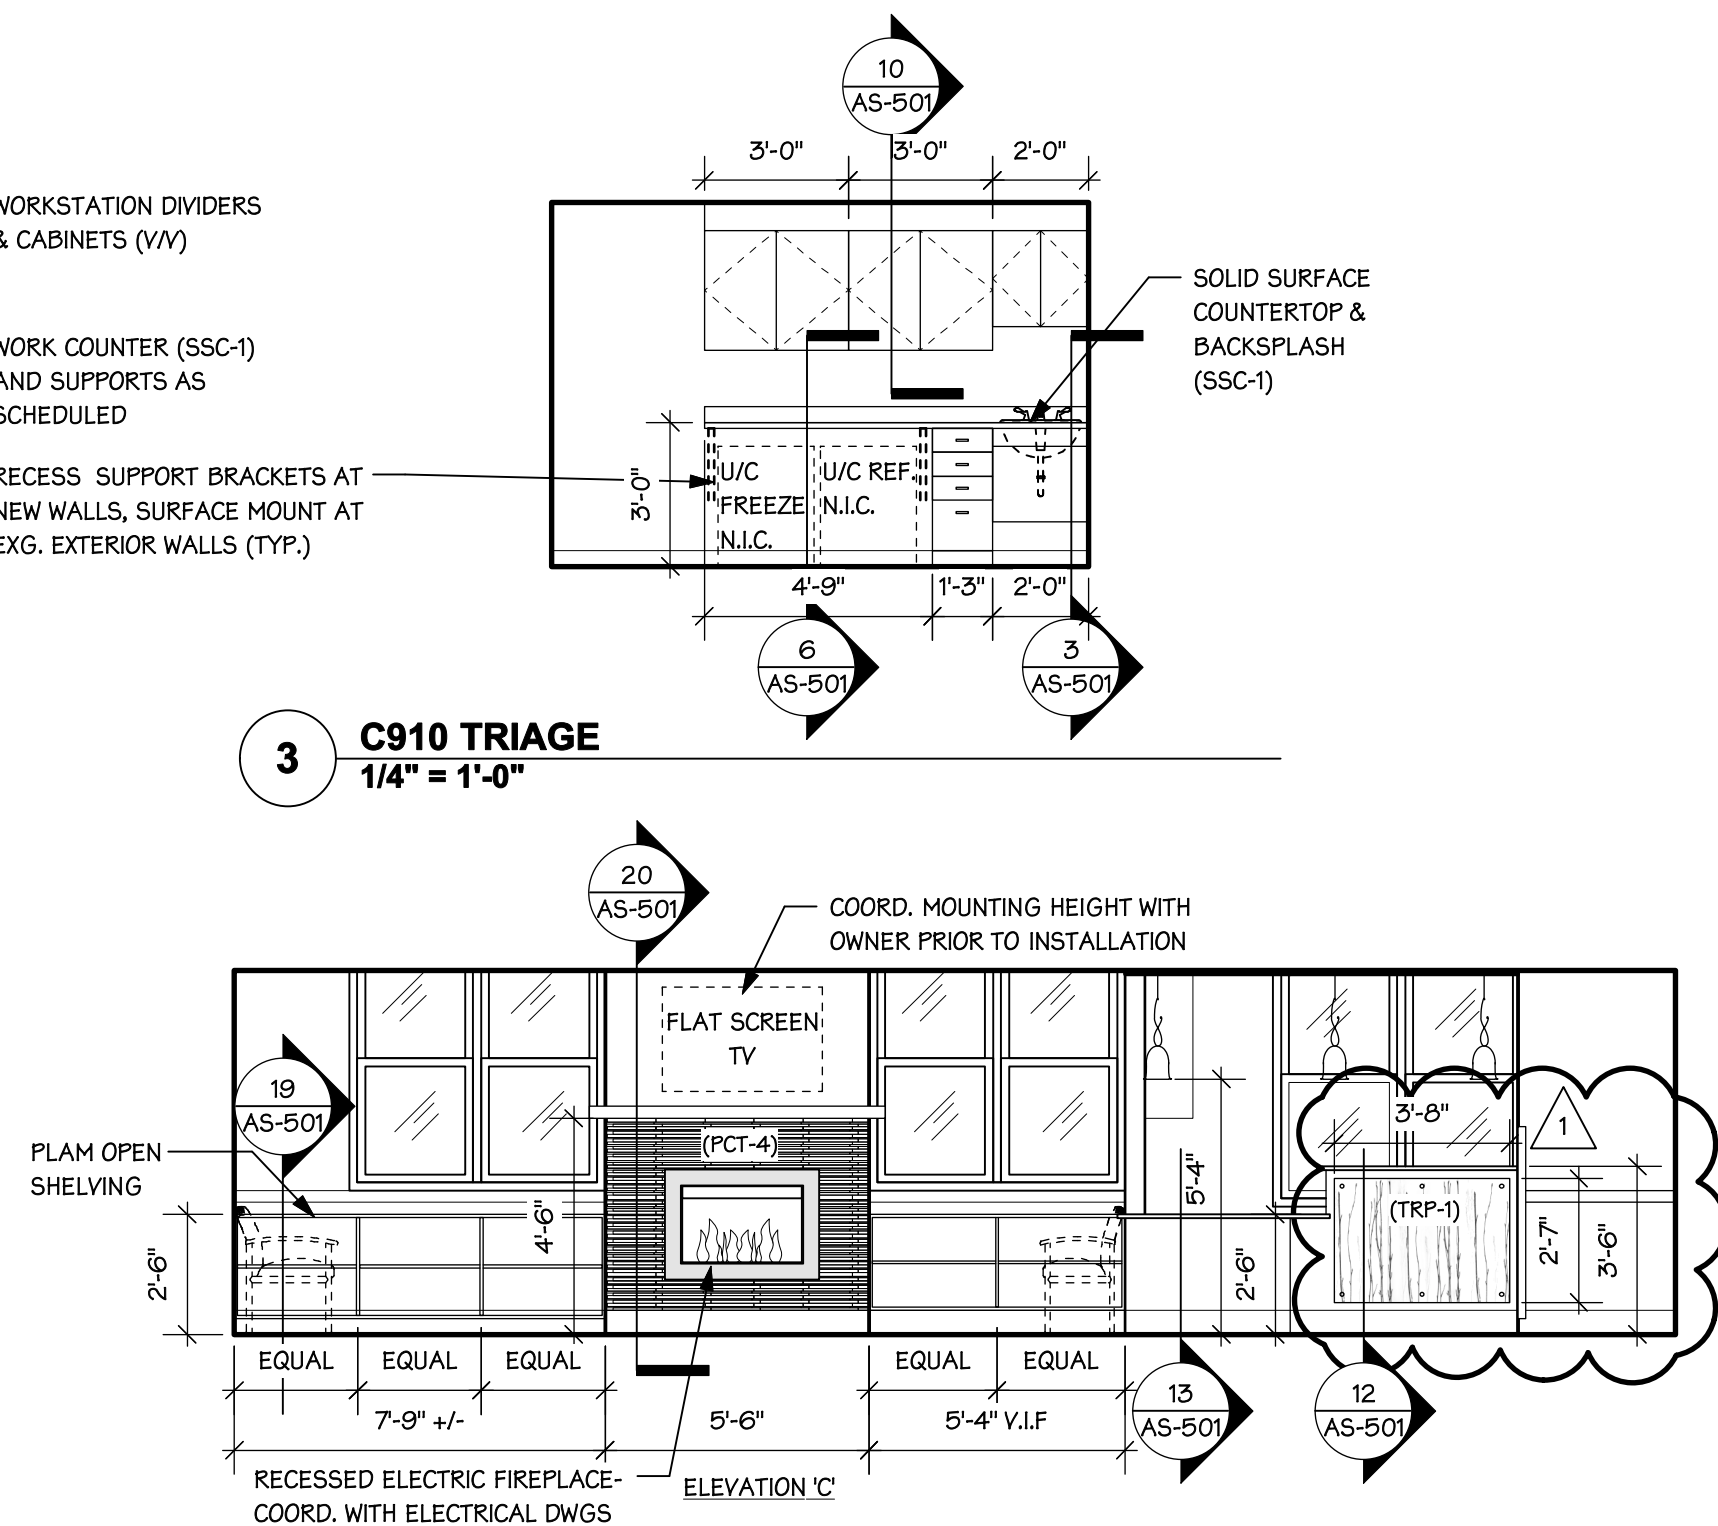

2 C904A RECEPTION
1/4" = 1'-0"

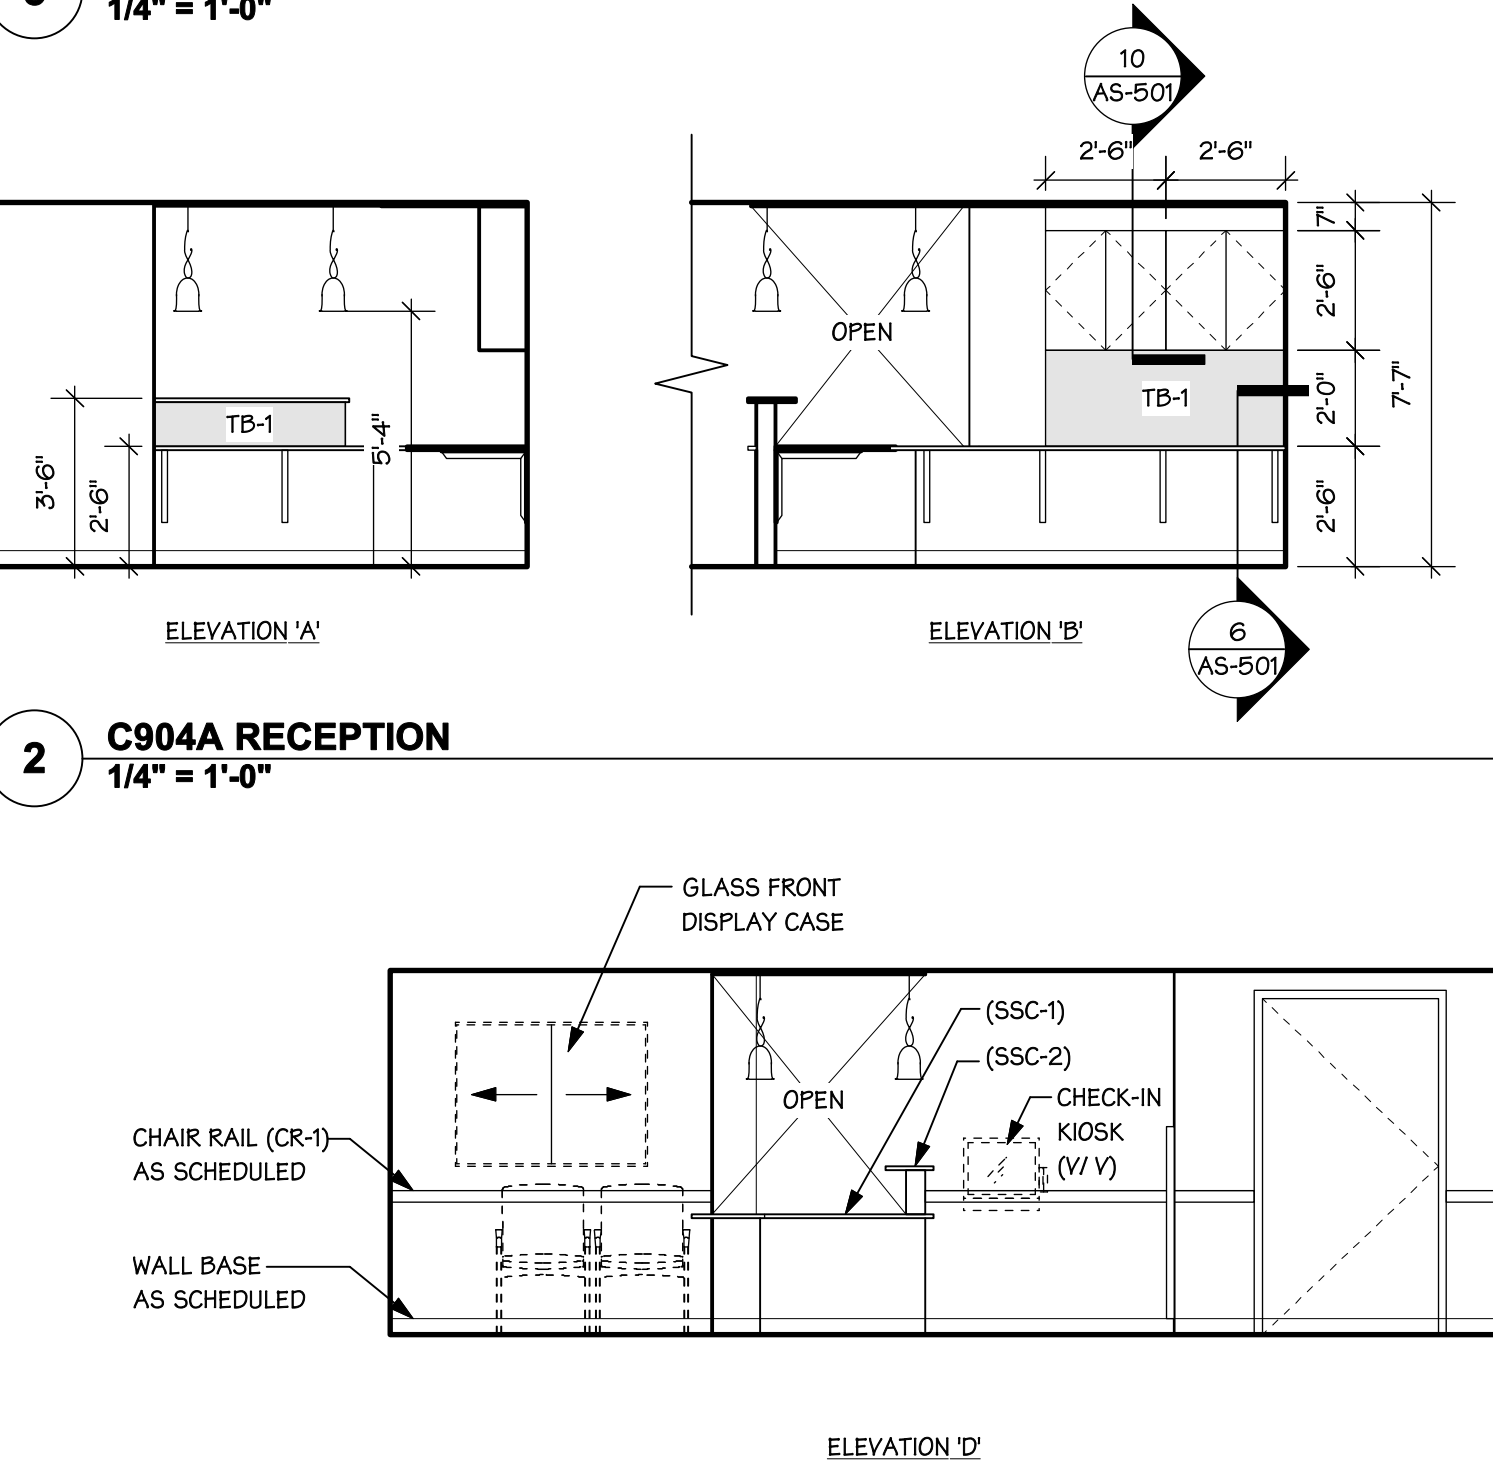

1 C904 WAITING ROOM
1/4" = 1'-0"

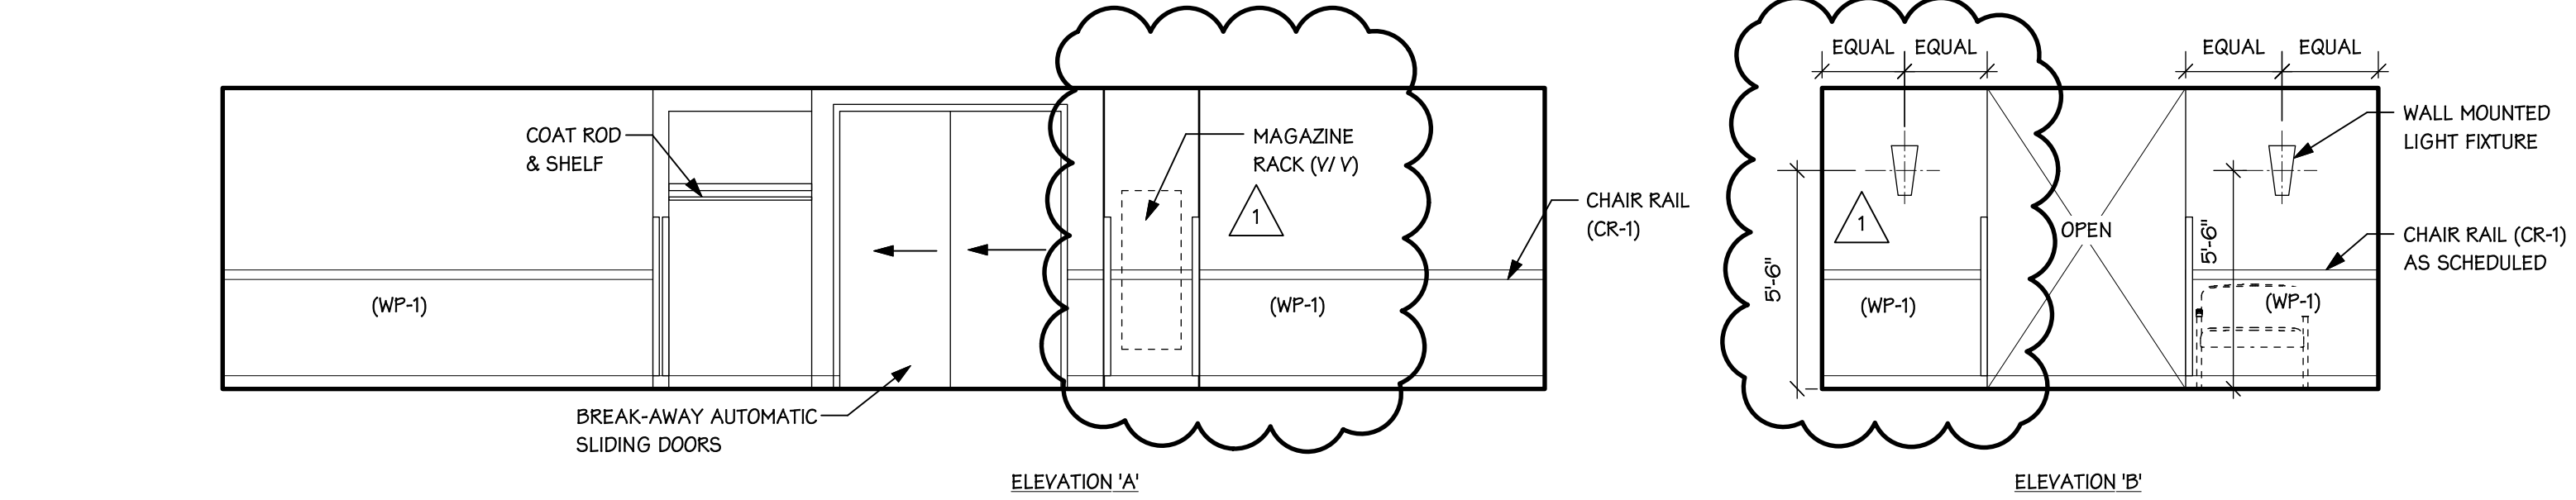

AMENDMENT NO. 2	02/08/2013
Revisions:	Date

CONSULTANTS:

ARCHITECT/ENGINEERS:

dwor
ARCHITECTURAL

SYRACUSE
313 East Willow Street
Suite 107
Syracuse, NY 13203
ph: 315.473.1800

ROCHESTER
1344 University Avenue
Suite 140
Rochester, NY 14607
ph: 585.461.4771

IPD: Engineering
INTEGRATED PROJECT DELIVERY
ONE WEBSTER'S LANDING
SYRACUSE, NEW YORK 13202
315.423.0185

Drawing Title
INTERIOR ELEVATIONS

Approved: Project Director

Project Title
RENOVATE FOR WOMEN'S CLINIC

Project Number
VA# 528A7-13-701
DA# 12-001
Building Number
1

Location
800 IRVING AVENUE, SYRACUSE NY 13210

Date
02.08.2013

Checked
KAD

Drawn
LMB

Drawing Number
AS-201

Dwg. 12 of 41

