FINISH LEGEND

FINISH	MANUFACTURER	STYLE	COLOR
ACOUSTICAL CEILING TILE			
ACT-1 (2X2)	ARMSTRONG	ULTIMA 1911	WHITE
ACT-2 (2X4)	ARMSTRONG	ULTIMA	WHITE
CHAIR RAIL			
CR-1 (3'-0" A.F.F.)	INPRO CORP.	2700W CHAIR RAIL W/ END CAPS- SMOOTH	#0545 CROWN CHERRY
CORNER GUARDS			
CG-1 (3" @ 4'-0" A.F.F.)	INPRO CORP.	TYPE 150BN	#0275 PYRAMID
CG-1 (2" @ 4'-0" A.F.F.)	INPRO CORP.	TYPE 160BN	#0275 PYRAMID
CUBICLE CURTAIN			
CC-1	INPRO SHIELD	TUDOR 54x87	SAND DUNE
HAND RAIL			
HR-1	INPRO CORP.	900W HAND RAIL W/ END CAPS- SMOOTH	#0545 CROWN CHERRY/ STAINLESS STEEL MOUNTING BRACKET
LUXURY VINYL TILE			
LVT-A (PATTERN)			
LVT-1 (FIELD)	ARMSTRONG	NATURAL CREATIONS ARBORART	#TP046 CERISIER MIEL
LVT-2 (ACCENT)	ARMSTRONG	NATURAL CREATIONS ARBORART	#TP049 CERISIER HEIRLOOM
PAINT			
PNT-1 (FIELD)	PPG PITTSBURGH PAINTS	EGGSHELL	#314-3 SAND FOSSIL
PNT-2 (ACCENT)	PPG PITTSBURGH PAINTS	EGGSHELL	#427-6 ROOT BEER
PNT-3 (ACCENT)	PPG PITTSBURGH PAINTS	EGGSHELL	#410-4 OLIVE SPRIG
PNT-4 (ACCENT)	PPG PITTSBURGH PAINTS	EGGSHELL	#542-6 SILVERADO
PNT-5 (DOOR FRAME)	PPG PITTSBURGH PAINTS	SEMIGLOSS	#415-5 WIND MILL
PNT-6 (CEILING)	PPG PITTSBURGH PAINTS	FLAT	CEILING WHITE
PLASTIC LAMINATE			
PL-1	WILSONART	-	#7959 HAMPTON WALNUT
PORCELAIN TILE			
PCT-1 (FLOOR FIELD)	DALTILE	DEL MONOCO 13x20, ALT. VERTICAL	#DM92 TATIANA NOCE
PCT-2 (WALL FIELD)	DALTILE	DEL MONOCO 13x20, ALT. VERTICAL	#DM90 CARMINA BEIGE
PCT-3 (WALL ACCENT)	DALTILE	CASTLE DE VERRE, 3x13 CV14	UNIVERSAL ACCENT BAND
PCT-4 (FIREPLACE WALL)	DALTILE	CITY VIEW- 9x18 RANDOM LINEAR BRICK JOINT	#CY01 HARBOUR MIST
PVC EDGEBANDING- 3MM			
PVC-1 (PL-1)	DOLLKEN-WOODTAPE	3MM	#3342S HAMPTON WALNUT
RUBBER BASE			
RB-1	JOHNSONITE	6" COVE BASE	#150 WETLANDS
RB-2	JOHNSONITE	6" MILLWORK REAVEAL MW-150-F6	#150 WETLANDS
SIGNAGE			
SGN-1 (ROOM SIGN)	2/ 90	IN-3.01/ IN-5.02 ROOM SIGN	#721 LINEN
SGN-2 (FLOOR DIRECTORY)	2/ 90	IN-17.05 FLOOR DIRECTORY SIGN	#721 LINEN
SHEET VINYL FLOORING (WELDED)			
SVF-1	JONSONITE	OPTIMA IQ HOMOGENEOUS	#821 FROTHY LATTE
SOLID SURFACE COUNTERTOP			
SSC-1	CORIAN	PRIVATE COLLECTION- REVERSE BEVEL EDGE	TUMBLEWEED
SSC-2	CORIAN	PRIVATE COLLECTION- REVERSE BEVEL EDGE	ROSEMARY
TACK BOARD			
TB-1	CARNEGIE PANELS	TURNTABLE 5196	#60
TRANSITION STRIPS			
TS-1	TBD	TBD	TBD
TRANSLUCENT RESIN PANELS			
TRP-1	3-FORM	ORGANICS	TRAIL FADE
VINYL ENHANCED TILE			
VET-1	JOHNSONITE	AZTERRA VET	#108 COPPER
WINDOW TREATMENT			
WT-1	MECHO SYSTEMS ROLLER SHADE	THERMOVEIL DENSE VERTICAL WEAVE, 1000 SERIES	#1002 BEIGE
WALL PROTECTION			
WP-1	INPRO CORP.	3'-0" A.F.F.	#0239 OATMEAL
WOOD STAIN			
WS-1	SHERWIN WILLIAMS	SEMI-TRANSPARENT	COLOR TO MATCH PL-1

FINISH SCHEDULE

ROOM NUMBER	ROOM NAME	FLOOR FINISH	BASE FINISH	NORTH WALL FINISH	EAST WALL FINISH	SOUTH WALL FINISH	WEST WALL FINISH	CEILING FINISH	CEILING HEIGHT	REMARKS
900	CORRIDOR	ETR	ETR	PNT-1	PNT-1	PNT-1	PNT-1	ETR	7'-0"	(6)
C900	OFFICE	VET-1	RB-1	PNT-1	PNT-1	PNT-3	PNT-3	ACT-1	7'-0"	
C902	LACTATION ROOM	LVT-1	RB-1	PNT-1	PNT-1	PNT-1	PNT-1	ACT-1	7'-0"	
C903	FAMILY TOILET	PCT-1	PCT-2	PCT-2/ PCT-3	PCT-2/ PCT-3	PCT-2/ PCT-3	PCT-2/ PCT-3	ACT-1	7'-0"	(3)
C904	WAITING ROOM	LVT-A	RB-2	PNT-A/ CR-1/ WP-1	PNT-A/ CR-1/ WP-1	PNT-A/ CR-1/ WP-1	PNT-A/ CR-1/ WP-1	ACT-1	7'-0"	(1)(4)(5)
C904A	RECEPTION	LVT-1	RB-1	PNT-1	PNT-1	PNT-3	PNT-4	ACT-1	7'-0"	(5)
C905	CORRIDOR	LVT-A	RB-2	PNT-1/ WP-1	PNT-1/ HR-1/ WP-1	PNT-1/ WP-1	PNT-1/ HR-1/ WP-1	ACT-1	7'-0"	(1)(4)
C906	CORRIDOR	LVT-1	RB-2	-	PNT-1/ WP-1	PNT-1/ WP-1	-	ACT-1	7'-0"	(1)(5)
C906A	EQUIPMENT ALCOVE	LVT-1	RB-2	PNT-1/ WP-1	PNT-1/ WP-1	-	PNT-1/ WP-1	GWB	7'0"	(1)
C910	TRIAGE	VET-1	RB-1	PNT-1	PNT-3	PNT-1	PNT-1	ACT-1	7'-0"	(5)
C911	EXAM ROOM #1	VET-1	RB-1	PNT-2	PNT-1	PNT-1	PNT-1	ACT-1	7'-0"	(5)
C912	SHARED DOCUMENTATION ROOM	LVT-1	RB-1	PNT-1	PNT-1	PNT-3	PNT-1	ACT-1	7'-0"	(5)
C913	OFFICE	VET-1	RB-1	PNT-1	PNT-1	PNT-3	PNT-1	ACT-1	7'-0"	(5)
C914	CONSULTATION	VET-1	RB-1	PNT-1	PNT-1	PNT-4	PNT-1	ACT-1	7'-0"	(5)
C915	EXAM ROOM #2	VET-1	RB-1	PNT-3	PNT-1	PNT-1	PNT-1	ACT-1	7'-0"	(5)
C916	SOILED HOLDING	SVF-1	INTGL	PNT-1/ WP-1	PNT-1/ WP-1	PNT-1/ WP-1	PNT-1/ WP-1	ACT-2	7'-0"	(1)
C917	EXAM ROOM #3	VET-1	RB-1	PNT-1	PNT-1	PNT-4	PNT-1	ACT-1	7'-0"	(5)
C918	CLEAN HOLDING	SVF-1	INTGL	PNT-1/ WP-1	PNT-1/ WP-1	PNT-1/ WP-1	PNT-1/ WP-1	ACT-2	7'-0"	(1)
C919	PATIENT TOILET	PCT-1	PCT-2	PCT-2/ PCT-3	PCT-2/ PCT-3	PCT-2/ PCT-3	PCT-2/ PCT-3	ACT-1	7'-0"	(3)
C920	EXAM ROOM #4	VET-1	RB-1	PNT-3	PNT-1	PNT-1	PNT-1	ACT-1	7'-0"	(5)
C921	TELEHEALTH/ PROCEDURE ROOM #1	SVF-1	INTGL	PNT-1/ WP-1	PNT-1/ WP-1	PNT-1/ WP-1	PNT-2/ WP-1	ACT-1	7'-0"	(1)(5)
C921A	PATIENT TOILET	PCT-1	PCT-2	PNT-1/ PCT-2	PNT-1/ PCT-2	PNT-1/ PCT-2	PNT-1/ PCT-2	ACT-1	7'-0"	(2)
C922	EXAM ROOM #5	VET-1	RB-1	PNT-1	PNT-1	PNT-2	PNT-1	ACT-1	7'-0"	(5)
C923	PROCEDURE ROOM #2	SVF-1	INTGL	PNT-1/ WP-1	PNT-1/ WP-1	PNT-1/ WP-1	PNT-2/ WP-1	ACT-1	7'-0"	(1)(5)
C923A	PATIENT TOILET	PCT-1	PCT-2	PNT-1/ PCT-2	PNT-1/ PCT-2	PNT-1/ PCT-2	PNT-1/ PCT-2	ACT-1	7'-0"	(2)
C924	MULTIPURPOSE ROOM	VET-1	RB-1	PNT-4	PNT-1	PNT-1	PNT-1	ACT-1	7'-0"	(5)
C925	CLOSET	VET-1	RB-1	PNT-1	PNT-1	PNT-1	PNT-1	GWB	7'-3"	
C926	STAFF TOILET	PCT-1	PCT-2	PNT-1/ PCT-2	PNT-1/ PCT-2	PNT-1/ PCT-2	PNT-1/ PCT-2	ACT-1	7'-3"	(2)

KEYED NOTES

(1) WALL PROTECTION (WP-1) IN THIS ROOM COMPLETE @ 3'-0" A.F.F. SEE SHEET AS-201 FOR INTERIOR ELEVATIONS.
(2) PCT-2 WAINSCOT. REFER TO SHEET AS-401 FOR TOILET ROOM ELEVATIONS.
(3) PCT-2 FULL HEIGHT W/ PCT-3 ACCENT. REFER TO SHEET AS-401 FOR TOILET ROOM ELEVATIONS.
(4) REFER TO SHEET AS-701 FOR FLOOR FINISH PATTERNS.
(5) REFER TO SHEET AS-701 FOR ACCENT PAINT LOCATIONS.
(6) REFER TO SHEET GI-201 FOR BID OPTION NO.1 FLOORING REPLACEMENT.

FINISH SCHEDULE GENERAL NOTES

1. NOTIFY ARCHITECT OF ANY DISCREPANCIES BETWEEN SCHEDULE AND DRAWINGS FOR CLARIFICATION.
2. REFER TO FLOOR PLANS FOR PROJECT NORTH WHEN REFERENCING FINISH SCHEDULE.
3. ALL CHANGES IN FLOORING FROM EXISTING TO NEW, OR NEW TO NEW REQUIRE A TRANSITION STRIP. TRANSITION STRIP TO BE LOCATED UNDERSIDE OF CLOSED DOOR, NOT DOOR FRAME.
4. ALL HM DOOR & WINDOW FRAMES TO BE PAINTED PNT-5.
5. REFER TO SHEET AS-701 FOR FINISH PLAN IN ROOMS SCHEDULED TO RECEIVE FLOOR PATTERNS AND ACCENT PAINT LOCATIONS.
6. REFER TO REFLECTED CEILING PLANS AS-102 FOR ACT/ GWB SOFFIT LOCATIONS, PAINT COLORS, AND ELEVATION VARIATIONS.
7. REFER TO SHEET AS-201 INTERIOR ELEVATIONS FOR CASEWORK ELEVATIONS AND COUNTERTOP FINISHES.
8. PROVIDE 6" WALL BASE AS SCHEDULED ON ALL WALLS AND CASEWORK. COORDINATE WITH TOE-KICKS AT CABINETRY.
9. ALL TOILET ROOMS TO RECEIVE EPOXY PAINT FINISH .
10. ALL WALLS TO HAVE EGGSHELL PAINT FINISH UNLESS OTHERWISE NOTED.
11. REFER TO SHEET AS-701 FOR CORNER GUARD LOCATIONS.
12. ALL SOLID SURFACE EDGES TO BE REVERSE BEVEL. REFER TO SHEET AS-501 FOR MILLWORK DETAILS.

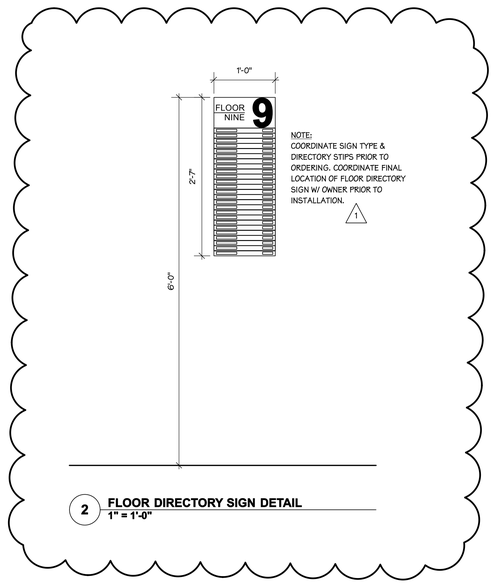

2 **FLOOR DIRECTORY SIGN DETAIL**
1" = 1'-0"

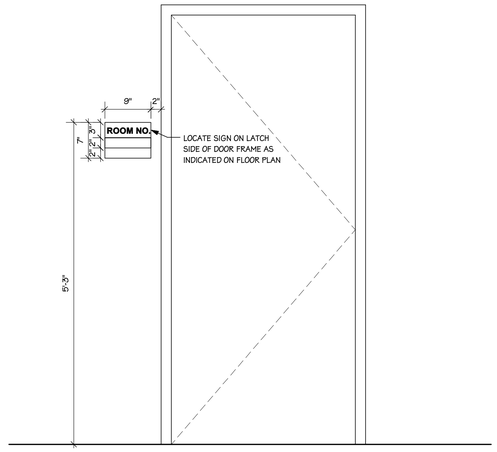

1 **TYPICAL ROOM SIGN DETAIL**
1" = 1'-0"

Scale: As Noted

AMENDMENT NO. 2	02/08/2013
Revisions:	Date

CONSULTANTS:

ARCHITECT/ENGINEERS:

dwyer ARCHITECTURAL

SYRACUSE
313 East Willow Street
Suite 107
Syracuse, NY 13203
ph: 315.473.1800

ROCHESTER
1344 University Avenue
Suite 140
Rochester, NY 14607
ph: 585.461.4771

IPD: Engineering
INTEGRATED PROJECT DELIVERY
ONE WEBSTER'S LANDING
SYRACUSE, NEW YORK 13202
315.423.0155

Drawing Title: FINISH SCHEDULE, NOTES & DETAILS

Approved: Project Director

Project Title: RENOVATE FOR WOMEN'S CLINIC

Location: 800 IRVING AVENUE, SYRACUSE NY 13210

Date: 02.08.2013 | Checked: KAD | Drawn: LMB

Project Number: VA# 528A7-13-701 DA# 12-001

Building Number: 1

Drawing Number: AS-602

Dwg. 16 of 41

VA HEALTHCARE NETWORK UPSTATE NEW YORK

VA FORM 08-6231