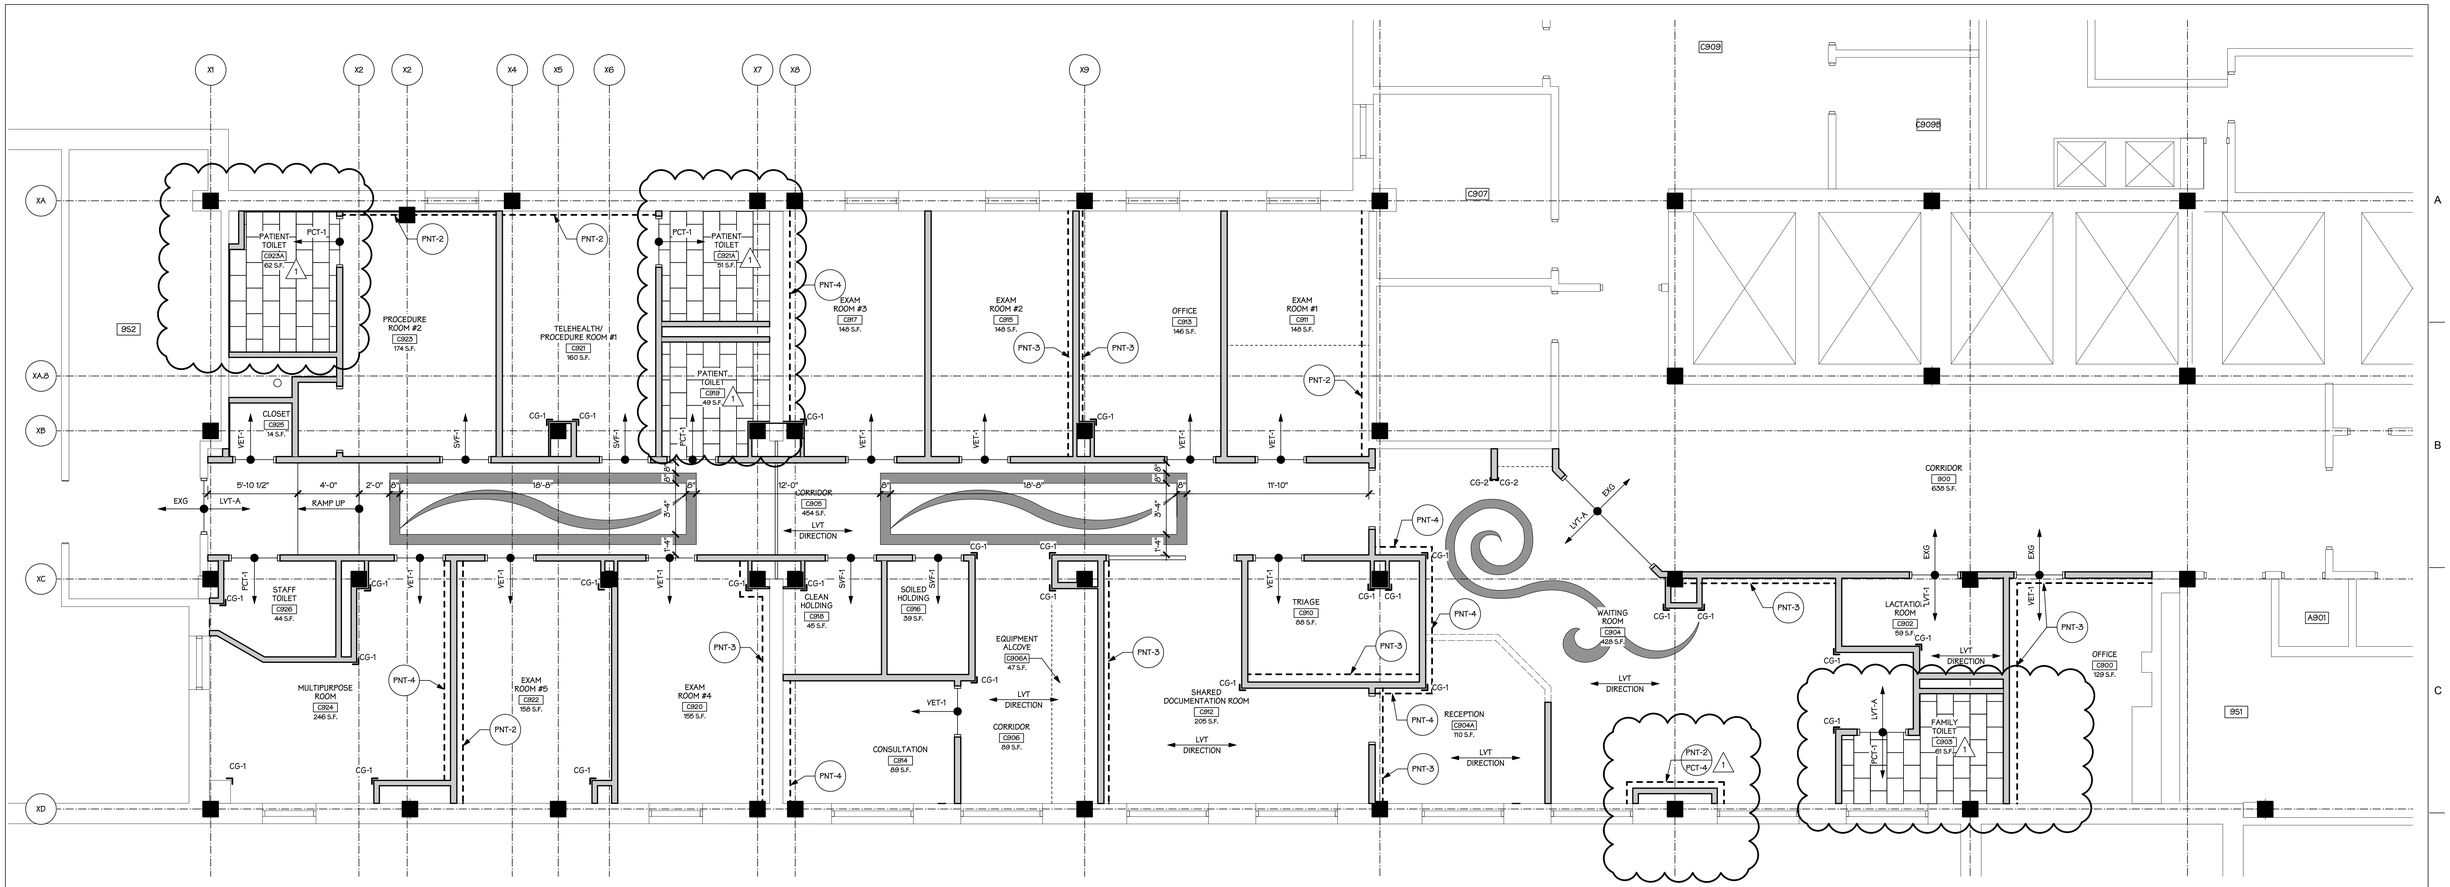

1 **FLOOR FINISH PLAN**
Scale: 1/4" = 1'-0"

NORTH

GENERAL NOTES

1. NOTIFY ARCHITECT OF ANY DISCREPANCIES BETWEEN SCHEDULE AND DRAWINGS FOR CLARIFICATION.
2. ▒▒▒▒▒▒▒▒ INDICATES LVT-2 FLOOR PATTERN.

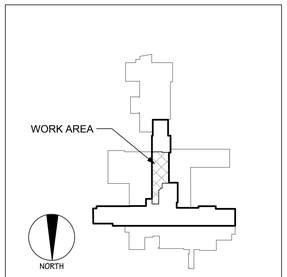

KEY PLAN- 9TH FLOOR

Scale: As Noted

⚠ AMENDMENT NO. 2	02/08/2013
Revisions:	Date

CONSULTANTS:

ARCHITECT/ENGINEERS:

dwyer ARCHITECTURAL

SYRACUSE
313 East Willow Street
Suite 107
Syracuse, NY 13203
ph: 315.473.1800

ROCHESTER
1344 University Avenue
Suite 140
Rochester, NY 14607
ph: 585.461.4771

IPD: Engineering
INTEGRATED PROJECT DELIVERY
ONE WEBSTER'S LANDING
SYRACUSE, NEW YORK 13202
315.423.0185

Drawing Title
FLOOR FINISH PLAN & NOTES

Approved: Project Director

Project Title
RENOVATE FOR WOMEN'S CLINIC

Location
800 IRVING AVENUE, SYRACUSE NY 13210

Date	Checked	Drawn
02.08.2013	KAD	LMB

Project Number
VA# 528A7-13-701
DA# 12-001

Building Number
1

Drawing Number
AS-701
Dwg. 17 of 41

VA HEALTHCARE NETWORK UPSTATE NEW YORK

VA FORM 08-6231