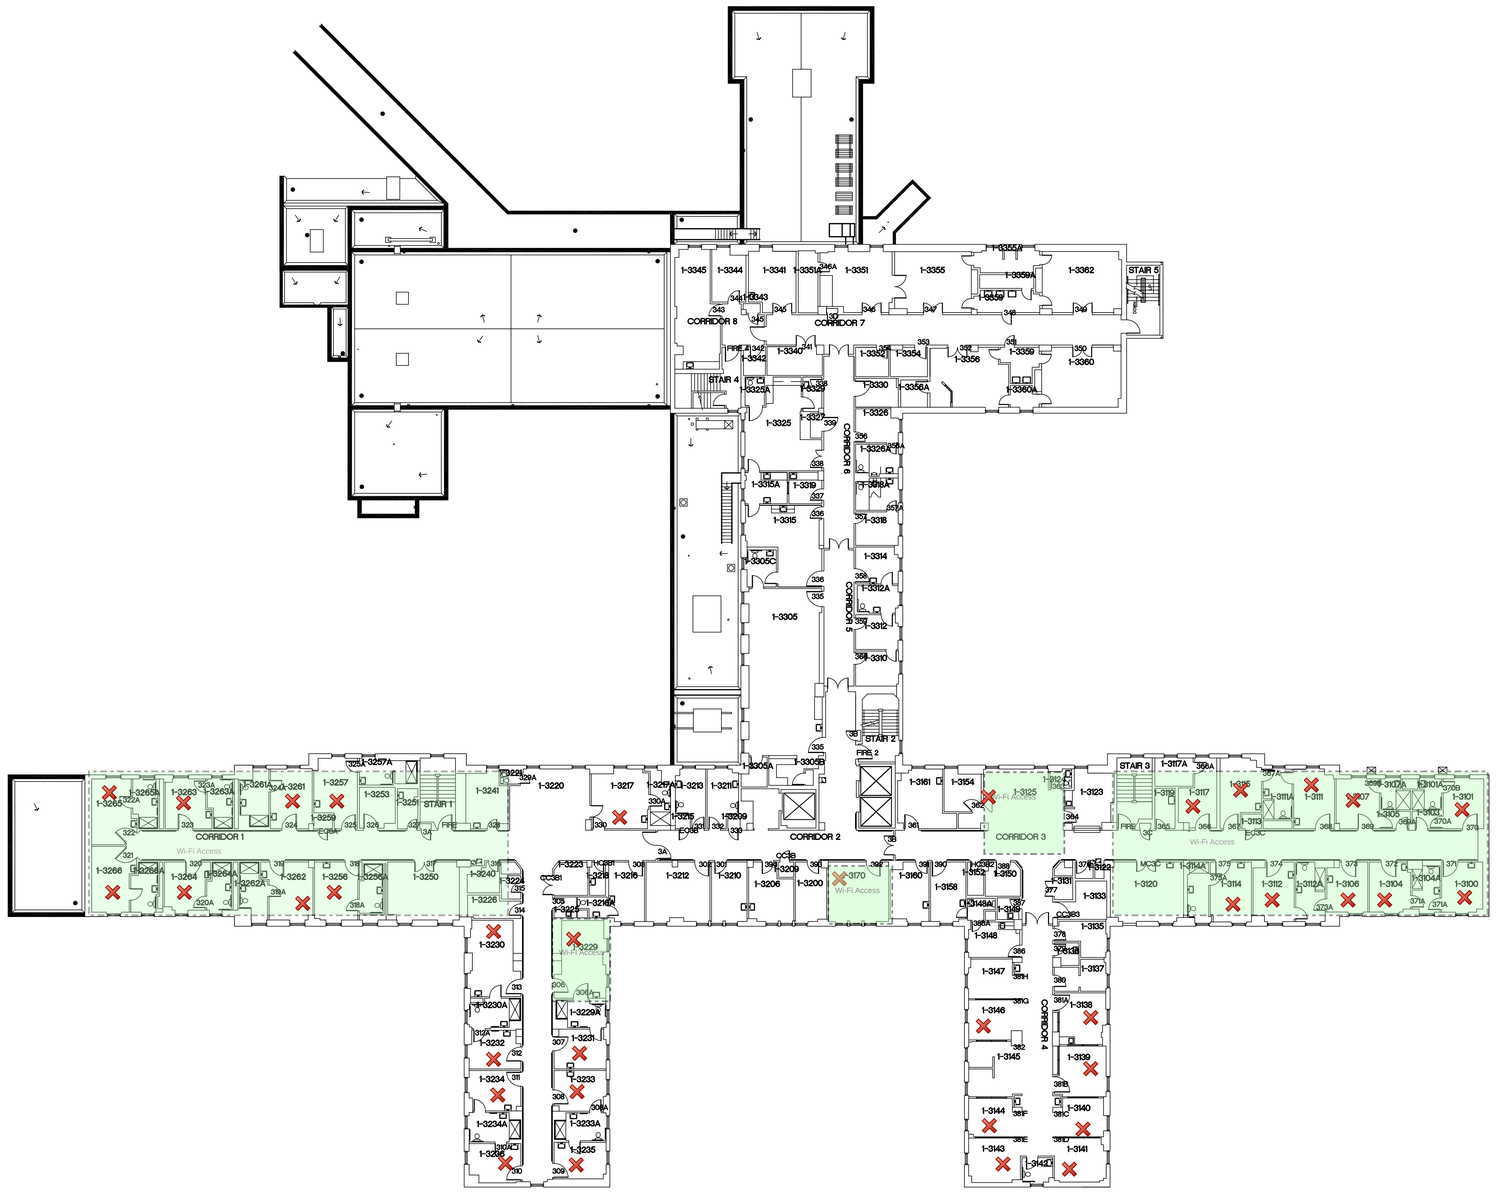

NORTH

Revisions	Date

CONSULTANTS:

Department of Veterans Affairs
Aleda E Lutz Medical Center
1500 Weiss Street
Saginaw, MI 48602

Property of the United States Government
For Official Use Only
Do not remove this notice
Properly Destroy documents when no longer needed

File Name: 65507111_3A-FPF1XX

File Location: V:\FACILITIES\Engineering\060309 Facility Floor Plans\Building 1

Drawing Title: THIRD FLOOR PLAN

Approved: Director Facilities Management Service

Approved: Medical Center Director

Project Title:

Project No.

Date: 4-2-12 **Checked:** **Drawn:**

Scale: 1/16" = 1'-0"

Building Number: BUILDING 1

Drawing Number: Dwg. of —

Office of Facilities Management

Department of Veterans Affairs

VA FORM 08-6231, OCT 1978