


GRAVEL PAD TO EXTEND A MINIMUM  
OF 8' HORIZONTALLY FROM  
OUTSIDE PORTABLE BUILDING FACE  
AS INDICATED.  
PROVIDE AROUND HOLDING TANK  
AREAS ALSO.  
HYDROSEED DISTURBED AREAS NOT  
COVERED BY CONCRETE OR  
GRAVEL.

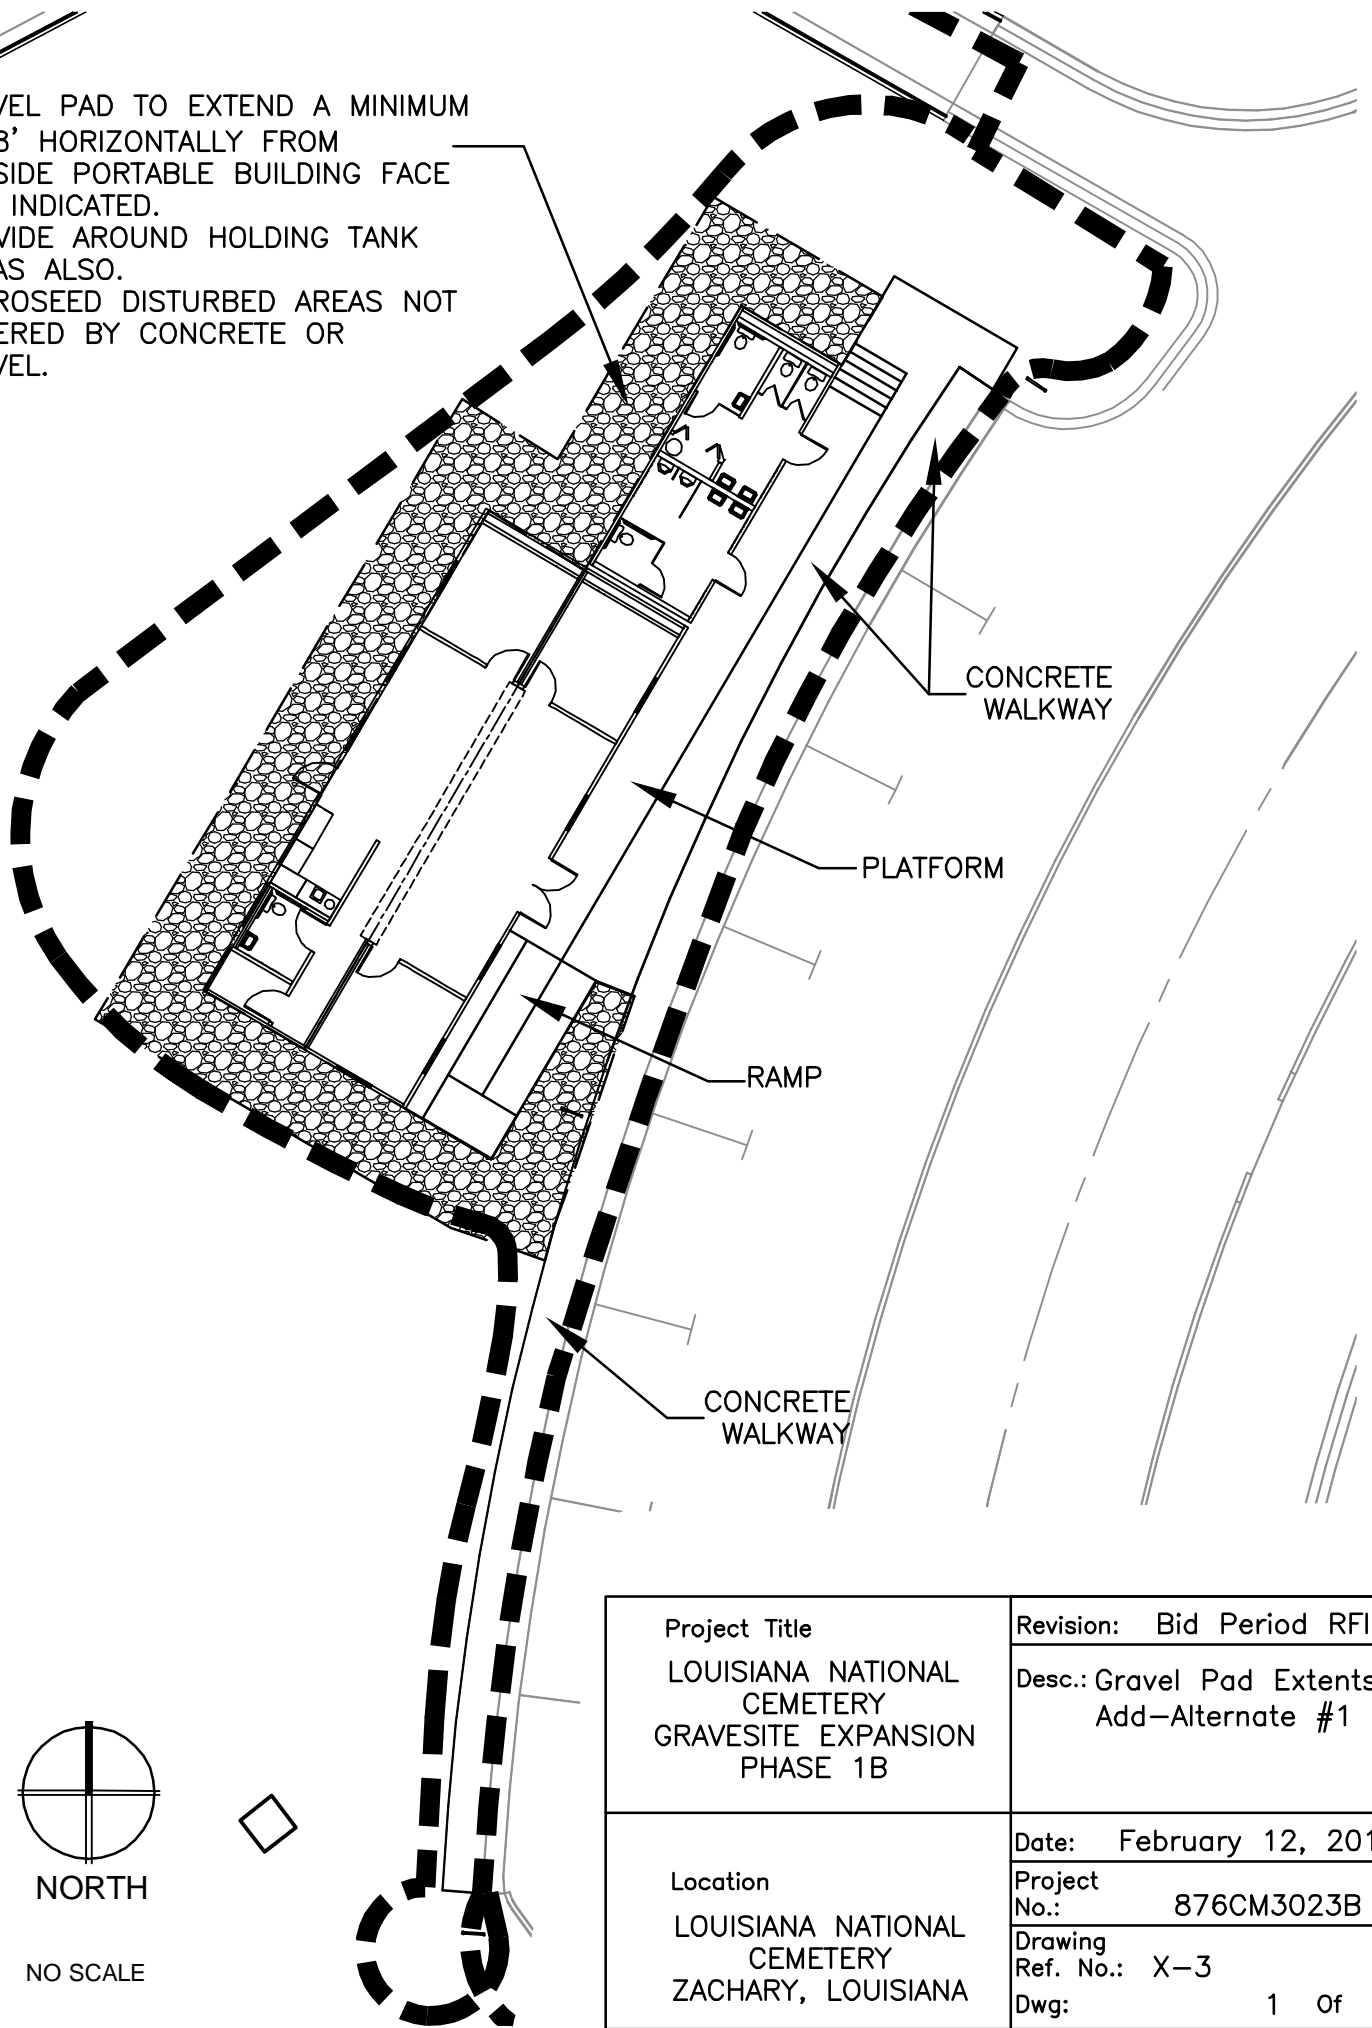

NO SCALE

|   |   |
|---|---|
| Project Title<br>LOUISIANA NATIONAL CEMETERY<br>GRAVESITE EXPANSION<br>PHASE 1B | Revision: Bid Period RFI                      |
|   | Desc.: Gravel Pad Extents<br>Add-Alternate #1 |
| Location<br>LOUISIANA NATIONAL CEMETERY<br>ZACHARY, LOUISIANA                   | Date: February 12, 2013                       |
|   | Project No.: 876CM3023B                       |
|   | Drawing Ref. No.: X-3                         |
|   | Dwg: 1 of 1                                   |