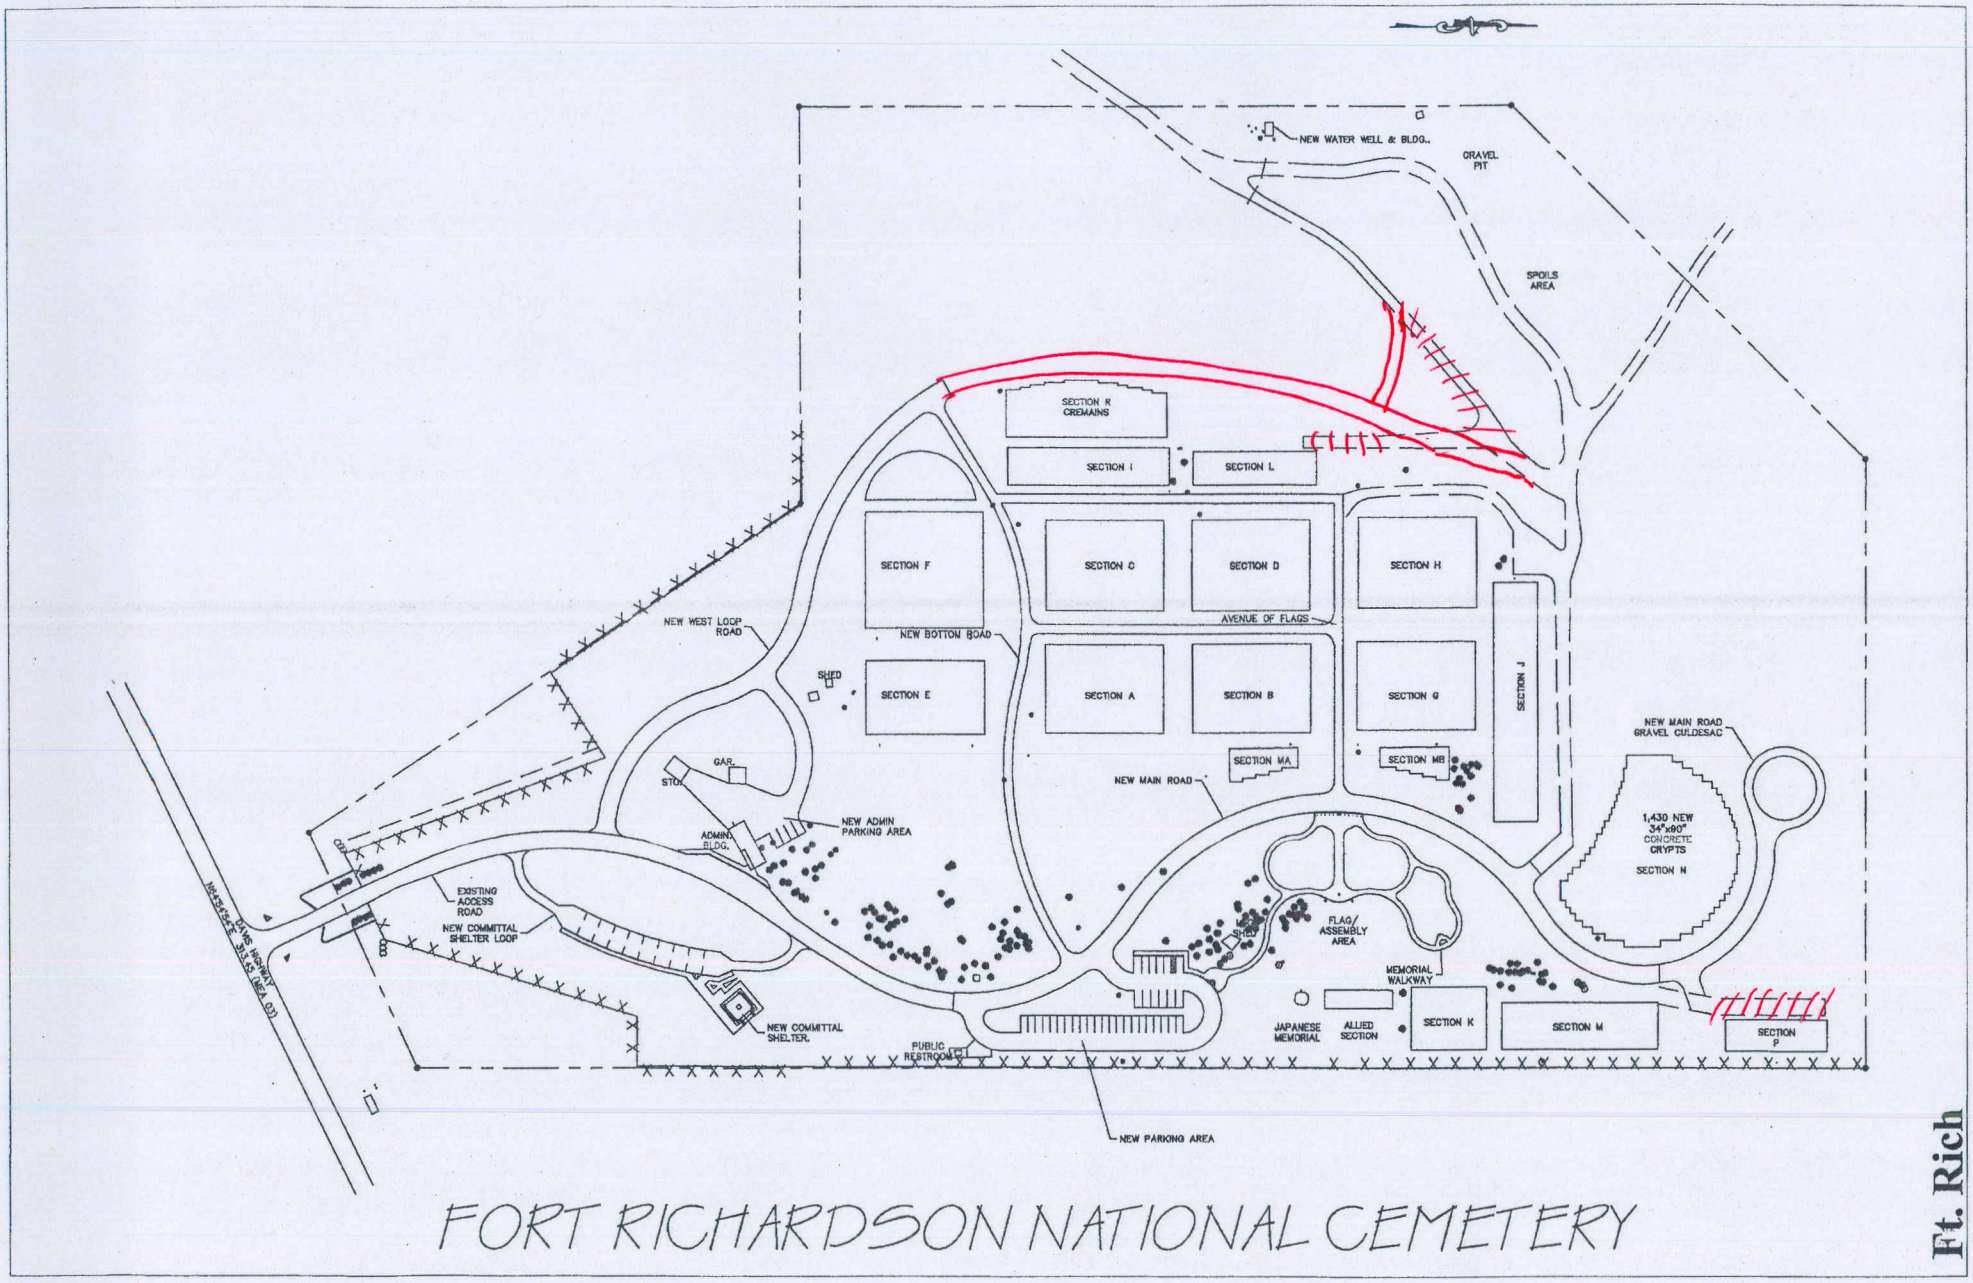

FORT RICHARDSON NATIONAL CEMETERY

Ft. Rich