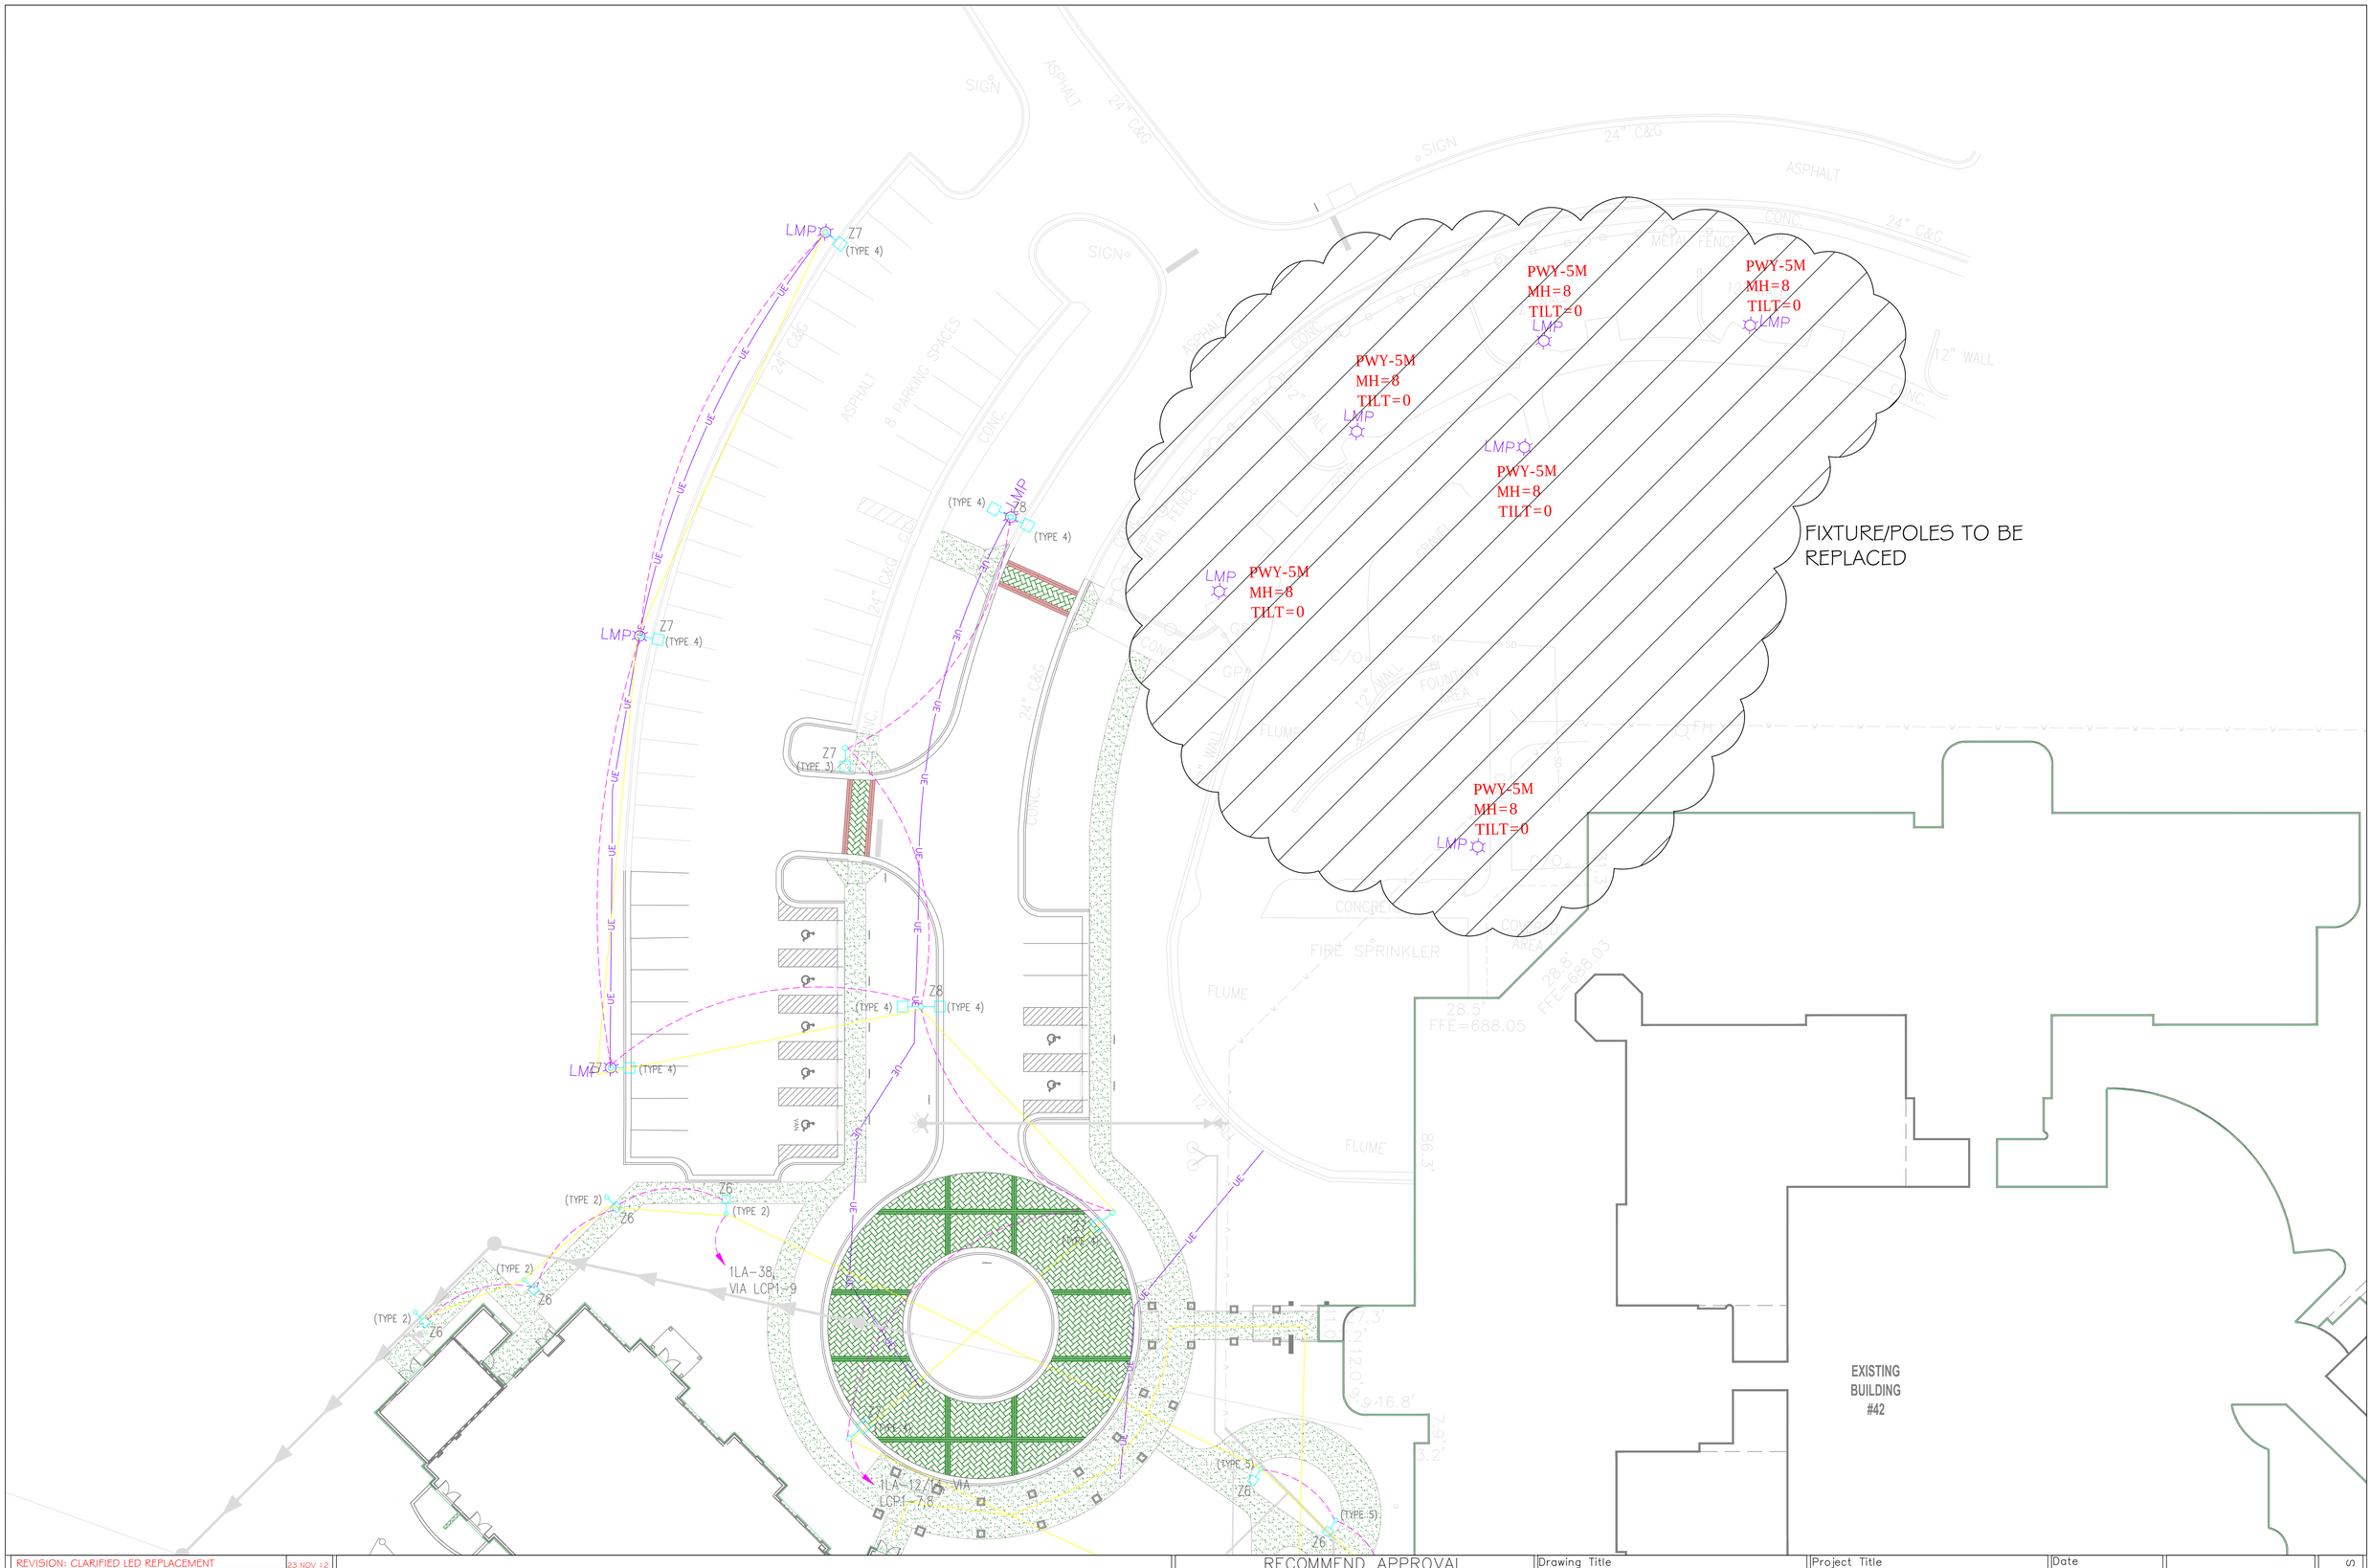

Revision	Date
REVISION: CLARIFIED LED REPLACEMENT	23 NOV 12
REVISION: CLARIFIED LED FIXTURES	03 DEC 12

RECOMMEND APPROVAL

REQUESTER	Date		
CHIEF OF SERVICE	Date	CHIEF OF STAFF	Date
ASSOC. DIR. PATIENT CARE SVC.	Date	ASSOC. DIR. for OPERATIONS	Date
APPROVAL BY: MEDICAL CENTER DIRECTOR			Date

Drawing Title
BLDG 42 LIGHTING

Project Title
REPLACE EXTERIOR LIGHTING WITH LED LIGHTS

Date
14 NOV 2012

Project No.
659-13-107

Approved: Safety Manager/M&O Supervisor

Approved: Chief of Facilities Management Svr.

Building Number
BUILDING #43

Checked

Drawn
BLF

Location
W.G.(Bill) Hefner Medical Center
1601 Brenner Ave.
Salisbury NC 28144

DRAWING NO.
E-201

DWG. 7 OF 8

Department of Veterans Affairs