ATTACHMENT 'A'

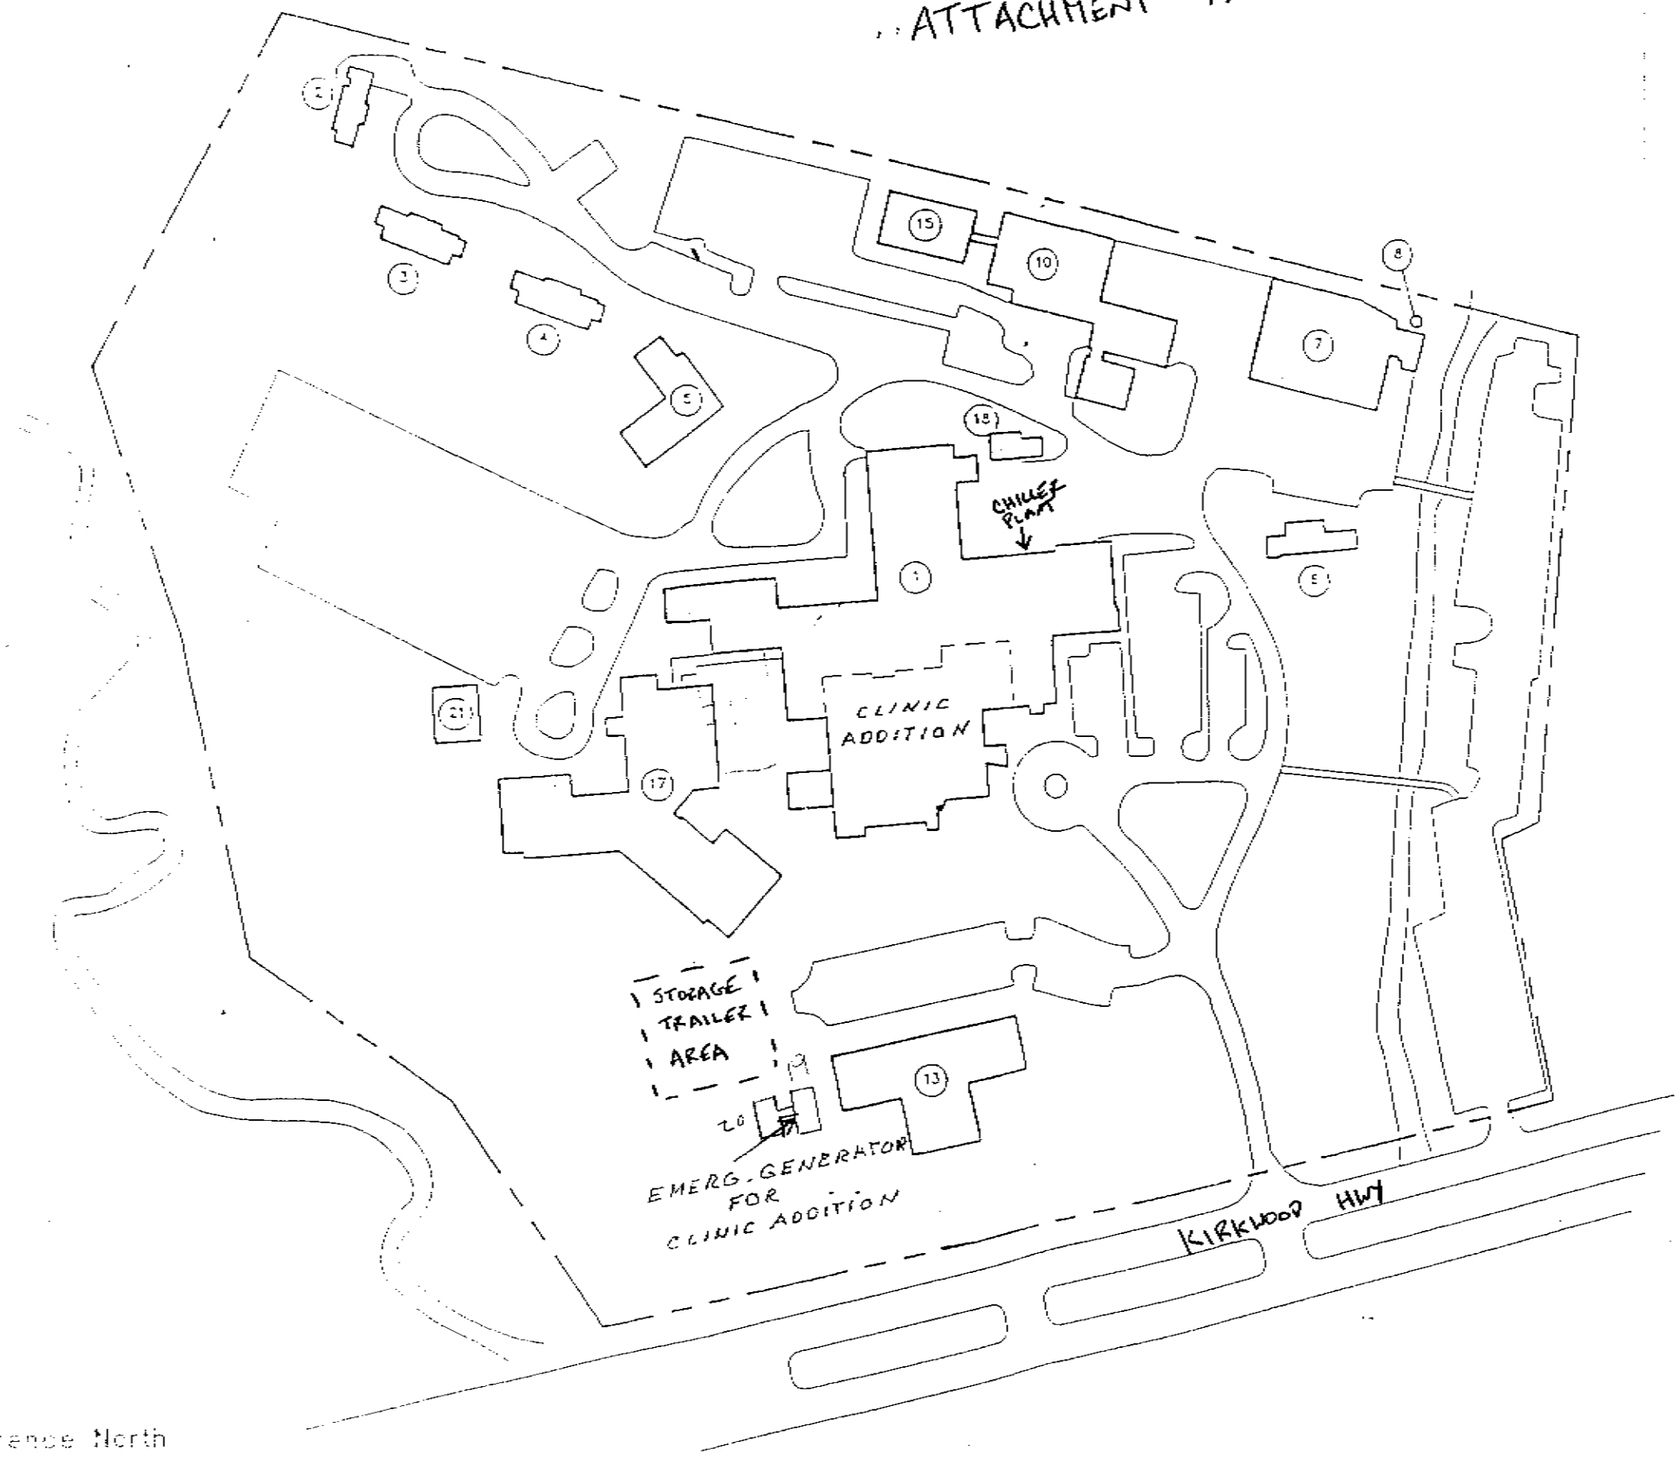

Site Plan

Not to Scale