NOTES AND MEASURES

- REMOVE AND REPLACE SIDEWALK CURB AND GUTTER IN THE IDENTIFIED AREAS PER APPLICABLE DETAILS. A CALL-OUT WITH DESIGNATION SX INDICATES SIDEWALK, A CX CALL-OUT AND BOLD LINE DESIGNATES CURB AND GUTTER.
- REVISION CLOUD INICATES NEW HANDICAP ACCESSIBLE RAMP WITH TACTILE STRIP AS SHOWN ON DETAIL SHEET SW-04
- UNIT MEASURES OF WORK LOCATIONS ARE AS LISTED BELOW.

SIDEWALK REPAIRS

CALL-OUT	UNIT MEASURE (SQFT)
S1	300
S2	250
S3	200
S4	250
S5	270
S6	1750
S7	1100
S8	700
S9	750
S10	1400
S11	2700
S12	1950
S13	2900
S14	1700
S15	100
S16	300
S17	100
S18	290

CURB REPAIRS

CALL-OUT	UNIT MEASURE (LF)
C1	35
C2	15
C3	80
C4	40
C5	55
C6	260
C7	55
C8	230
C9	2725
C10	200
C11	250
C12	15

REVISED 2/26/13

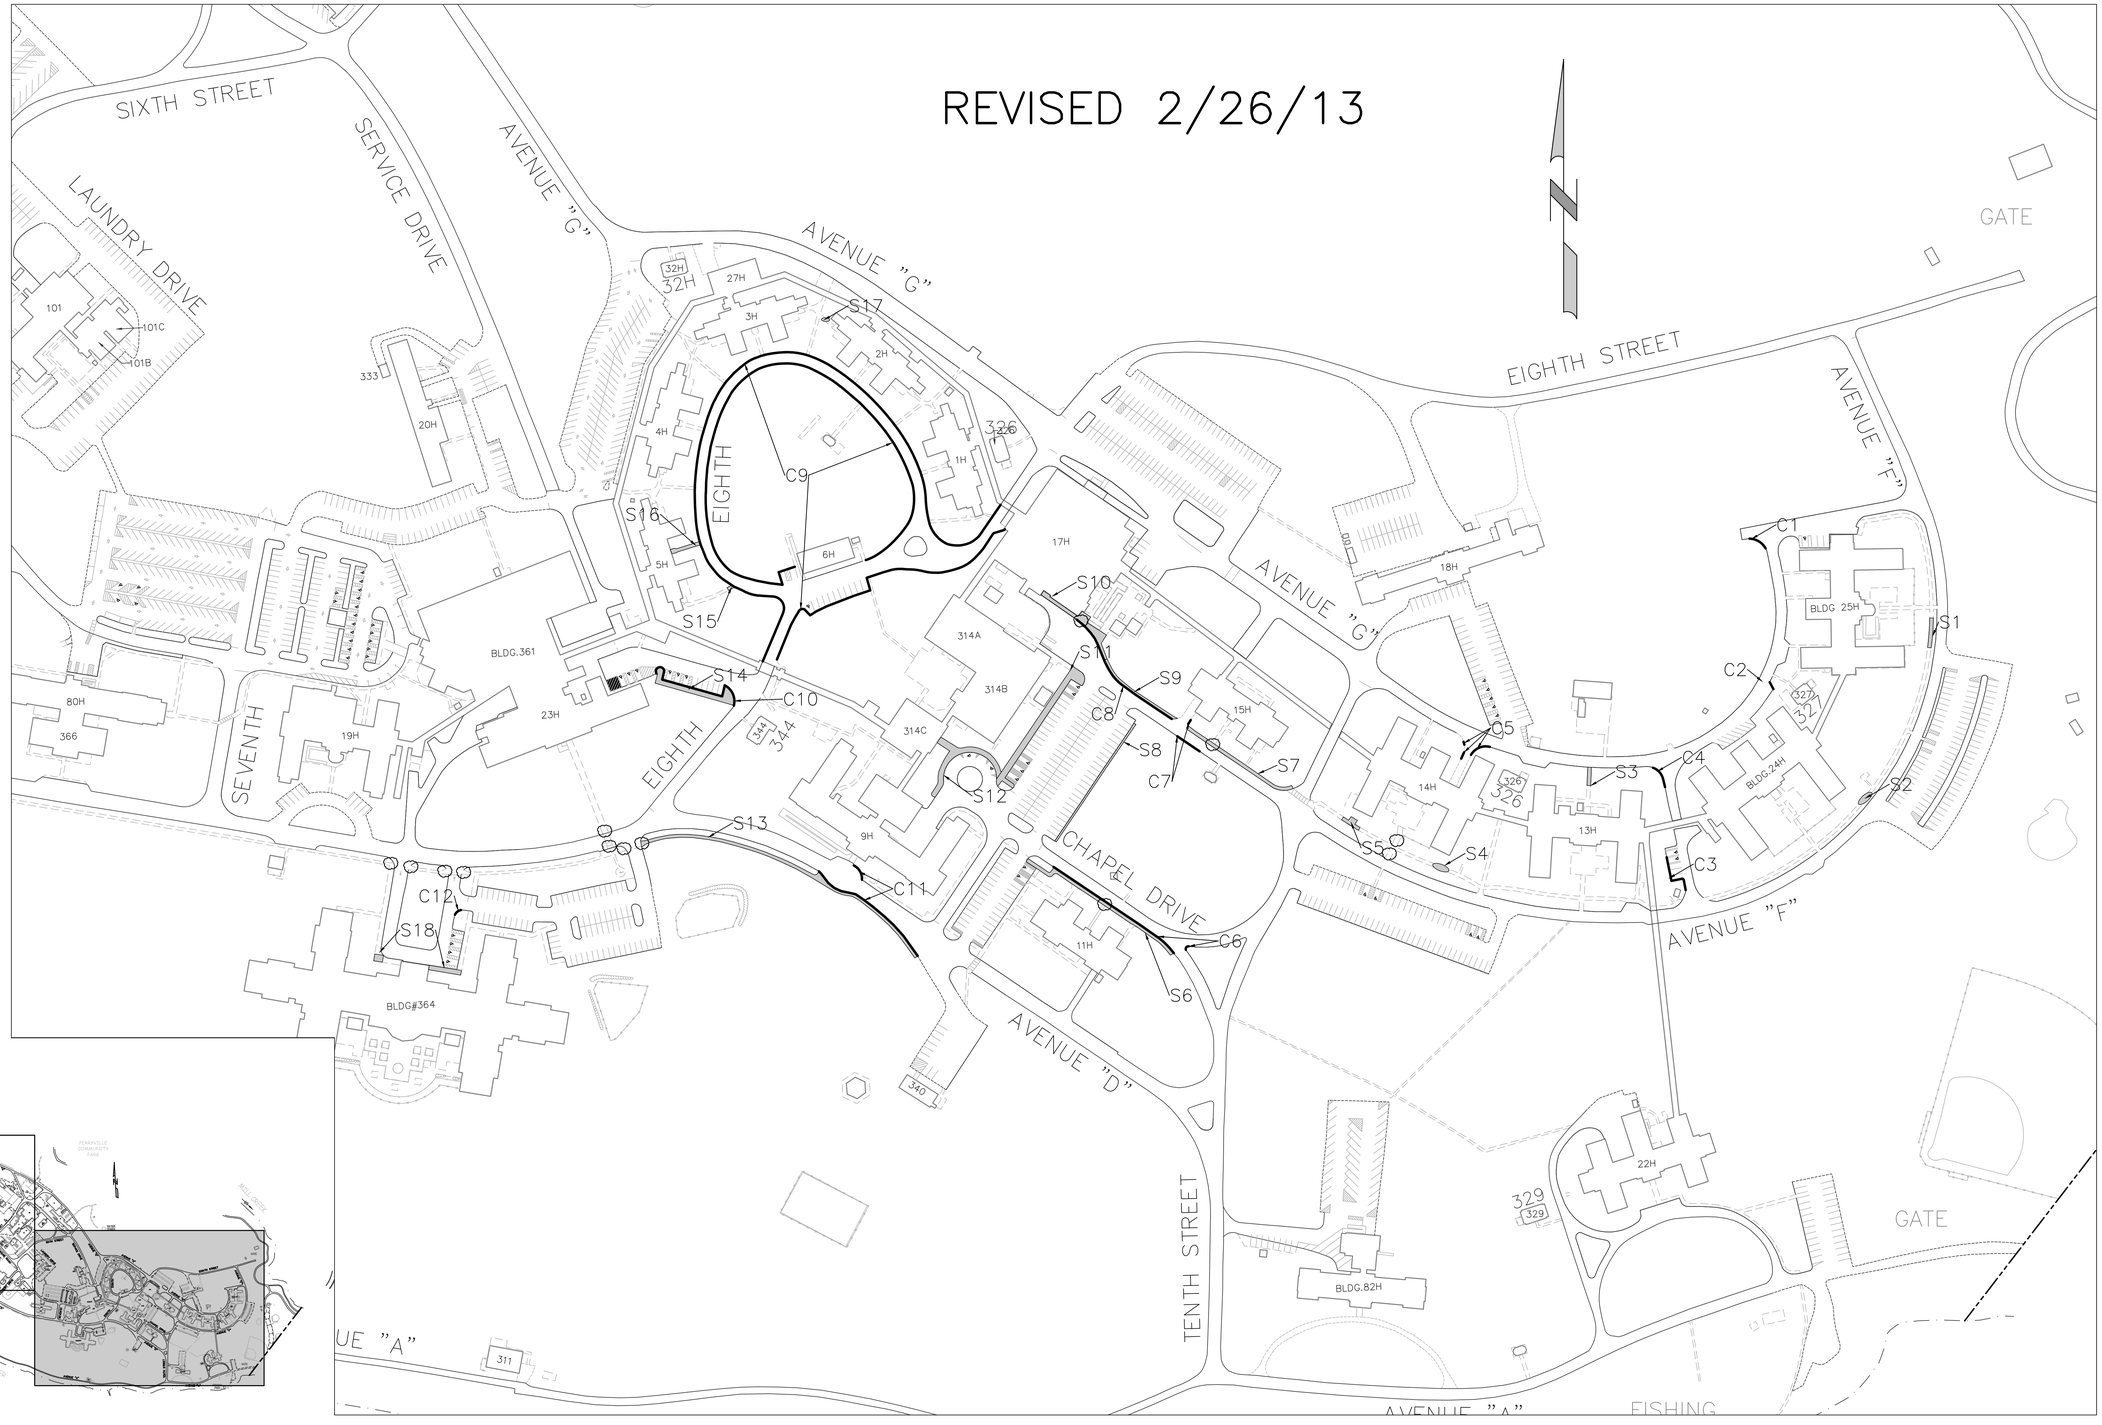

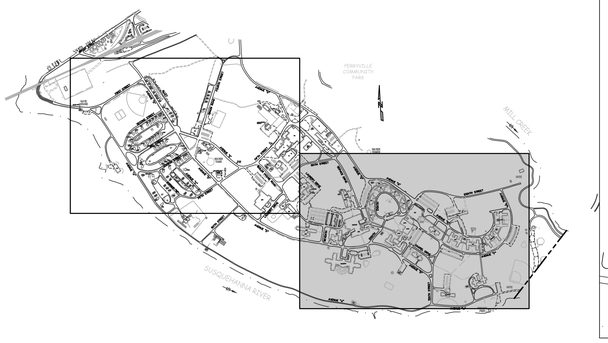

Additions:	Date:
Revisions:	

Approved:

Approved: Chief, Facilities and Engineering:

Approved: Associate Chief for Maintenance And Operations, Perry Point:

Approved: Engineering Projects Supervisor

Approved: Infection Control Officer

Approved: Associate Director for Operations:

Approved: Director, Medical Center:

Drawing Title: SITE PLAN – EASTERN END OF CAMPUS

Project Title: MISC ISOLATED SIDEWALK, CURB AND, GUTTER REPAIRS

Location: VAMHCS PERRY POINT, MD 21902

Scale:	Building No:	Checked:	Drawn:
1:100	N/A	MHD	MOH/MHD

Date: FEBRUARY 26,2013

Project No: 512-11-337

DRAWING NO: SW-02 OF 5

DEPARTMENT OF VETERANS AFFAIRS