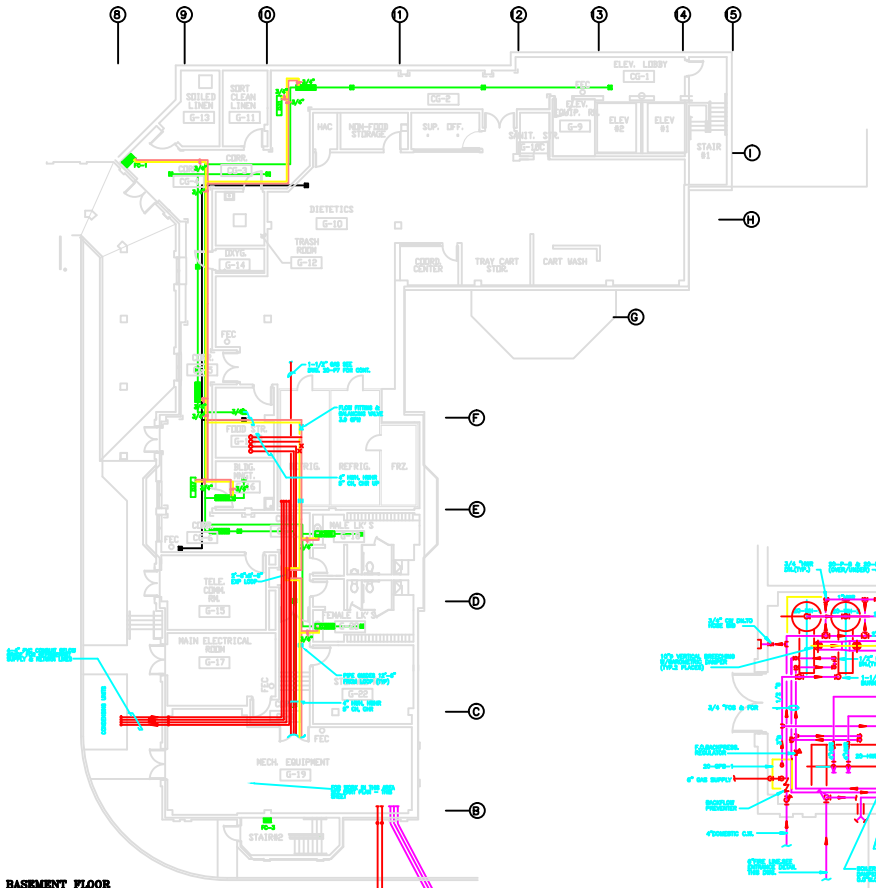

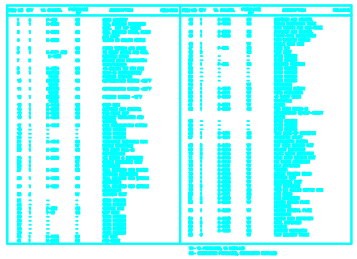

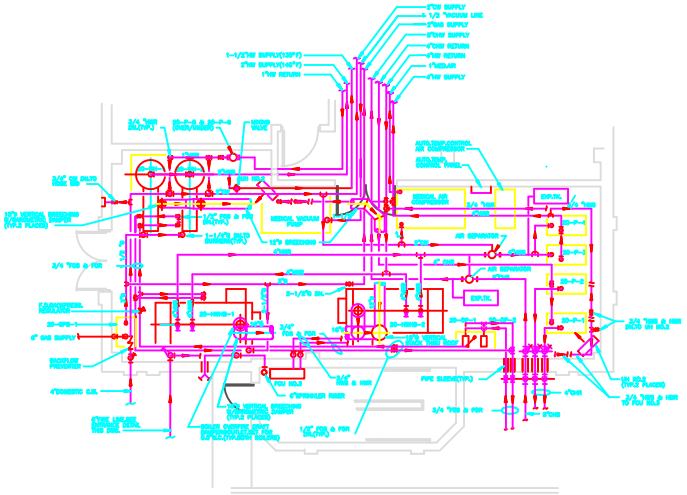

MECHANICAL EQUIPMENT ROOM – PART PLAN

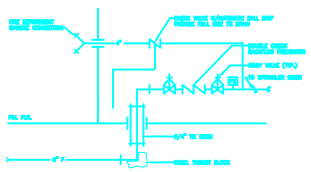

PIPING SCHEMATIC – FIRE SERVICE ENTRANCE

AIR DIFFUSER/REGISTER SCHEDULE

ITEM	SERVICE	DESCRIPTION
①	SUPPLY	
②	SUPPLY	
③	SUPPLY	
④	SUPPLY/RETURN	
⑤	EXHAUST/RETURN	
⑥	SUPPLY	
NOTES		ALUMINUM CONSTRUCTION, COLOR WHITE, NECK SIZE AS INDICATED

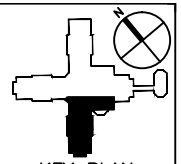

KEY PLAN

No.	Description	Date	By

Department of Veterans Affairs

BALTIMORE REHABILITATION EXTENDED_CARE CENTER

Drawn ZRPI	Scale 1/8"=1'
Checked ZRPI	Date 9-29-97

Title
BASEMENT–SOUTHWEST PIPING ("AS–BUILT")

File Path

Drawing No. ABASEH7

Revision –