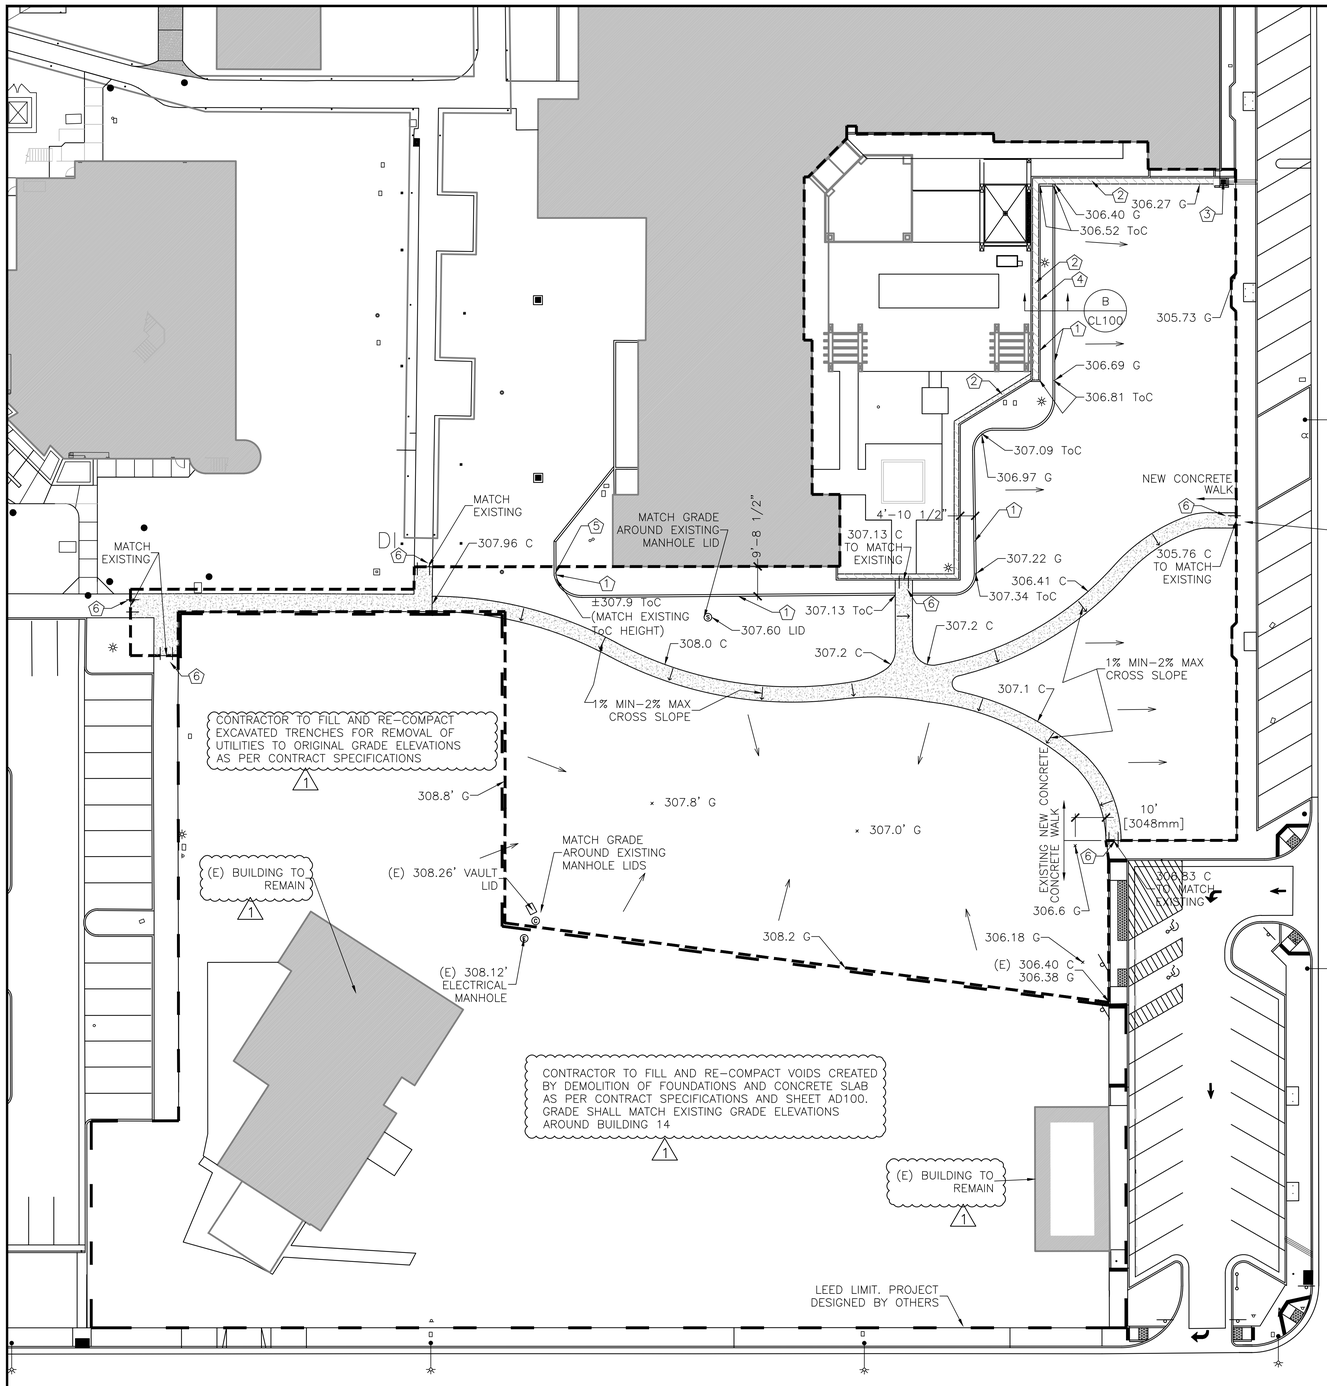

GRADING PLAN
SCALE: 1"=20'-0"

REFERENCES

- (E) CONCRETE VALLEY GUTTER
- (N) CONCRETE WALKWAY – 5' WIDE BY 4" THICK (typ) AS PER DETAIL D/CS501
- → CONCRETE SLOPE
- ⟶ GROUND SLOPE
- (1) (N) 8" CONCRETE CURB (PLANTER)
- (2) (E) CONCRETE VALLEY GUTTER
- (3) (E) STEEL GRATE – DRAINAGE SYSTEM
- (4) (N) 6" CONCRETE CURB (PLANTER)
- (5) (E) CONCRETE CURB (PLANTER) TO REMAIN
- (6) (N) 2–30"L #3 BAR w/ 4" MIN. EMBEDMENT

- XXX.XX C (N) PROPOSED ELEVATION AT CONCRETE
- XXX.XX ToC (N) TOP OF CURB ELEVATION
- XXX.XX G (N) PROPOSED GROUND (DIRT, GRASS) ELEVATION

100% SUBMITTAL - FOR CONSTRUCTION

Revisions	Date
⚠ GRADING AT BUILDING 14 AND REMOVED UTILITIES	03-05-2013

CONSULTANTS:

REGISTERED PROFESSIONAL ENGINEER ESTEBAN T. PAULI No.C51761 Exp. 6-30-14 CIVIL STATE OF CALIFORNIA

ARCHITECT/ENGINEER:
PAULI ENGINEERING, INC.
2501 W. SHAW AVE., #121, FRESNO, CA 93711
PH: (559)237-4408 - FAX: (559)237-4409
E-MAIL: paulienginering@sbcglobal.net
www.paulienginering.com

Drawing Title: PROPOSED GRADING PLAN
Approved Project Director:
Project Title: DEMO BUILDINGS 10, 13 AND 14
Location: 2615 E. Clinton Ave, Fresno, CA
Date: 12/12/2012 | Checked | Drawn
Project Number: 570-12-571
Building Number: OUTBUILDINGS
Drawing Number: CS100 Dwg. of --

Office of Construction and Facilities Management
Department of Veterans Affairs

VA FORM 08-6231