


**GENERAL NOTES**

- A. All dimensions are taken to face of gypsum wallboard or unit masonry.
- B. Edge of all door jambs at hinge side not otherwise indicated are to be 6" from the face of intersecting walls. Edge of all door jambs at strike side not otherwise located are to be 18" minimum from the face of intersecting walls.
- C. All wood blocking to be fire retardant treated.
- D. First floor level 100'-0" equals 728'-0".
- E. All partitions shall be type 'M1-1-F' unless noted otherwise.
- F. Annular space of all pipe, conduit, duct, and other similar penetrations of fire rated assemblies shall be firestopped. In addition, penetrations through 0-hour rated walls and floors shall be firestopped to retard the passage of fire and smoke.
- G. Field verify existing conditions, including duct, pipe and equipment sizes, services and locations prior to performing work.

**PLAN NOTES**

- 2.01 Existing construction to remain, protect in place.
- 2.29 Coordinate the removal of roof membrane with Structural Drawings. Carefully remove roof membrane from parapet wall as required new work. Prepare area for new construction.
- 2.58 Coordinate existing downspout with new canopy.
- 4.15 Patch & tuckpoint brick masonry units as needed. Refer to Structural Drawings.
- 9.25 Repair, prep, prime & paint door & frame as required to look like new. Match all existing conditions.
- 10.09 Pre-engineered aluminum deck by canopy manufacturer.
- 10.34 Extruded aluminum combination fascia and gutter.

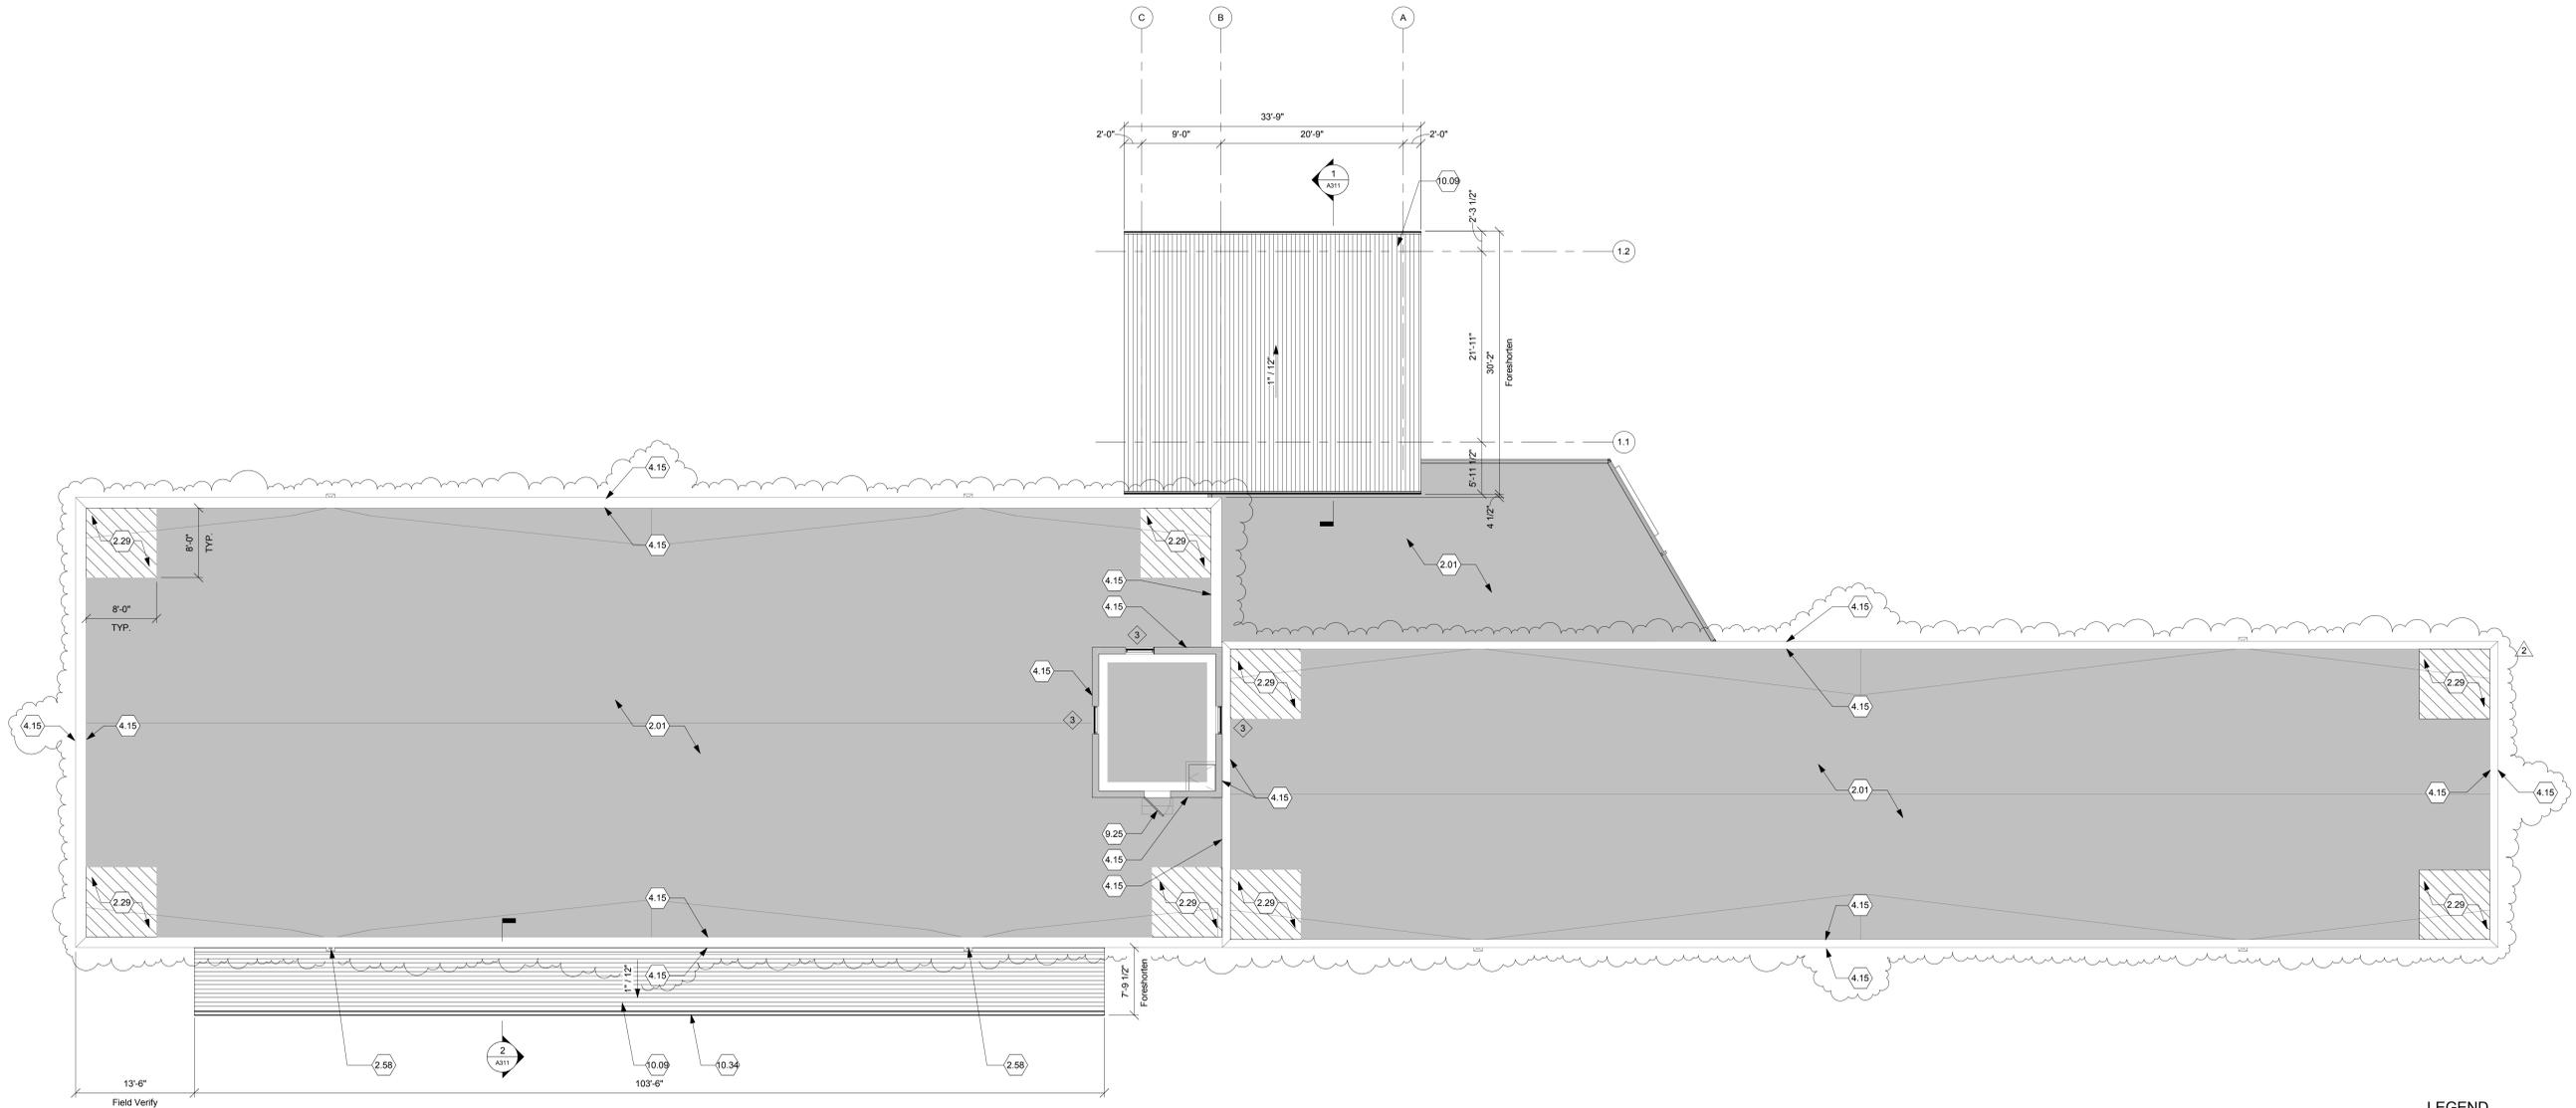

**1 ROOF PLAN**  
Scale: 1/8" = 1'-0"


**LEGEND**

	OVERHEAD CANOPY
	NEW WALLS
	EXISTING WALLS
	EXISTING TO REMAIN

**FULLY SPRINKLERED**

Revisions	ADDENDUM #2	Date
2		03/06/2013

CONSULTANTS:

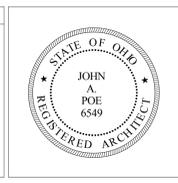

ARCHITECT/ENGINEERS:  
**JOHN POE ARCHITECTS**  
116 EAST THIRD STREET  
DAYTON, OHIO 45402-2130  
937 461 3290 PHONE  
937 461 0260 FAX  
jpa@johnpoe.com

Drawing Title  
**ROOF PLAN**  
Approved: Project Director

Project Title  
**CHILLICOTHE V.A. RENOVATION / EXPANSION OF WAREHOUSE 23**  
Location  
**Chillicothe, Ohio**  
Date  
12/21/2012

Project No.  
VA Project No. 538-13-106  
JPA Project No. 12003.00  
Building Number  
**23**  
Drawing Number  
**A102**  
Dwg. 7 of 31

Office of  
Construction  
and Facilities  
Management  
Department of  
Veterans Affairs