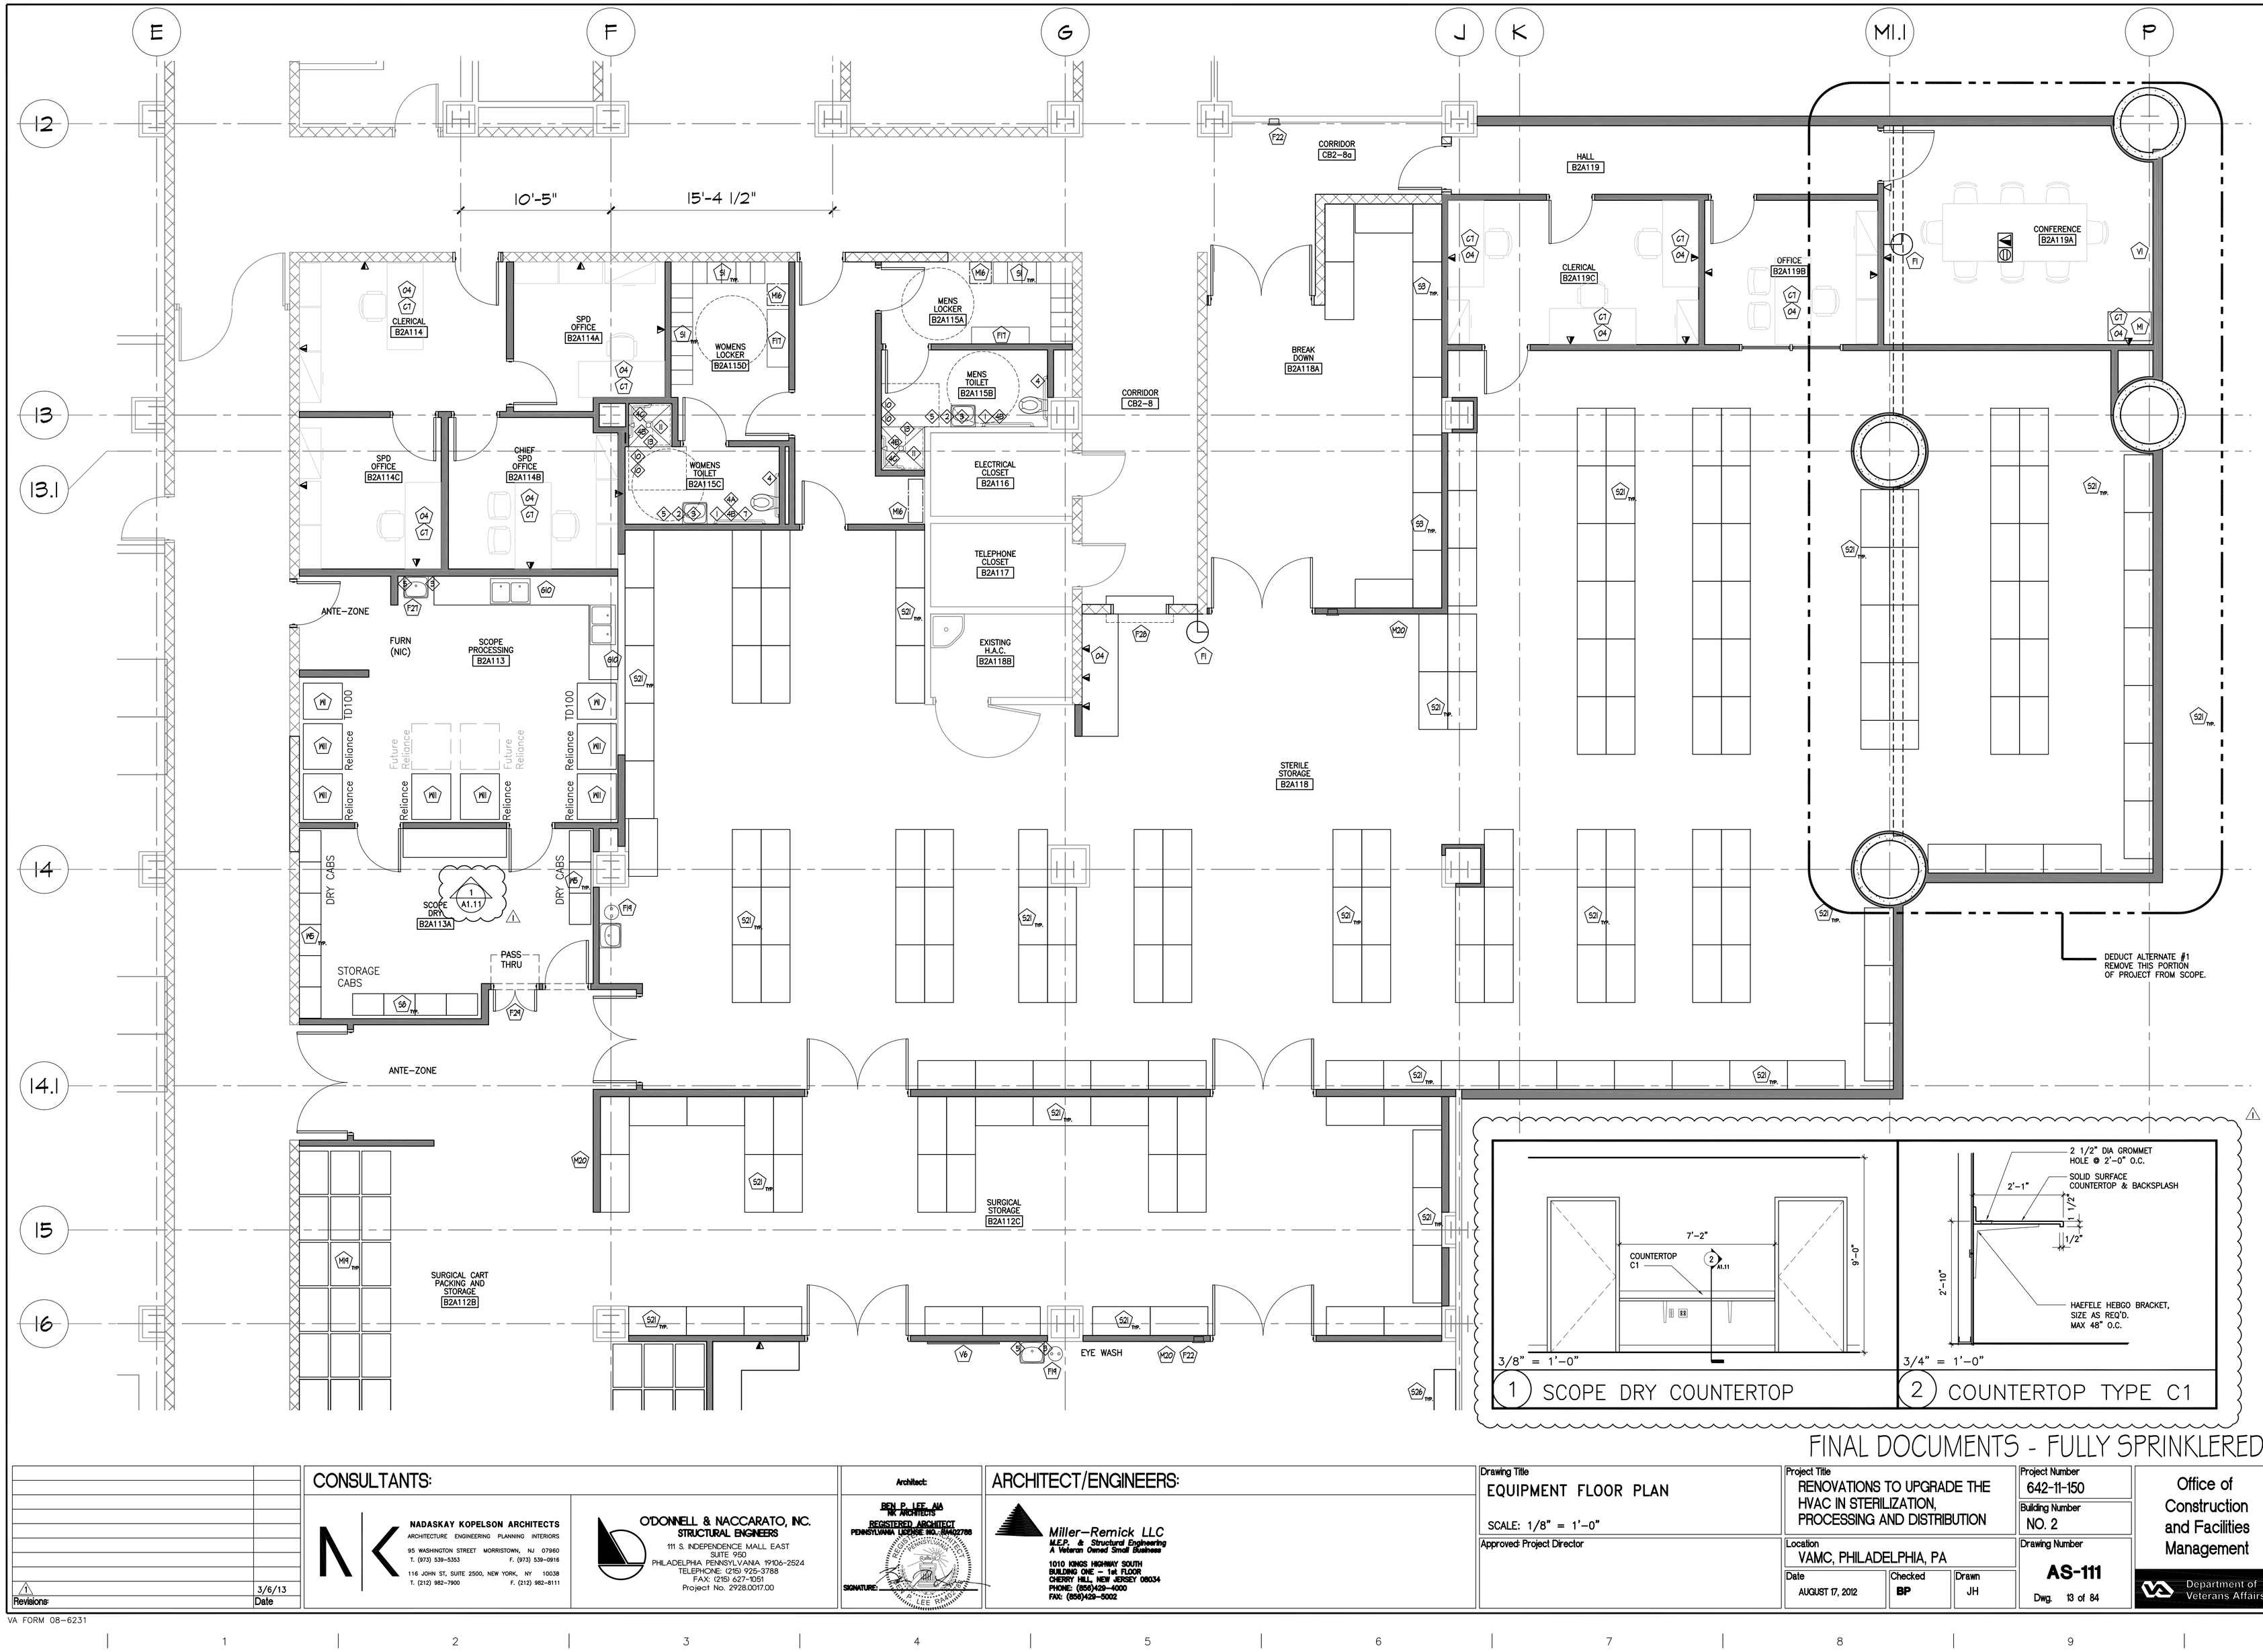

FINAL DOCUMENTS - FULLY SPRINKLERED

Revisions	Date
1	3/6/13

CONSULTANTS:

NADASKAY KOPELSON ARCHITECTS
ARCHITECTURE ENGINEERING PLANNING INTERIORS
95 WASHINGTON STREET MORRISTOWN, NJ 07960
T. (973) 539-5353 F. (973) 539-0916
116 JOHN ST, SUITE 2500, NEW YORK, NY 10038
T. (212) 982-7900 F. (212) 982-8111

O'DONNELL & NACCARATO, INC.
STRUCTURAL ENGINEERS
111 S. INDEPENDENCE MALL EAST
SUITE 950
PHILADELPHIA PENNSYLVANIA 19106-2524
TELEPHONE: (215) 925-3788
FAX: (215) 627-1051
Project No. 2928.0017.00

Architect:
BEN P. LEE, AIA
NK ARCHITECTS
REGISTERED ARCHITECT
PENNSYLVANIA LICENSE NO. RA402788
SIGNATURE:

ARCHITECT/ENGINEERS:

Miller–Remick LLC
M.E.P. & Structural Engineering
A Veteran Owned Small Business
1010 KINGS HIGHWAY SOUTH
BUILDING ONE – 1st FLOOR
CHERRY HILL, NEW JERSEY 08034
PHONE: (856)429-4000
FAX: (856)429-5002

Drawing Title: EQUIPMENT FLOOR PLAN
SCALE: 1/8" = 1'-0"
Approved: Project Director

Project Title: RENOVATIONS TO UPGRADE THE HVAC IN STERILIZATION, PROCESSING AND DISTRIBUTION
Location: VAMC, PHILADELPHIA, PA
Date: AUGUST 17, 2012 | Checked: BP | Drawn: JH

Project Number: 642-11-150
Building Number: NO. 2
Drawing Number: AS-111
Dwg. 13 of 84

Office of Construction and Facilities Management
Department of Veterans Affairs

VA FORM 08-6231