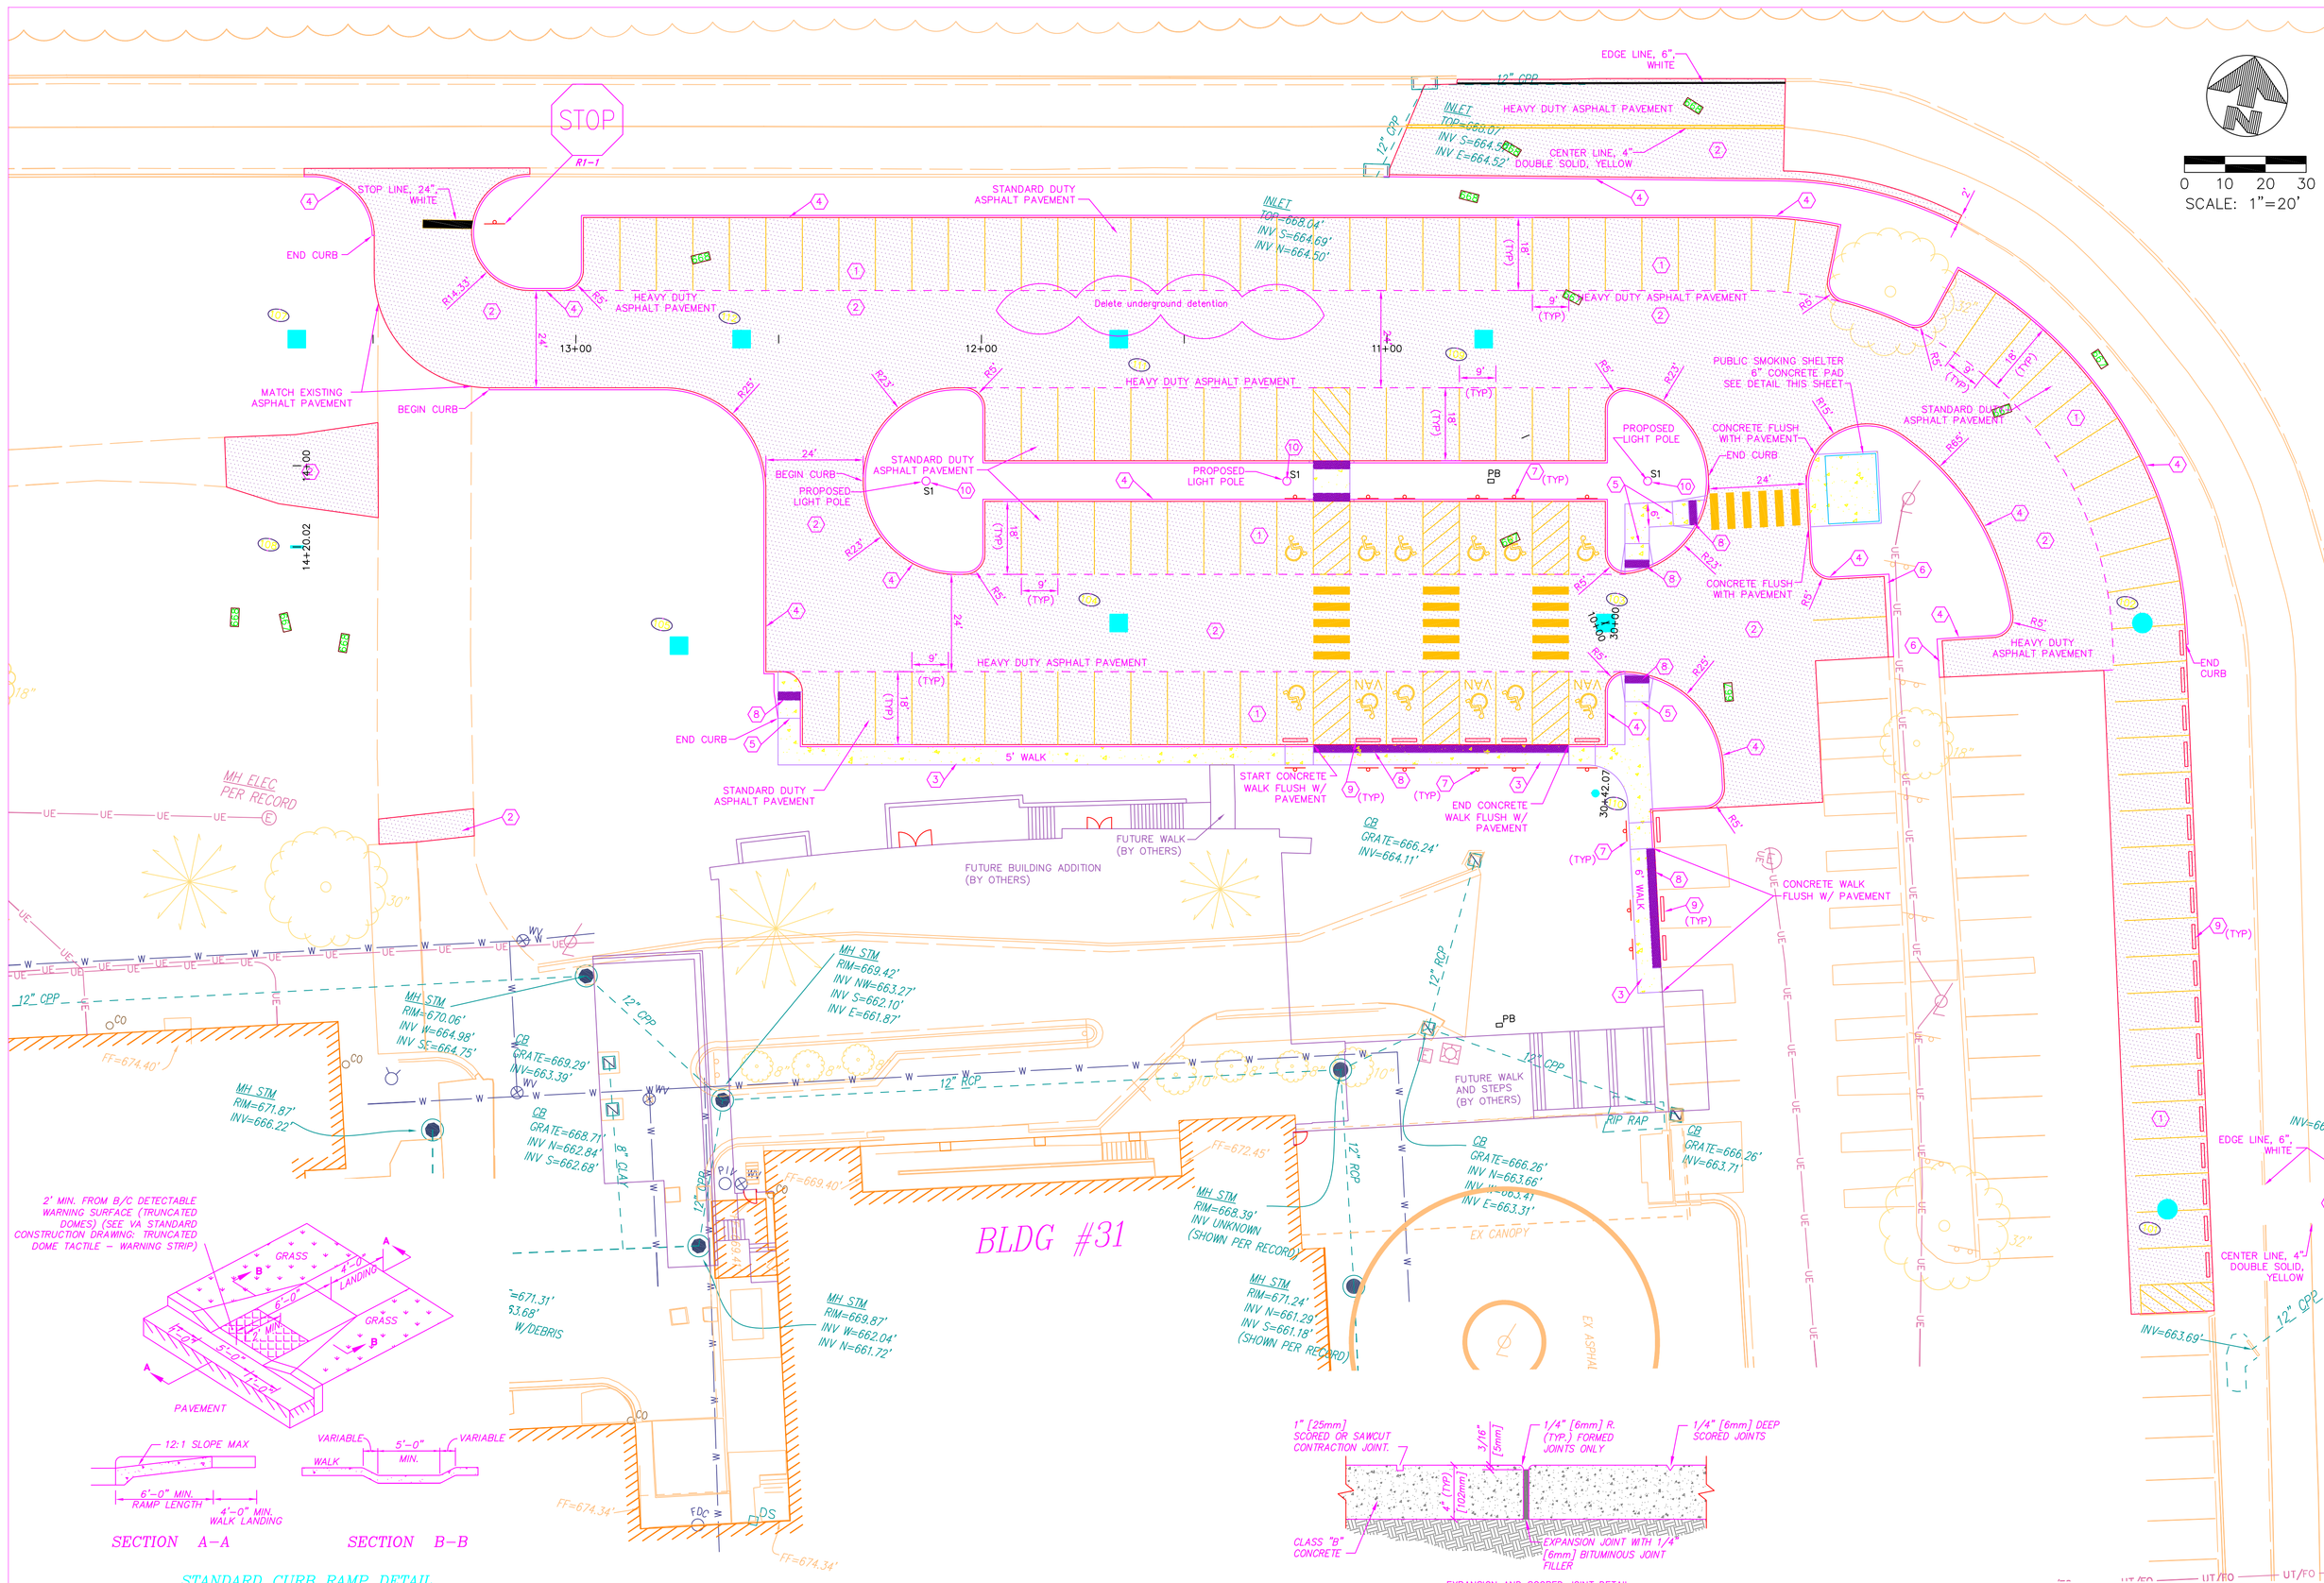

STANDARD CURB RAMP DETAIL
N.T.S.

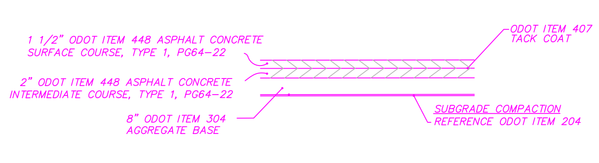

STANDARD DUTY ASPHALT PAVEMENT
N.T.S.

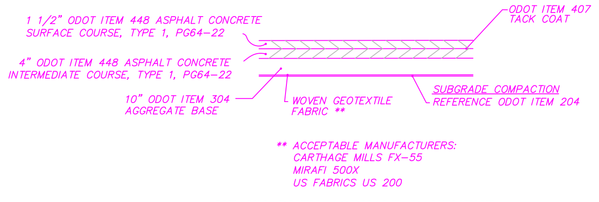

** ACCEPTABLE MANUFACTURERS:
CARTHAGE MILLS FX-55
MIRAFI 500X
US FABRICS US 200

HEAVY DUTY ASPHALT PAVEMENT
N.T.S.

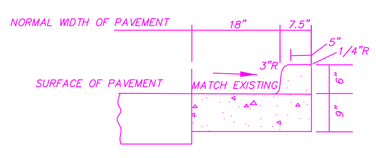

CURB AND GUTTER
N.T.S.

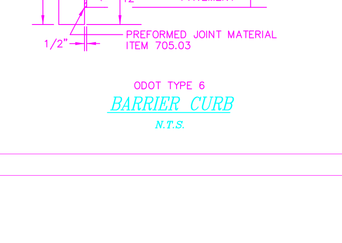

ODOT TYPE 6
BARRIER CURB
N.T.S.

EXPANSION AND SCORED JOINT DETAIL

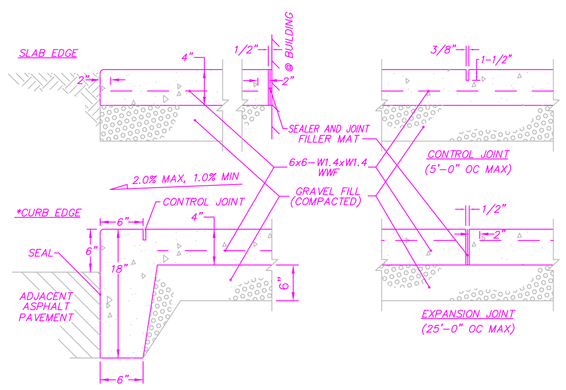

NOTE: ALL JOINTS SHALL BE TOOLED

TYPICAL EXTERIOR CONCRETE SLAB WALK
N.T.S.

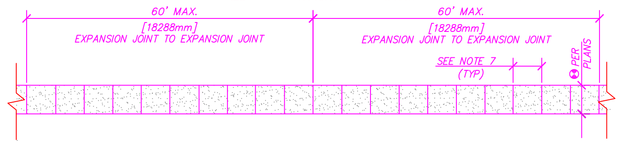

NOTES:
1. EXPANSION JOINTS SHALL BE LOCATED WHERE SIDEWALK ABUTS CONCRETE DRIVEWAYS, CURB OR OTHER ADJACENT STRUCTURES.
2. ONE-HALF INCH BITUMINOUS JOINT FILLER SHALL BE INSTALLED AT EXPANSION JOINT LOCATIONS AND SHALL EXTEND THE FULL DEPTH OF THE CONCRETE.
3. 1" DEEP CONTRACTION JOINTS SHALL BE PLACED AT INTERVALS OF APPROXIMATELY 15' [4572mm] OR AT A SPACING THAT MATCHES THE ADJACENT CURB.
4. FORMED CONTRACTION JOINTS SHALL BE FINISHED WITH A TOOL HAVING A 1/4" [6mm] RADIUS.
5. SCORED JOINTS SHALL BE 1/4" [6mm] DEEP AND PLACED AT THE SPACING INDICATED FOR THE WIDTH OF SIDEWALK OR MATCH SCORED JOINTS OF ADJACENT CURB.
6. CONCRETE SHALL BE FINISHED BY MEANS OF A FLOAT, STEEL TROWELLED AND BROOMED WITH A FINE BRUSH IN A TRANSVERSE DIRECTION.
7. 1/4" DEEP SCORED JOINTS (TYP) SPACED AT 6' [1829mm] OR EQUAL TO SIDEWALK WIDTH.

PROPOSED SYMBOLS

- ASPHALT PAVEMENT SEE DETAIL THIS SHEET
- CONCRETE WALK SEE DETAIL THIS SHEET
- CB — CATCH BASIN
- SMH — STORM MANHOLE
- YD — YARD DRAIN
- CO — CLEANOUT
- FH — FIRE HYDRANT
- FDC — FIRE DEPARTMENT CONNECTION

CODED NOTES

1. STANDARD DUTY PAVEMENT, SEE DETAIL THIS SHEET.
2. HEAVY DUTY PAVEMENT, SEE DETAIL THIS SHEET.
3. CONCRETE WALK, SEE DETAIL THIS SHEET.
4. CONCRETE BARRIER CURB, SEE DETAIL THIS SHEET.
5. CURB RAMP, SEE DETAIL THIS SHEET.
6. CURB AND GUTTER, SEE DETAIL THIS SHEET.
7. ACCESSIBLE PARKING SIGN, SEE DETAIL THIS SHEET.
8. DETECTABLE WARNING, SEE VA STANDARD CONSTRUCTION DRAWING: TRUNCATED DOME TACTILE–WARNING STRIP.
9. PRE–CAST CONCRETE WHEEL STOP, SEE DETAIL THIS SHEET.
10. CONCRETE SUPPORT BASE FOR LIGHT POLE IN GRASS, SEE DETAIL ON SHEET C107.

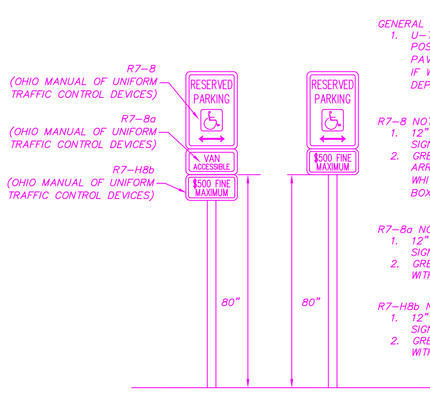

GENERAL NOTES:
1. U–TYPE FLANGED STEEL SIGN POST SET IN EARTH, IF OUTSIDE PAVEMENT EDGE, OR IN CONCRETE, IF WITHIN PAVEMENT, TO A MINIMUM DEPTH OF 3'–0".

R7–8 NOTES:
1. 12" X 18" X 16 GA. STEEL SIGN
2. GREEN LETTERING, BORDER, AND ARROW WITH WHITE BACKGROUND. WHITE HANDICAP SYMBOL IN BLUE BOX.

R7–8a NOTES:
1. 12" X 6" X 16 GA. STEEL SIGN
2. GREEN LETTERING AND BORDER WITH WHITE BACKGROUND.

R7–H8b NOTES:
1. 12" X 6" X 16 GA. STEEL SIGN
2. GREEN LETTERING AND BORDER WITH WHITE BACKGROUND.

NOTE: THREE PARKING SPACES MINIMUM SHALL BE DESIGNATED AS "VAN ACCESSIBLE". LOCATION AS NOTED ON THE DRAWINGS.

ONE SIGN TO BE INSTALLED AT EACH ACCESSIBLE PARKING SPACE

ACCESSIBLE PARKING SIGN DETAIL
N.T.S.

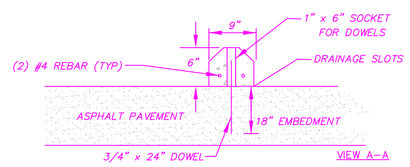

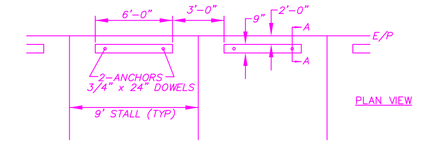

PRE–CAST CONCRETE WHEEL STOPS
N.T.S.

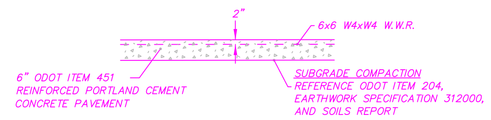

SMOKING SHELTER CONCRETE PAD
N.T.S.

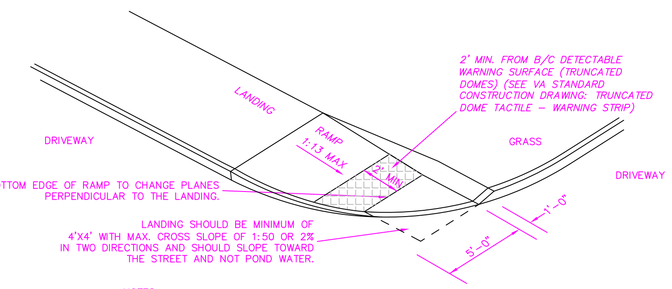

NOTES:
1.) REFER TO VA STANDARD CONSTRUCTION DRAWING: TRUNCATED DOME TACTILE–WARNING STRIP FOR DETECTABLE WARNING DETAIL.
2.) THE MATERIAL USED TO PROVIDE CONTRAST SHALL BE AN INTEGRAL PART OF THE WALKING SURFACE.
3.) TRUNCATED DOMES SHALL BE USED ON ALL CURB RAMPS.
4.) DETECTABLE WARNINGS SHALL BE YELLOW ARMOR TILE OR EQUAL.

CURB RAMP DETAIL
N.T.S.

NOTE:
THE CONTRACTOR SHALL PROVIDE THE COTR WITH INFORMATION PROVIDED BY THE CONTRACTOR'S UNDERGROUND UTILITY LOCATING SERVICE TO CONFIRM UTILITY LOCATIONS AT LEAST 48 HOURS PRIOR TO COMMENCING EXCAVATION ACTIVITIES.

Revisions	Date

CONSULTANTS:

ARCHITECT/ENGINEERS:

JOHN POE ARCHITECTS
116 EAST THIRD STREET
DAYTON, OHIO
45402-2130
937 461 3290 PHONE
937 461 0260 FAX
jpa@johnpoe.com

Drawing Title: LOCATION PLAN

Approved: Project Director

Project Title: VAMC Chillicothe Construct Parking Lot

Location: Chillicothe, Ohio

Project No.: VA Project No. 538-12-109; JPA Project No. xxxxx.xx

Building Number: 31

Drawing Number: C102

Dwg. x of x

Date: 01/31/2013

Checked:

Drawn:

Office of Construction and Facilities Management

Department of Veterans Affairs