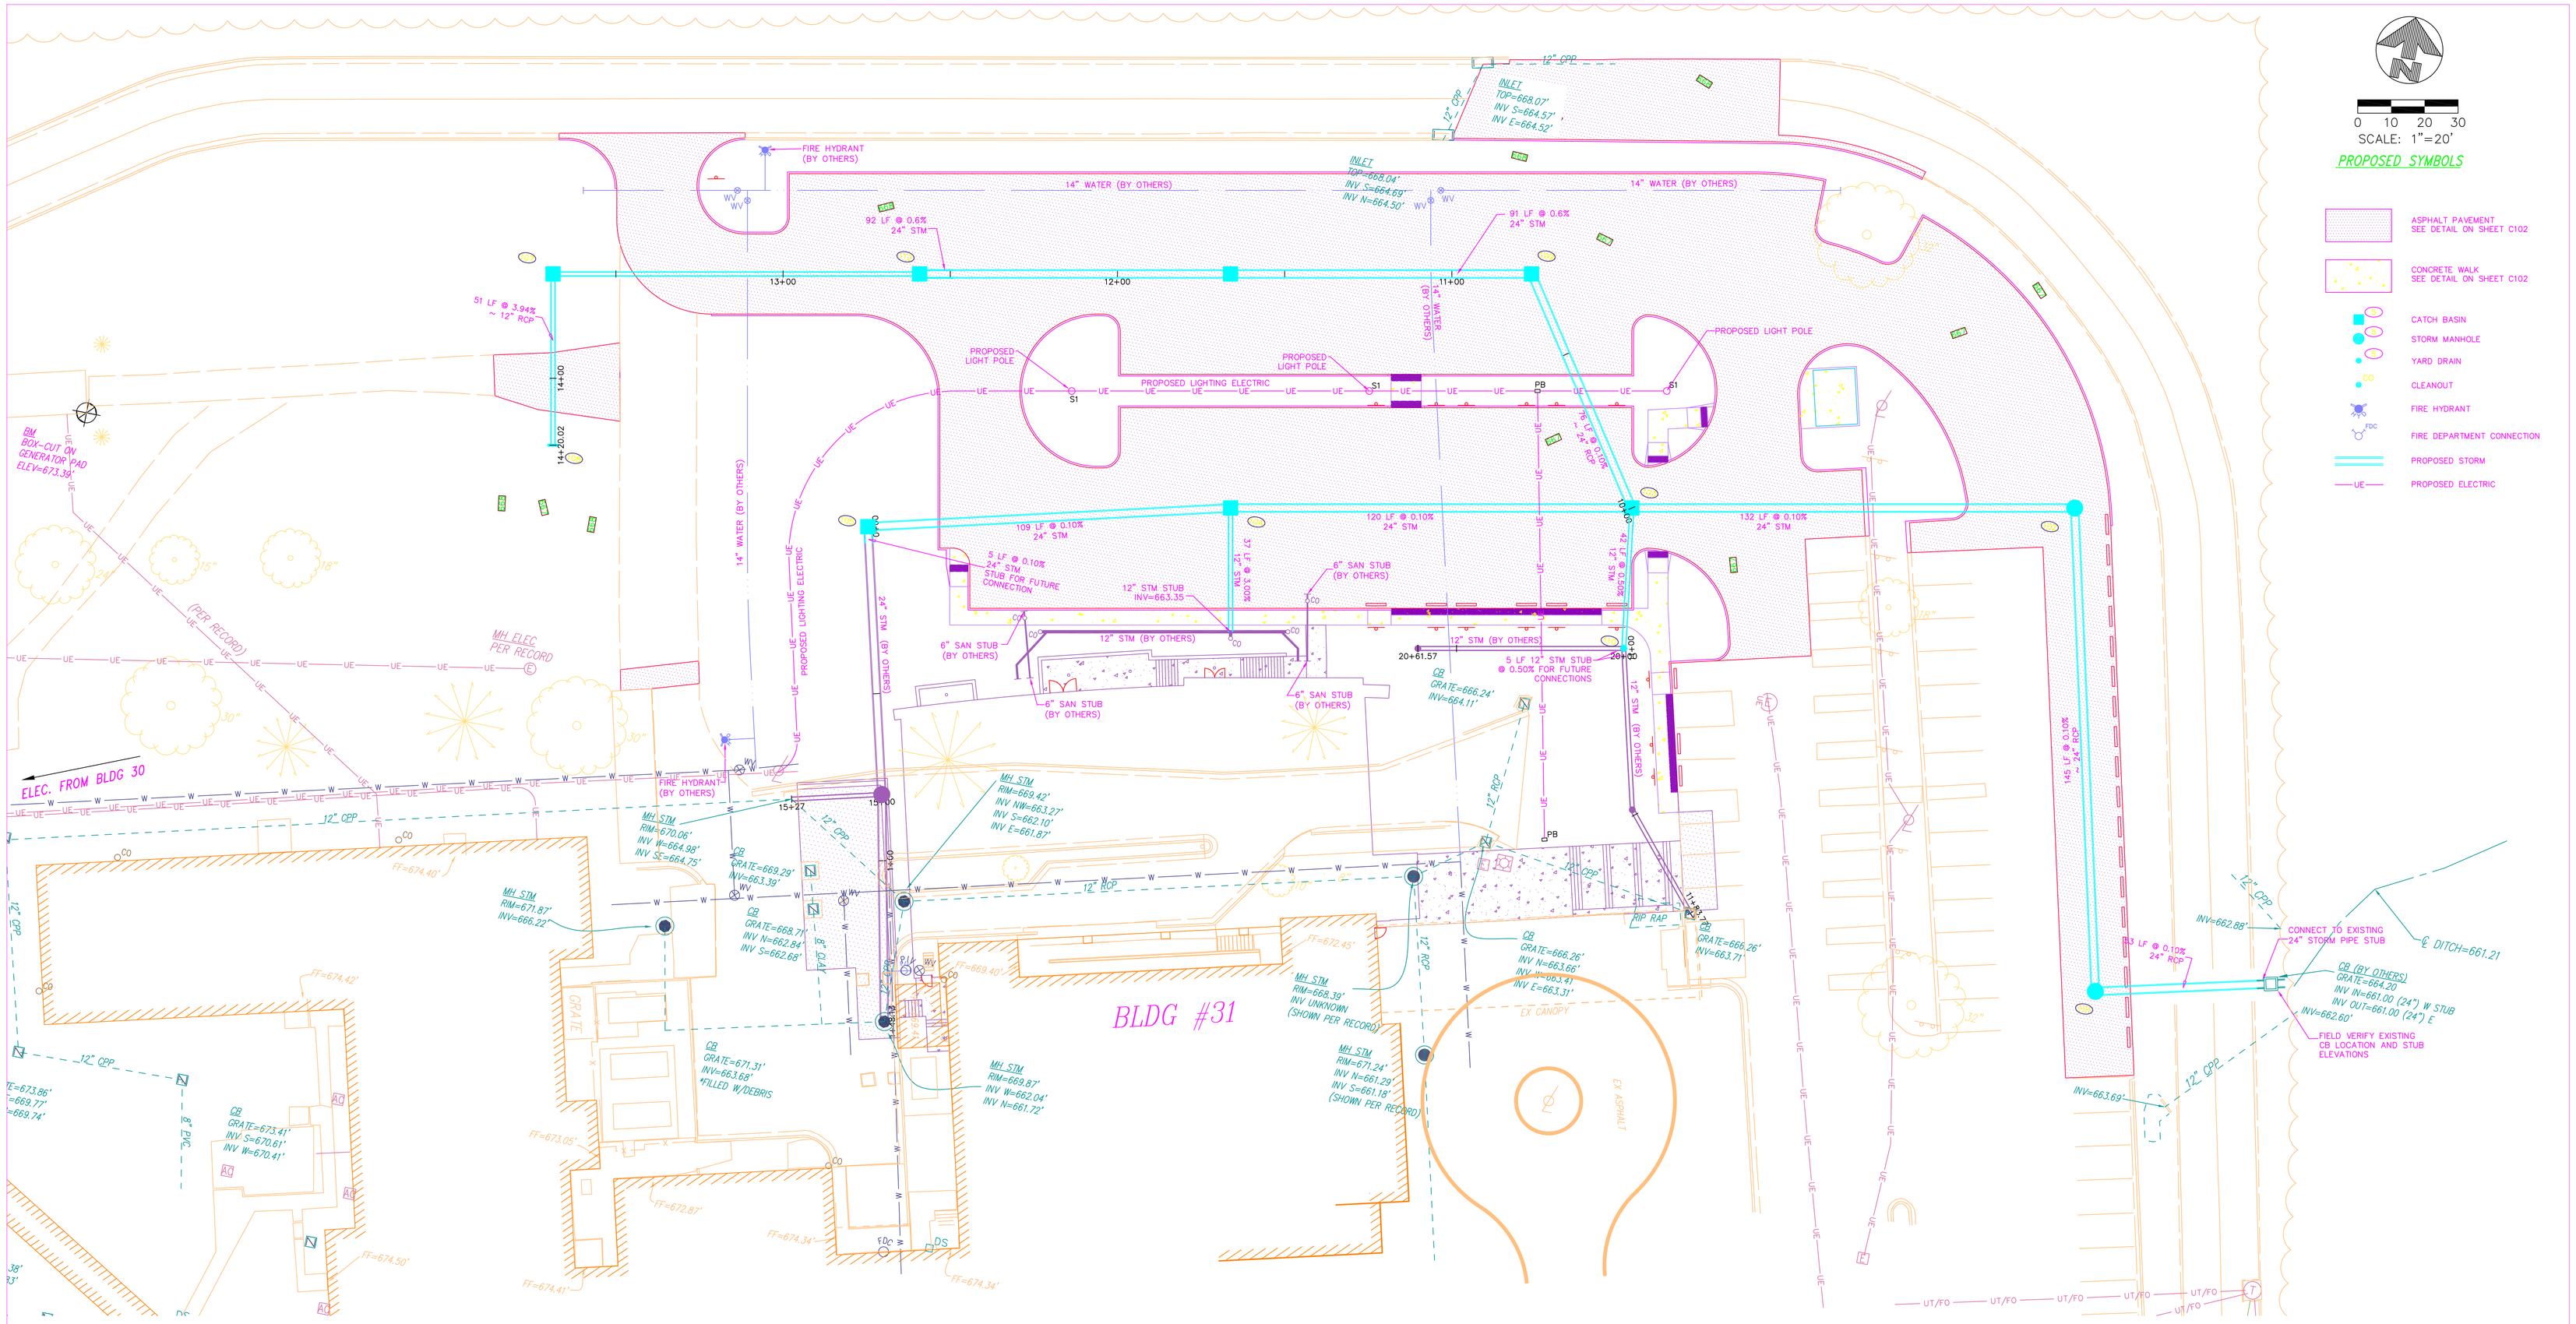

Delete Orifice Plate Detail

NOTE:
THE CONTRACTOR SHALL PROVIDE THE COTR WITH INFORMATION PROVIDED BY THE CONTRACTOR'S UNDERGROUND UTILITY LOCATING SERVICE TO CONFIRM UTILITY LOCATIONS AT LEAST 48 HOURS PRIOR TO COMMENCING EXCAVATION ACTIVITIES.

Revisions	Date

CONSULTANTS:

ARCHITECT/ENGINEERS:

JOHN POE ARCHITECTS
116 EAST THIRD STREET
DAYTON, OHIO
45402-2130
937 461 3290 PHONE
937 461 0260 FAX
jpa@johnpoe.com

Drawing Title: UTILITY PLAN

Approved: Project Director

Project Title: VAMC Chillicothe Construct Parking Lot

Location: Chillicothe, Ohio

Date: 01/31/2013 | Checked: | Drawn:

Project No.: VA Project No. 538-12-109; JPA Project No. xxxxx.xx

Building Number: 31

Drawing Number: C103

Dwg. x of x

Office of Construction and Facilities Management

Department of Veterans Affairs