


2 RELECTED CEILING PLAN
SCALE: 1/8" = 1'-0"

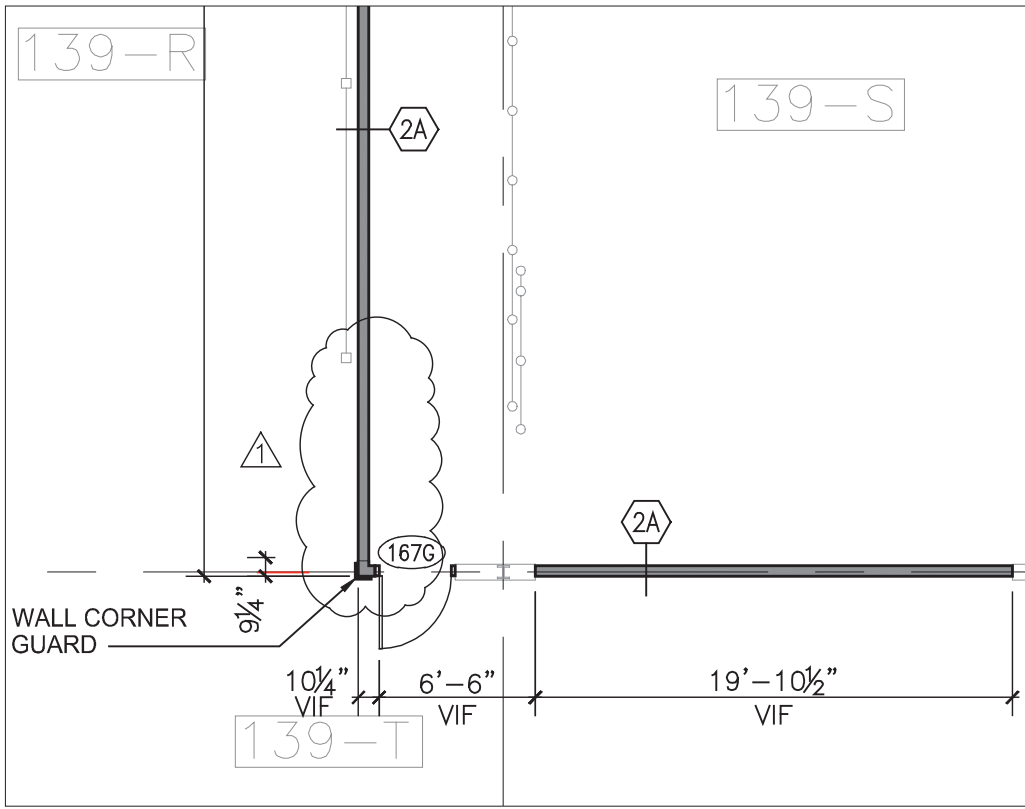

1 FLOOR PLAN
SCALE: 1/8" = 1'-0"

DOOR & FRAME SCHEDULE													
DOOR NO.	ROOM NAME	DOOR					FRAME				LABEL	HDWR.	REMARKS
		MATERIAL	TYPE	FIN.	SIZE	THK.	MATERIAL	FIN.	DETAILS				
									JAMB	HEAD			
163	MAIL ROOM	HM	B	PTD	3'-0"x6'-8"	1 3/4"	HM	PTD			C	EXST'G	SELF-CLOSER/ RELOCATED HARDWARE/ NOTE 1
164	QAMM IT	HM	D	PTD	2 @ 3'-0"x6'-8"	1 3/4"	HM	PTD			C	EXST'G	SELF-CLOSER/ RELOCATED HARDWARE/ NOTE 1
167B	CONFERENCE ROOM	WD	D	STAINED	2 @ 3'-0"x6'-8"	1 3/4"	HM	PTD			C	HW4-D	SELF-CLOSER
167C	CORRIDOR	HM	C	PTD	2 @ 3'-0"x6'-8"	1 3/4"	HM	PTD			C	HW5-B	SELF-CLOSER
167D	CORRIDOR (EXST'G REUSED)	HM	C	PTD	2 @ 3'-0"x7'-0"	1 3/4"	HM	PTD			C	EXST'G	SELF-CLOSER/ RELOCATED HARDWARE/ NOTE 1
167E	CAGE	HM	C	PTD	2 @ 3'-0"x6'-8"	1 3/4"	HM	PTD			C	HW5-B	SELF-CLOSER
167F	CORRIDOR	HM	C	PTD	2 @ 3'-0"x6'-8"	1 3/4"	HM	PTD			C	HW5-B	SELF-CLOSER
167G	CORRIDOR	HM	B	PTD	3'-0"x6'-8"	1 3/4"	HM	PTD			C	HW-6	SELF-CLOSER
NOTE 1: RELOCATE EXISTING DOOR HARDWARE AND CARD READER ACCESS SYSTEMS TO NEW DOOR AND FRAME.													

NOTE 1: RELOCATE EXISTING DOOR HARDWARE AND CARD READER ACCESS SYSTEMS TO NEW DOOR AND FRAME.

DYNACEPT, INC.
ENGINEERS • CONSULTANTS

2280 E DEVON AVE, SUITE 218
DES PLAINES, ILLINOIS 60018-4808
TEL. (847) 299-4848
FAX. (847) 299-4898

UrbanWorks
ARCHITECTURE INTERIORS PLANING

213 W Institute Place Suite 710
Chicago, IL 60610
P: 312 202 1200
F: 312 202 1202

Drawing Title
ADDENDUM 1

Referenced Drawings
Floor Plan (North), RCP (North), Door Schedule

Referenced Sheets
A1, A2, A3

Project Title
**INSTALL FIRE WALL AND
CONFERENCE ROOM**

Building No.
37

Location
**VA SERVICE AND DISTRIBUTION CENTER
HINES, ILLINOIS 60141**

Date
MARCH 12, 2013

Project No.
796-11-0006

DRAWING NO.
ASK-1

Dwg. Of -

Office of Facilities

Department of
Veterans Affairs