


PARTIAL BASEMENT FLOOR PLAN

SCALE: 1/8"=1'-0"

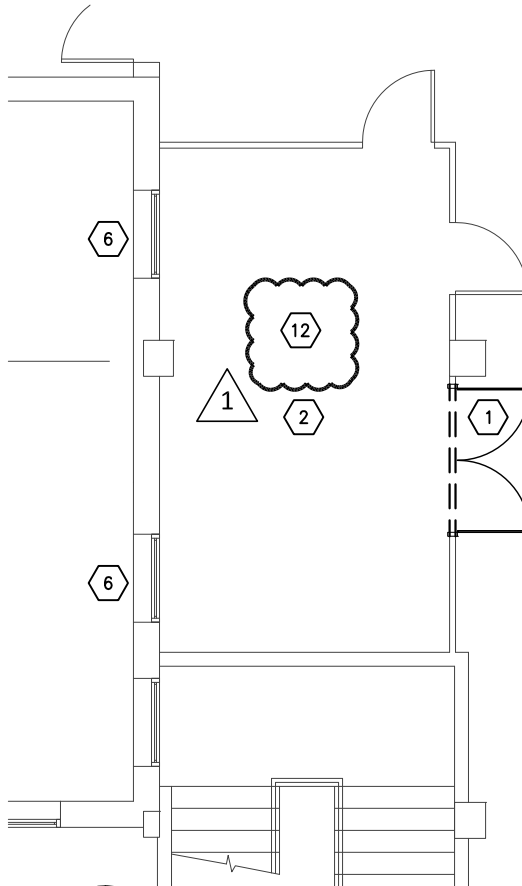

PARTIAL BASEMENT FLOOR PLAN

SCALE: 1/8"=1'-0"


NEW LOCATION SHOWN ON 1/A1.

11. NEW DUCT CHASE. REFER TO MECHANICAL DWGS FOR EXACT LOCATION.

12. REMOVE EXISTING FLOORING DOWN TO BARE CONCRETE. SEAL CONCRETE WITH EPOXY SEALANT.



1 DEL Bulletin #1
RFI Date: 03-15-13

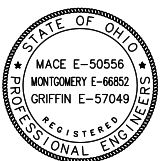

DATE: 03-15-13
PROJECT NO.: 120050
DWN BY: SWH

MODERNIZE HVAC B115
DAYTON VAMC
BUILDING 115



REVISES SHEET
A1

SK1-A1