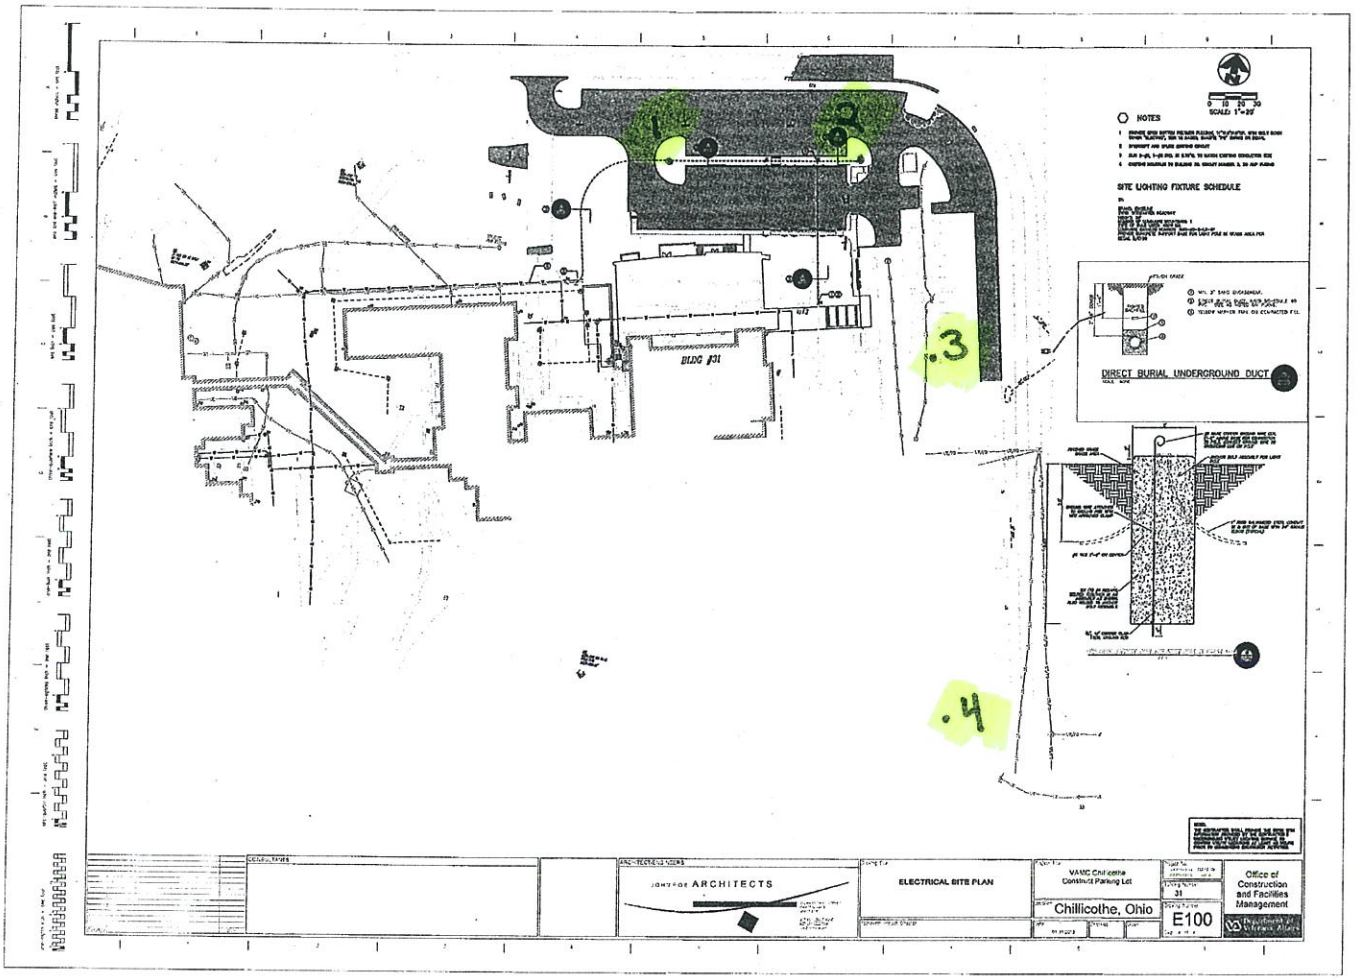PLACEMENT OF CALL BOXES