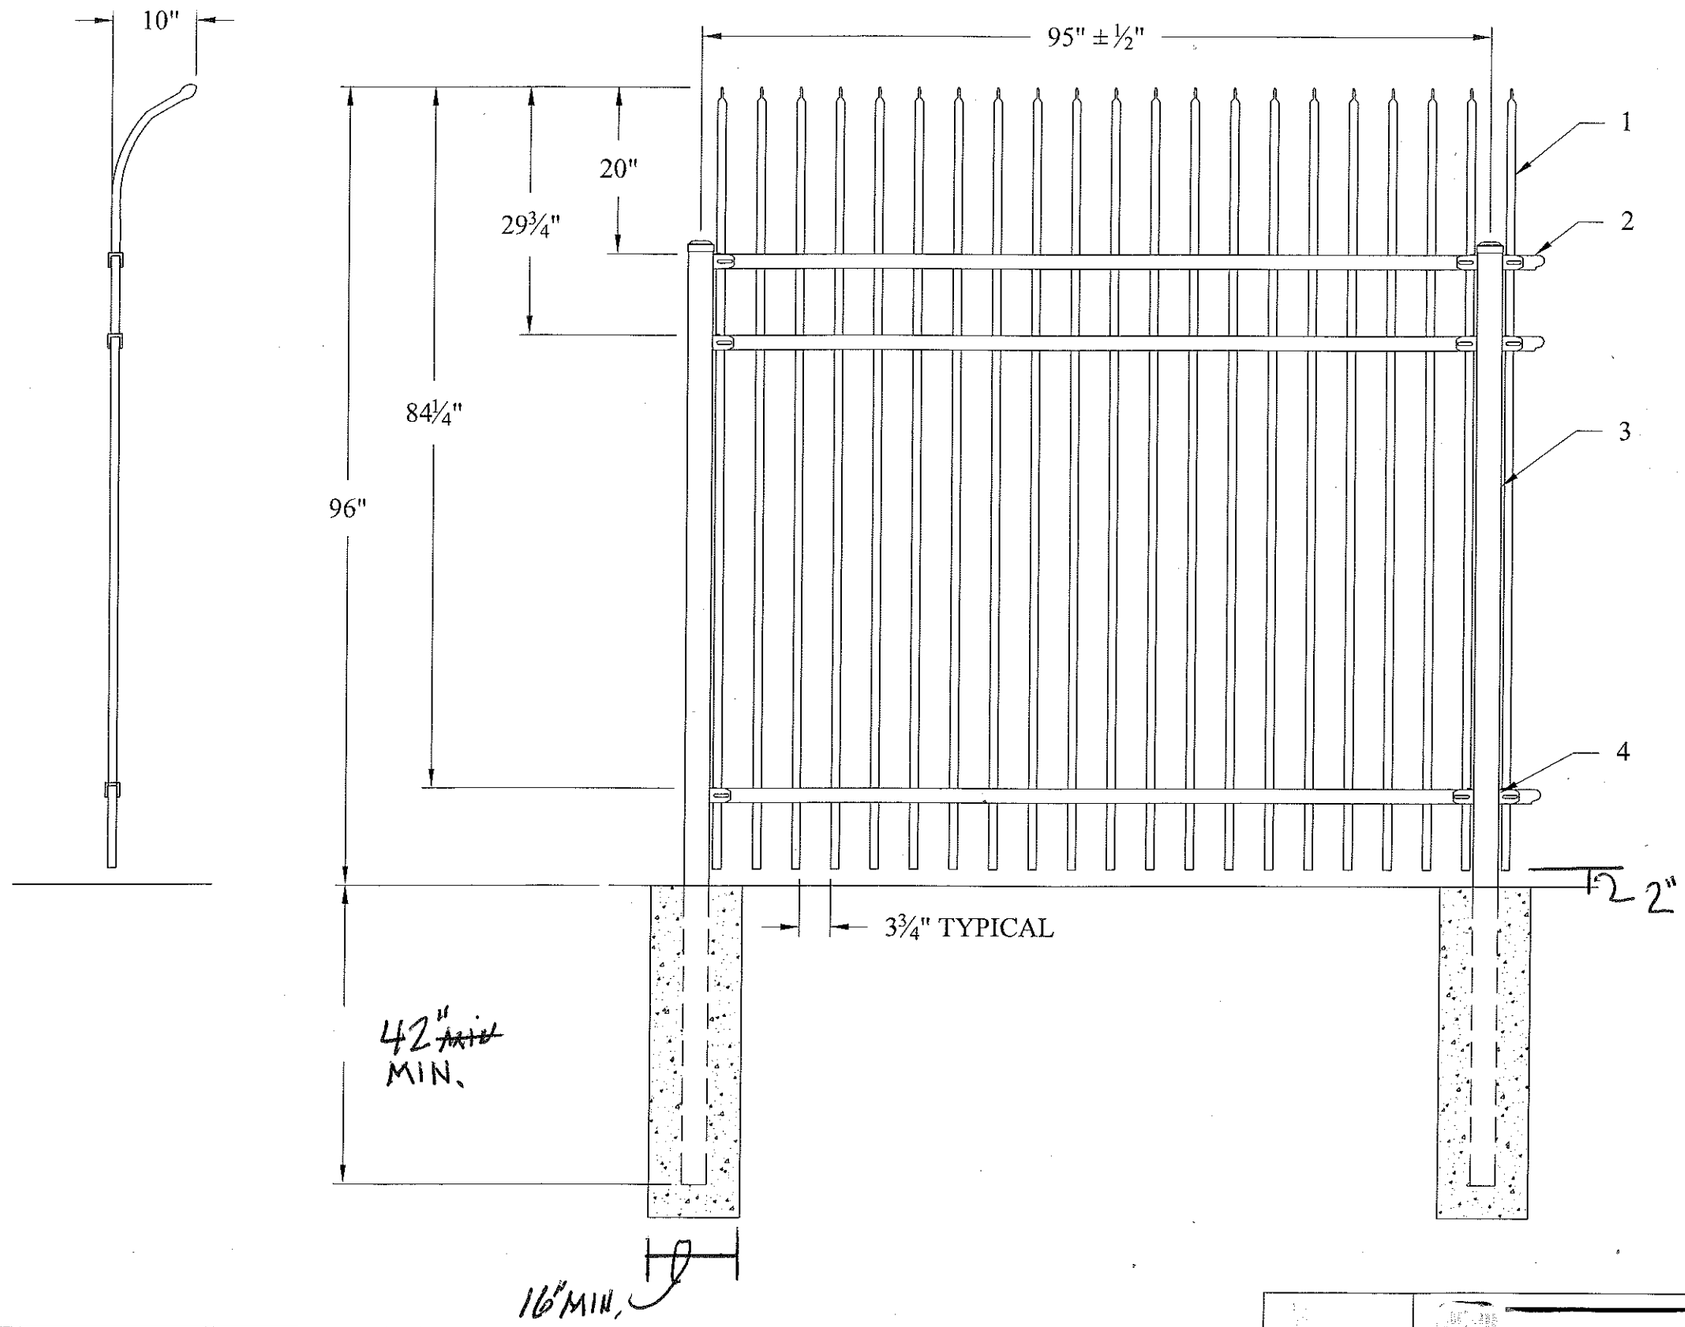

#	QTY.	DESCRIPTION
1	20	1" Sq. PICKET
2	3	1¾" CHANNEL RAIL
3	2	3" Sq. POST
4	6	BRACKETS

PALISADE FENCE DETAIL
DATE 6-2-11

	SCALE: D.N.S.	SHEET:
DRN BY:	CHK BY:	REV: