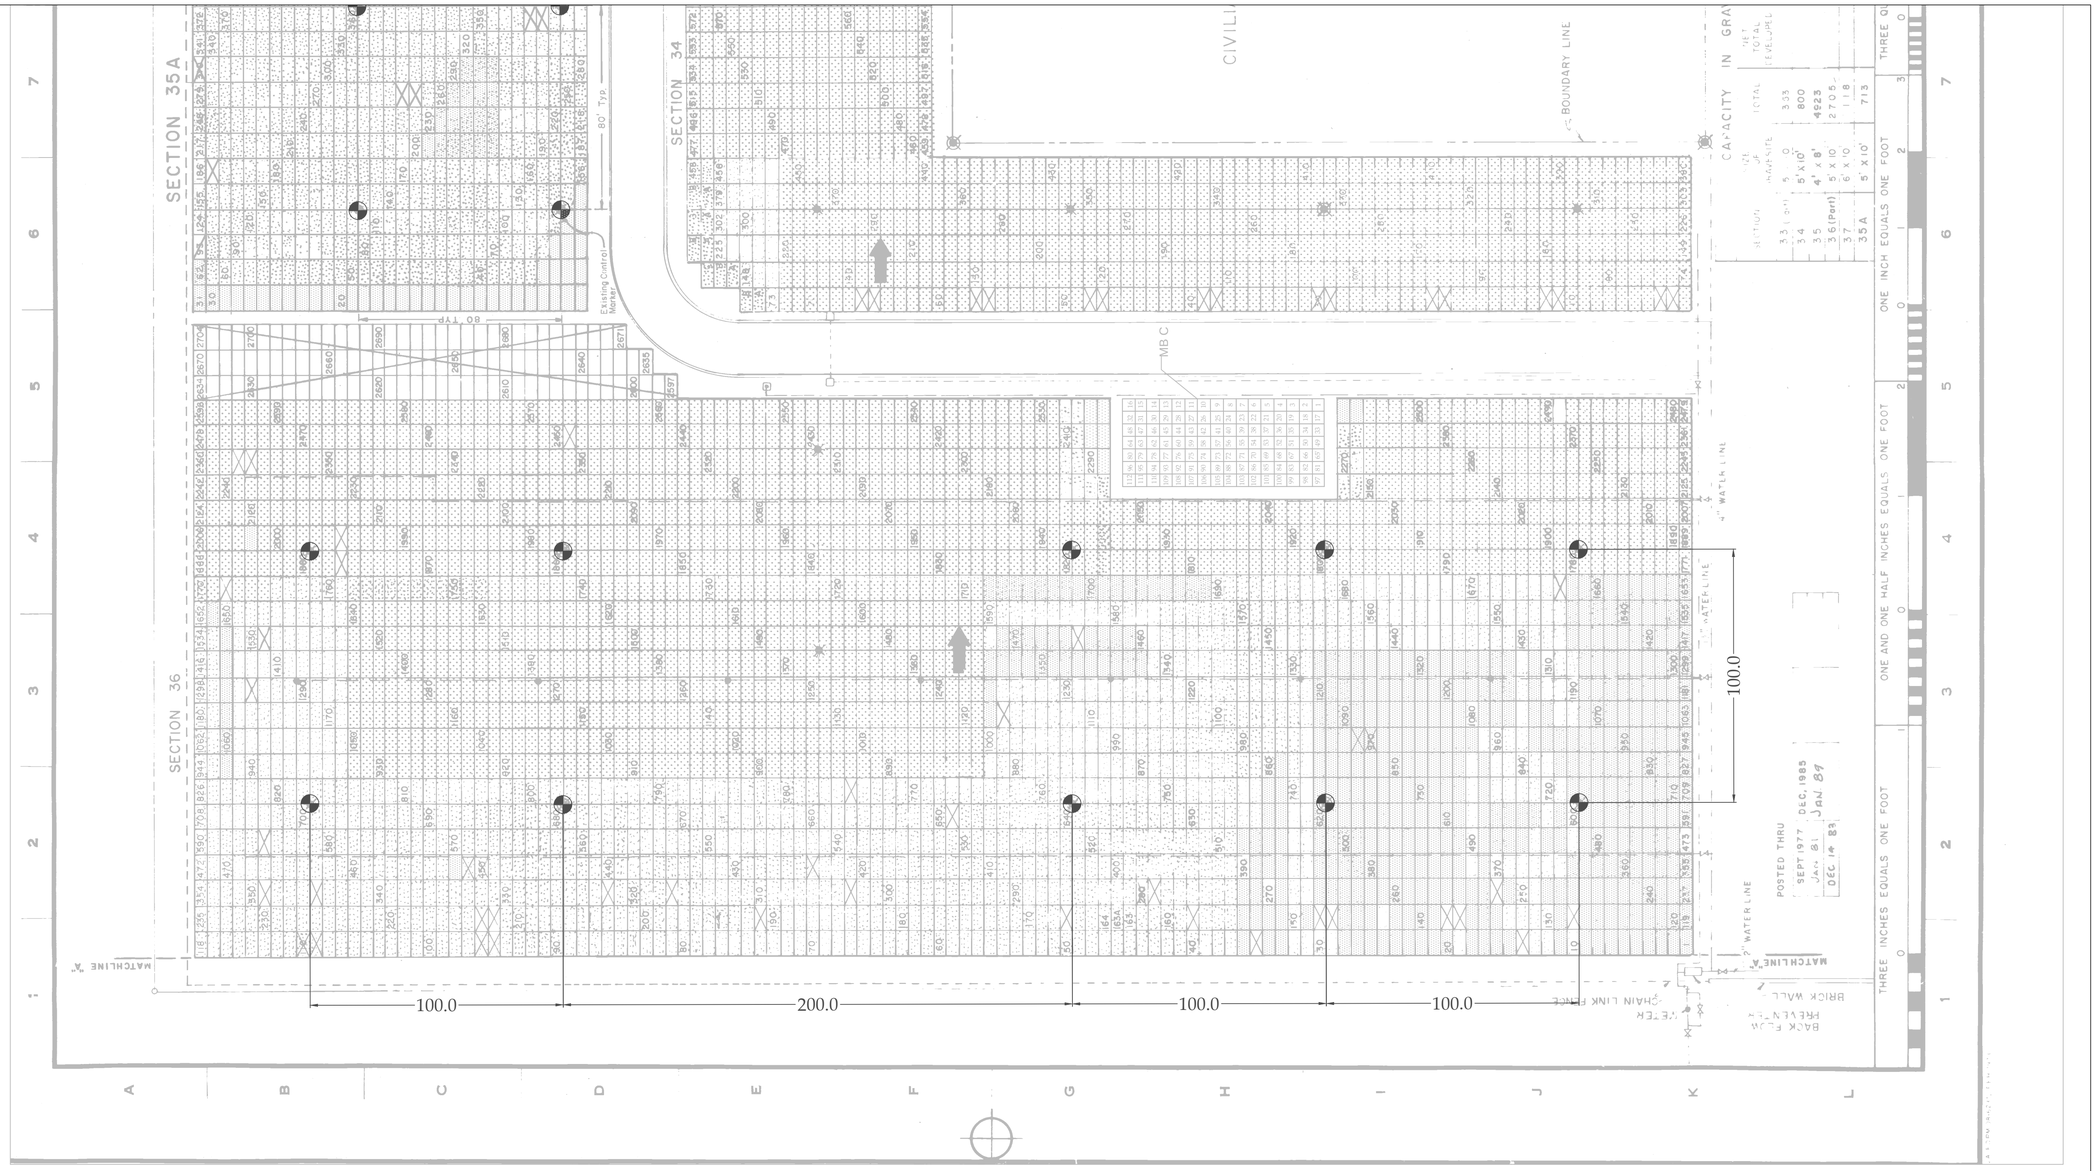

Revisions	Date

Scale 1 : 30

LEGEND
- AVAILABLE GRAVESITE
- SET ASIDE/RESERVED
- OBSTRUCTED GRAVESITE
- OCCUPIED GRAVESITE
- GRAVES FACE
- GRAVESITE CONTROL MONUMENT

National Cemetery Administration
Memorial Service Network II
Decatur, Georgia 30033

Drawing Title: Section 35A Layout Drawing	Project: Barrancas National Cemetery		Date: 1/14/13
	Location: Pensacola, FL		Project No.
Approved: Area Director	Building Number	Checked	Drawn: DCJ
Approved: Cemetery Director	Path: \\Cematla101\share\MSN II Drawings\Barrancas\Updated Layout		Drawing Title: 828LA044 Sections 34-37
			Dwg. Of

VA FORM 08-6231, FEB. 1983