


Location Map
Scale: 1" = 1000'

Legend

| | |
|--|---------------------------|
| | Existing Building |
| | Existing Curb |
| | Existing Edge of Pavement |
| | Existing Lighting |
| | Proposed Building |
| | Proposed Sidewalk |

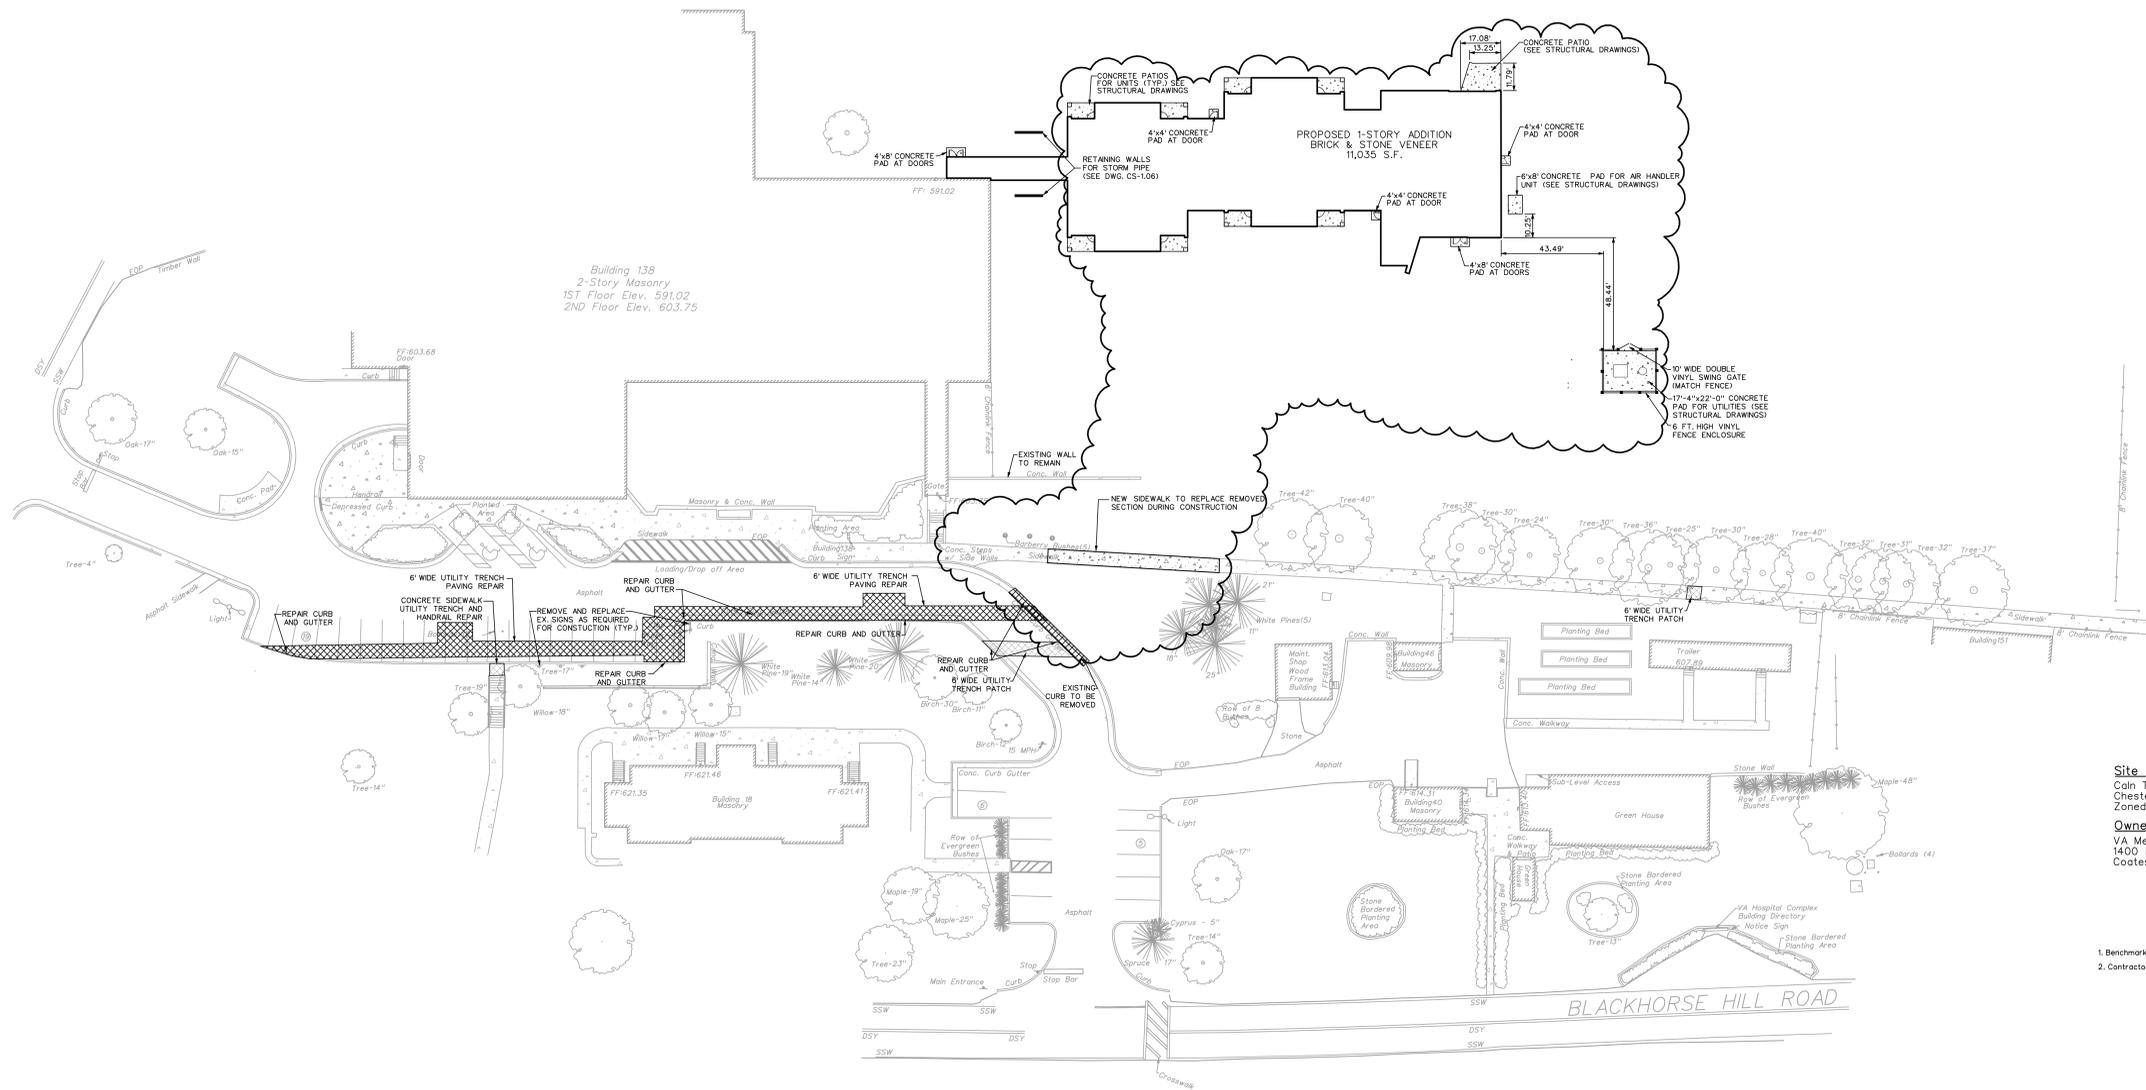

Site Data:
Cain Township
Chester County, PA
Zoned: R2 Residential District

Owner/Applicant:
VA Medical Center
1400 Blackhorse Hill Road
Coatesville, PA 19320

General Notes

- Benchmark: Storm Manhole Rim East of Bldg 138, El. 606.53
- Contractor shall verify all existing utility locations on-site prior to start of construction.





| | | | | | |
|---|----------|----------------------------------|---------------------|----------------|----------------------------|
| 25% Construction Documents | 02/23/10 | ASSOCIATES DIRECTOR PATIENT CARE | INFECTION CONTROL | SUPERVISOR M&O | PROJECT MANAGER |
| 50% Construction Documents | 04/23/10 | | | | |
| Revised per Chester Cty. SCD 1st Review | 06/25/10 | TEAMSTER | CONTRACTING OFFICER | GEN UTILITIES | SAFETY OFFICE |
| 100% Construction Documents | 06/28/10 | | | | |
| 100% Bld Documents | 08/05/10 | POLICE | PATIENT SAFETY | GEN PROPERTIES | SUPERVISOR PROJECT SECTION |
| Addendum #4 | 11/22/10 | | | | |
| Revisions | Date | | | | |

ARCHITECT / ENGINEERS :

H.F. Lenz Company
Mechanical, Electrical, Fire Protection, and Plumbing Engineer
1407 Scalp Avenue
Johnstown, PA 15004-3314
T: 814.269.9300
F: 814.269.9301

Francis Cauffman
2120 Arch Street
Philadelphia, PA 19103
Tel: (215) 568-8250
Fax: (215) 568-2639

E.E. EUSTACE ENGINEERING
447 West Moreland Road
3rd Floor
Willsie Grove, PA 19380
Tel: (215) 346-8707
Fax: (215) 346-8700
www.eustaceeng.com

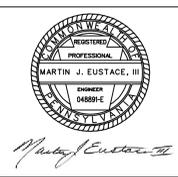

| | | |
|---|---|-------------------------------|
| Drawing Title CIVIL LAND DEVELOPMENT PLAN | Project Title CONSTRUCT HOSPICE COATESVILLE | Date 02-23-2010 |
| Approved: Chief Engineering Service | Drawn | Project No. 542-CSI-201 |
| Approved: Medical Center Director | Checked | DRAWING No. CS-1.01 |
| | Building Number | Dwg. Of |
| | Location COATESVILLE, PENNSYLVANIA | |