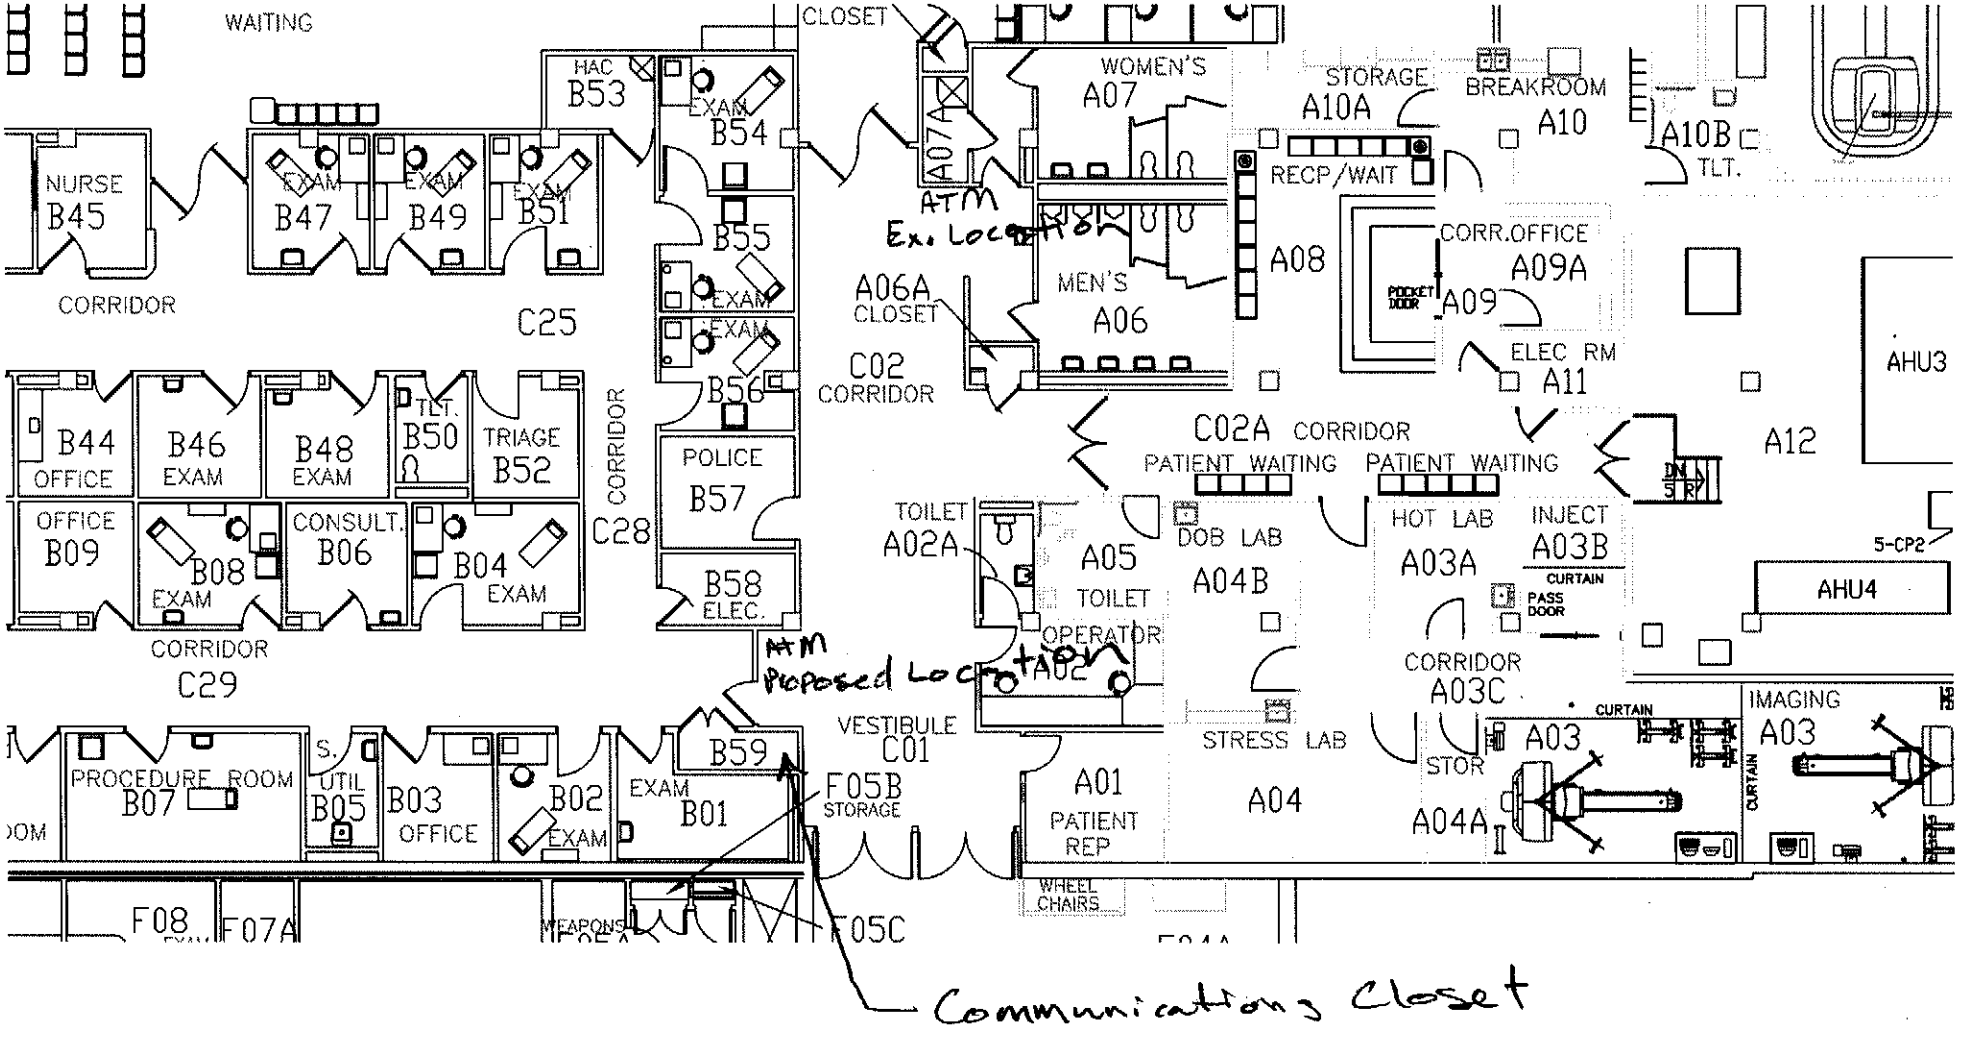
WAITING
NURSE
B45
CORRIDOR
EXAM
B47
EXAM
B49
EXAM
B51
HAC
B53
EXAM
B54
CLOSET
A07A
ATM
Ex. Location
WOMEN'S
A07
STORAGE
A10A
BREAKROOM
A10
A10B
TLT.
RECP/WAIT
B55
EXAM
EXAM
B56
C25
A06A
CLOSET
MEN'S
A06
A08
CORR.OFFICE
A09A
POCKET DOOR
A09
ELEC RM
A11
AHU3
C02
CORRIDOR
B44
OFFICE
B46
EXAM
B48
EXAM
TLT.
B50
TRIAGE
B52
CORRIDOR
POLICE
B57
C02A
CORRIDOR
PATIENT WAITING
PATIENT WAITING
A12
OFFICE
B09
B08
EXAM
CONSULT.
B06
B04
EXAM
C28
B58
ELEC.
TOILET
A02A
A05
TOILET
DOB LAB
A04B
HOT LAB
A03A
INJECT
A03B
CURTAIN
PASS DOOR
5-CP2
AHU4
CORRIDOR
C29
ATM
Proposed Location
OPERATOR
A02
CORRIDOR
A03C
IMAGING
A03
CURTAIN
PROCEDURE ROOM
B07
S.
UTIL
B05
B03
OFFICE
B02
EXAM
EXAM
B01
B59
VESTIBULE
C01
F05B
STORAGE
A01
PATIENT REP
STRESS LAB
A04
STOR
A04A
WHEEL CHAIRS
F08
F07A
WEAPONS
F05C
Communications Closet