

1 PARTIAL SITE LIGHTING PLAN  
1" = 50'

ELECTRICAL GENERAL NOTES


- A. REFER TO SHEET E2 FOR FOUNDATION DETAILS.  
B. PROVIDE AND INSTALL PULL BOXES AS NEEDED/ REQUIRED. SEE DETAILS SHEET E2.

ELECTRICAL KEYNOTES


- 1 APPROXIMATE LOCATION OF EXISTING MAIN SWITCHBOARD IN BUILDING TWO. REFER TO RISER DIAGRAM FOR ADDITIONAL WORK.  
2 THIS CIRCUIT SHALL ORIGINATE OUT OF NEW LIGHTING PANEL (PANEL N21PL) IN BUILDING 2. PANEL SHALL BE INTERFACED WITH SITE BUILDING MANAGEMENT SYSTEM (BMS) WHICH SHALL ENABLE/ DISABLE PHOTOCELL CONTROL BASED UPON TIME OF DAY SCHEDULE. PHOTOCELL INPUT SHALL BE INTO BMS AND SHALL BE LOCATED AT CENTRAL PLANT, BLDG. 148. PROVIDE AND INSTALL 200A, 4-POLE STARTER/CONTACTOR VIA BMS. PROVIDE HOA CONTROL SWITCH ON STARTER/CONTACTOR.  
3 EXISTING FLAG POLE AND EAGLE LIGHTING THIS AREA SHALL REMAIN. ENSURE CIRCUIT CONTINUITY THROUGHOUT PROJECT.  
4 APPROXIMATE LOCATION OF NEW PANEL N21PL.  
5 SECOND CIRCUIT IS FOR GFCI RECEPTACLE INTEGRAL TO POLE. (TYPICAL FOR ALL NEW POLES THIS SHEET).  
6 APPROXIMATE LOCATION OF NEW PANEL N21PR


NOTE:  
CONTRACTOR SHALL REFER TO LANDSCAPE PLANS AND SHALL COORDINATE ALL WORK BETWEEN ALL RESPECTIVE TRADES. ALL ELECTRICAL TRENCHING AND FOUNDATIONS SHALL BE IN PLACE TO INSTALLATION OF LANDSCAPING.

ARCHITECTS BEAZLEY MOLIÈRE  
architecture planning interior design  
337 233 0814  
FAX 233 7338  
P.O. BOX 51877  
LAFAYETTE, LOUISIANA 70505  
GBA PROJECT # 20101.C1

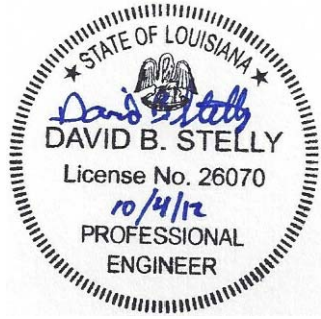

| REVISED |                  |
|---------|------------------|
| 1       | 4-19-13 REVISION |
|         |                  |
|         |                  |
|         |                  |

|   |   |  |  |                             |
|---|---|--|--|-----------------------------|
|  | <p><b>PARTIAL<br/>SITE LIGHTING PLAN</b></p> <p>Approved Chief of Engineering<br/><b>T. Lynn Rogers</b></p> | <p>Checked<br/><b>DBS</b></p>                    |  | <p>Drawn<br/><b>LAB</b></p> |
|   |   | <p>Location<br/><b>Alexandria, Louisiana</b></p> |  |                             |
| <p>Date<br/><b>October 5, 2012</b></p>  |   |  |  |                             |
| <p>Project No.<br/><b>502/90C</b></p>   |   |  |  |                             |
| <p><b>E1R</b></p>   |   |  |  |                             |

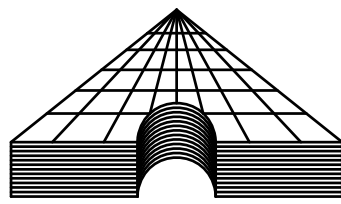

ASSOCIATED DESIGN GROUP, INC.  
3909 West Congress Street, Suite 201  
Lafayette, Louisiana 70506  
Phone: (337) 234-5710 Fax: (337) 237-1487  
E-Mail: [adginc@adginc.org](mailto:adginc@adginc.org)  
Project No. 12158