
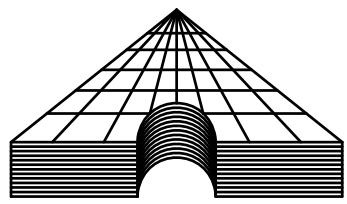



ELECTRICAL DEMOLITION KEYNOTES

- 1 CONTRACTOR SHALL REMOVE EXISTING LIGHTING STANDARD INCLUDING FOUNDATION. REPAIR GRADE TO MATCH SURROUNDING SURFACES. REMOVE EXISTING CONDUCTORS BACK TO SOURCE (CONDUIT TO REMAIN). OWNER SHALL HAVE FIRST RIGHT OF REFUSAL FOR ALL LIGHT FIXTURES, LAMPS AND/OR POLES. CONTRACTOR SHALL DISPOSE OF ALL NON-RETAINED ITEMS.
- 2 EXISTING FLAG POLE LIGHTING THIS AREA SHALL REMAIN IN PLACE AND FULL OPERATIONAL.

1 ELECTRICAL DEMO LIGHTING PLAN
1" = 50'

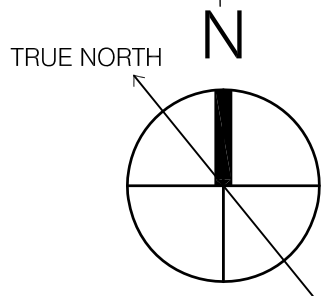

ASSOCIATED DESIGN GROUP, INC.
3909 West Congress Street, Suite 201
Lafayette, Louisiana 70506
Phone: (337) 234-5710 Fax: (337) 237-1467
E-Mail: adginc@adginc.org
Project No. 12158

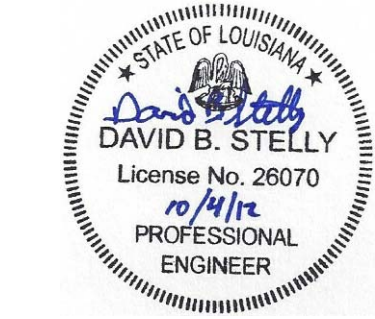

REVISED
1 4-19-13 REVISION

Drawing Title	ELECTRICAL DEMO PLAN	Approved Chief of Engineering T. Lynn Rogers	Department of Veterans Affairs		Location Alexandria, Louisiana
			Checked	LAB	
Date	October 5, 2012		Department of Veterans Affairs		
	Project No.		502/90C		
ED1R					



Department of
Veterans Affairs

ARCHITECTS BEAZLEY MOLIÈRE
architecture planning interior design
337 233 0814
337 233 7338
P.O. BOX 51877
LAFAYETTE, LOUISIANA 70505
GBA PROJECT # 20101.C1