

ASB-244 (+)  
Mastic

ASB-245 (+)

-252 (-)  
ASB-246 (-)

-  ACM Pipe Insulation
-  ACM Floor Tile & Mastic
-  ACM Linoleum and Mastic
-  ACM Floor Tile Mastic under NON-ACM Floor Tile
-  ACM Fire Door


-  ACM Sink Mastic/Undercoating
-  ACM Flue Pipe

## Louisville VAMC

Building 1 - 4th, Floor, Center  
Asbestos Sample Locations

Douglas W. Peters and Associates, Inc.  
Environmental Health Management  
3701 Taylorsville Road, Suite 1  
Louisville, Kentucky 40220  
(502) 454-8530 Fax (502) 454-8528



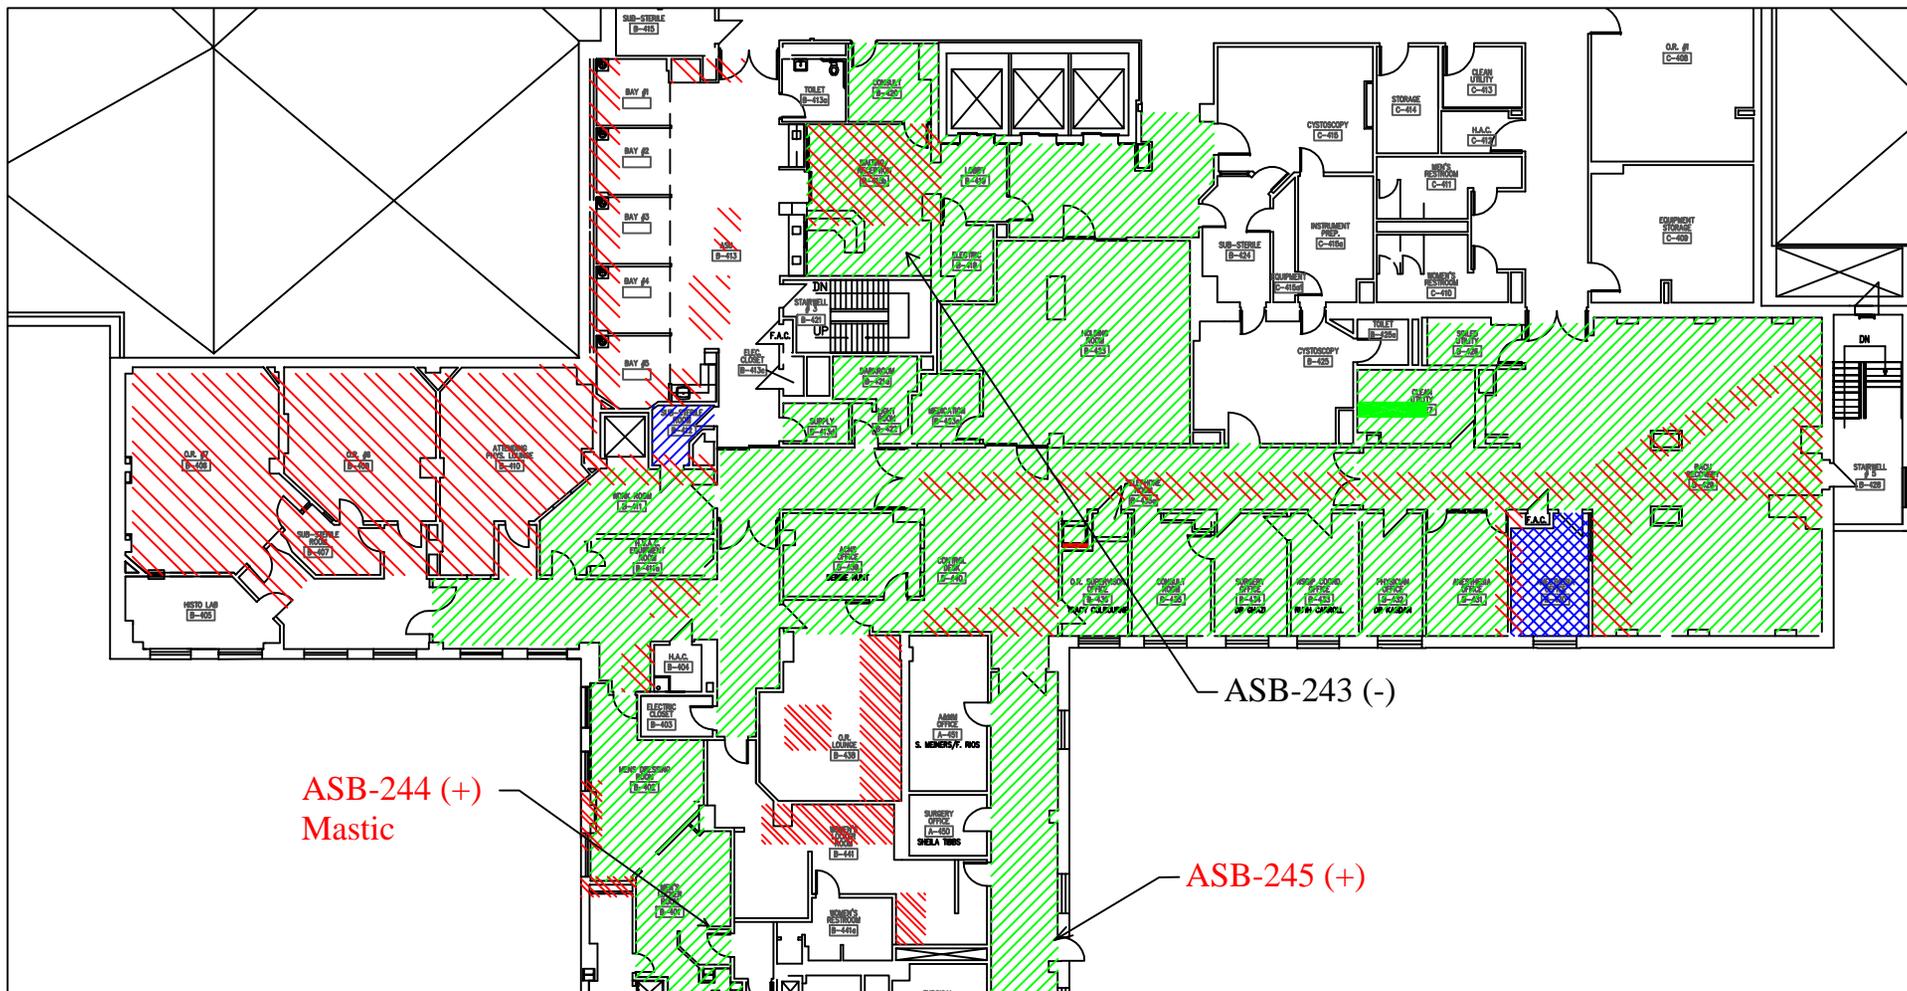

ASB-244 (+)  
Mastic

ASB-243 (-)

ASB-245 (+)

-  ACM Pipe Insulation
-  ACM Floor Tile & Mastic
-  ACM Linoleum and Mastic
-  ACM Floor Tile Mastic under NON-ACM Floor Tile
-  ACM Fire Door


-  ACM Sink Mastic/Undercoating
-  ACM Duct Insulation

## Louisville VAMC

Building 1 - 4th, Floor, West  
Asbestos Sample Locations

*Douglas W. Peters and Associates, Inc.*  
*Environmental Health Management*  
3701 Taylorsville Road, Suite 1  
Louisville, Kentucky 40220  
(502) 454-8530 Fax (502) 454-8528



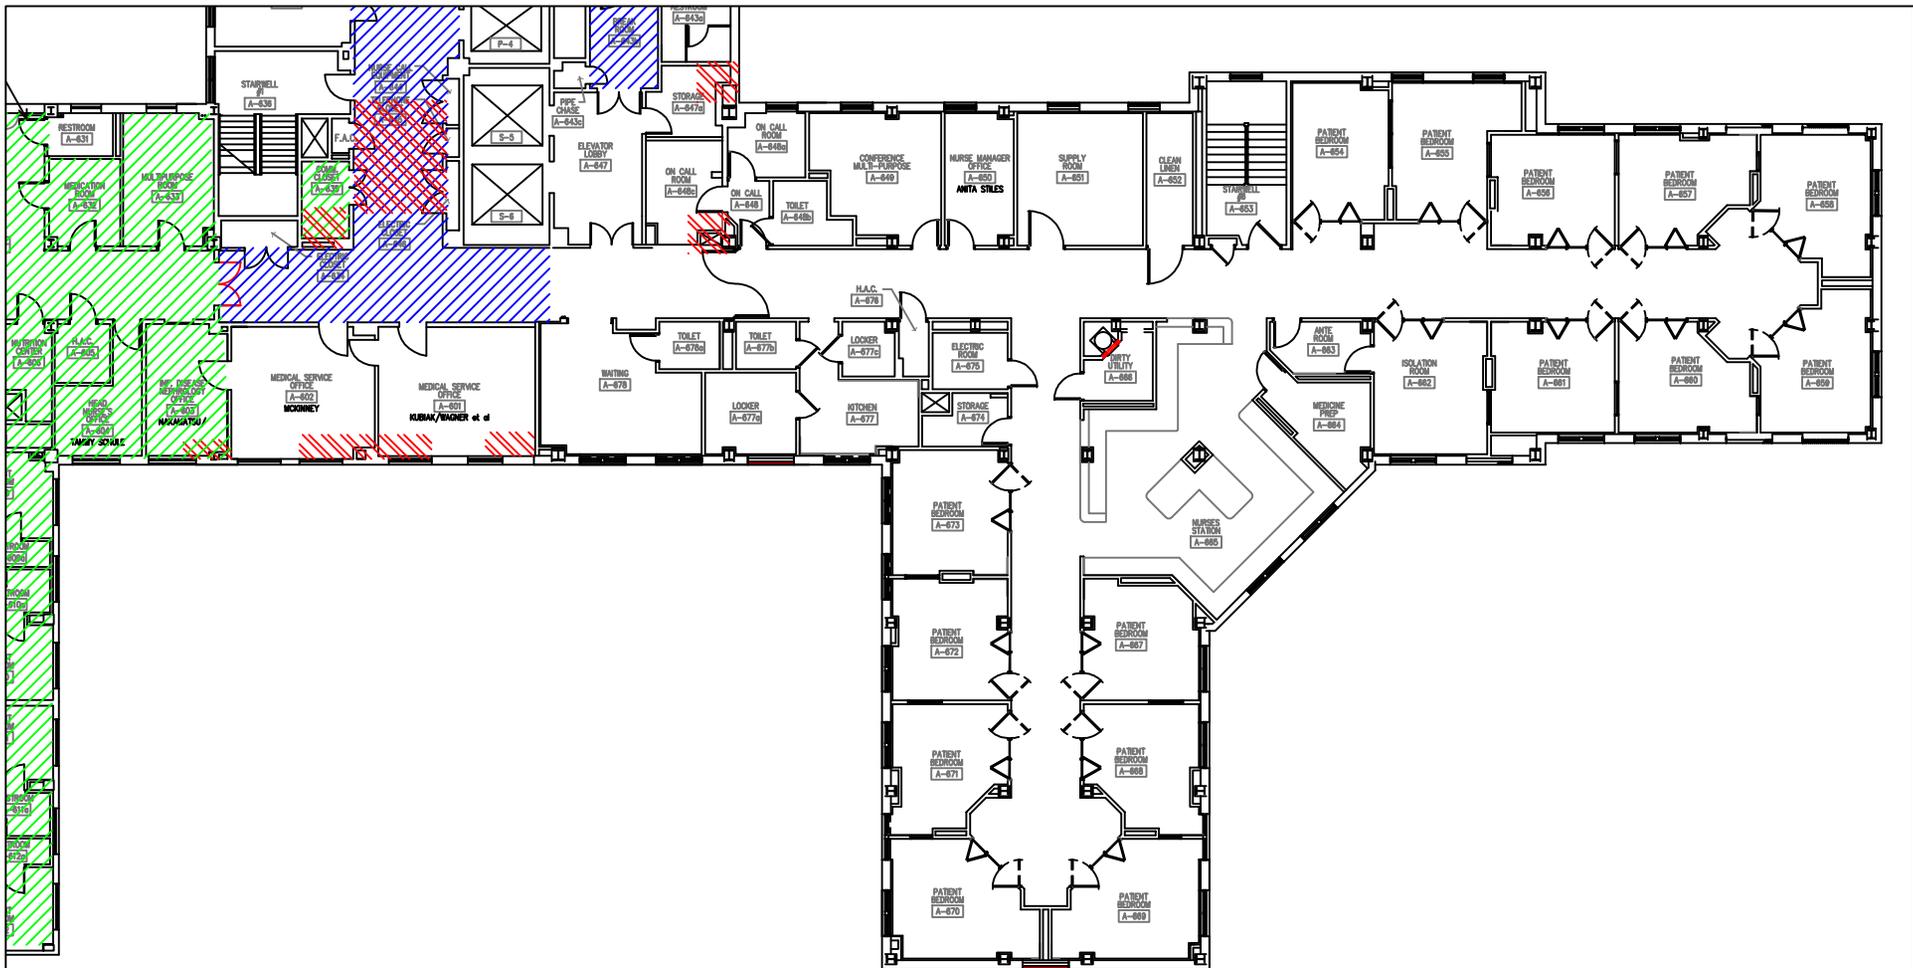

-  ACM Pipe Insulation
-  ACM Floor Tile & Mastic
-  ACM Floor Tile Mastic under NON-ACM Floor Tile

 ACM Fire Door

## Louisville VAMC


Building 1 - 6th Floor, North  
Asbestos Sample Locations

*Douglas W. Peters and Associates, Inc.*  
*Environmental Health Management*  
3701 Taylorsville Road, Suite 1  
Louisville, Kentucky 40220  
(502) 454-8530 Fax (502) 454-8528







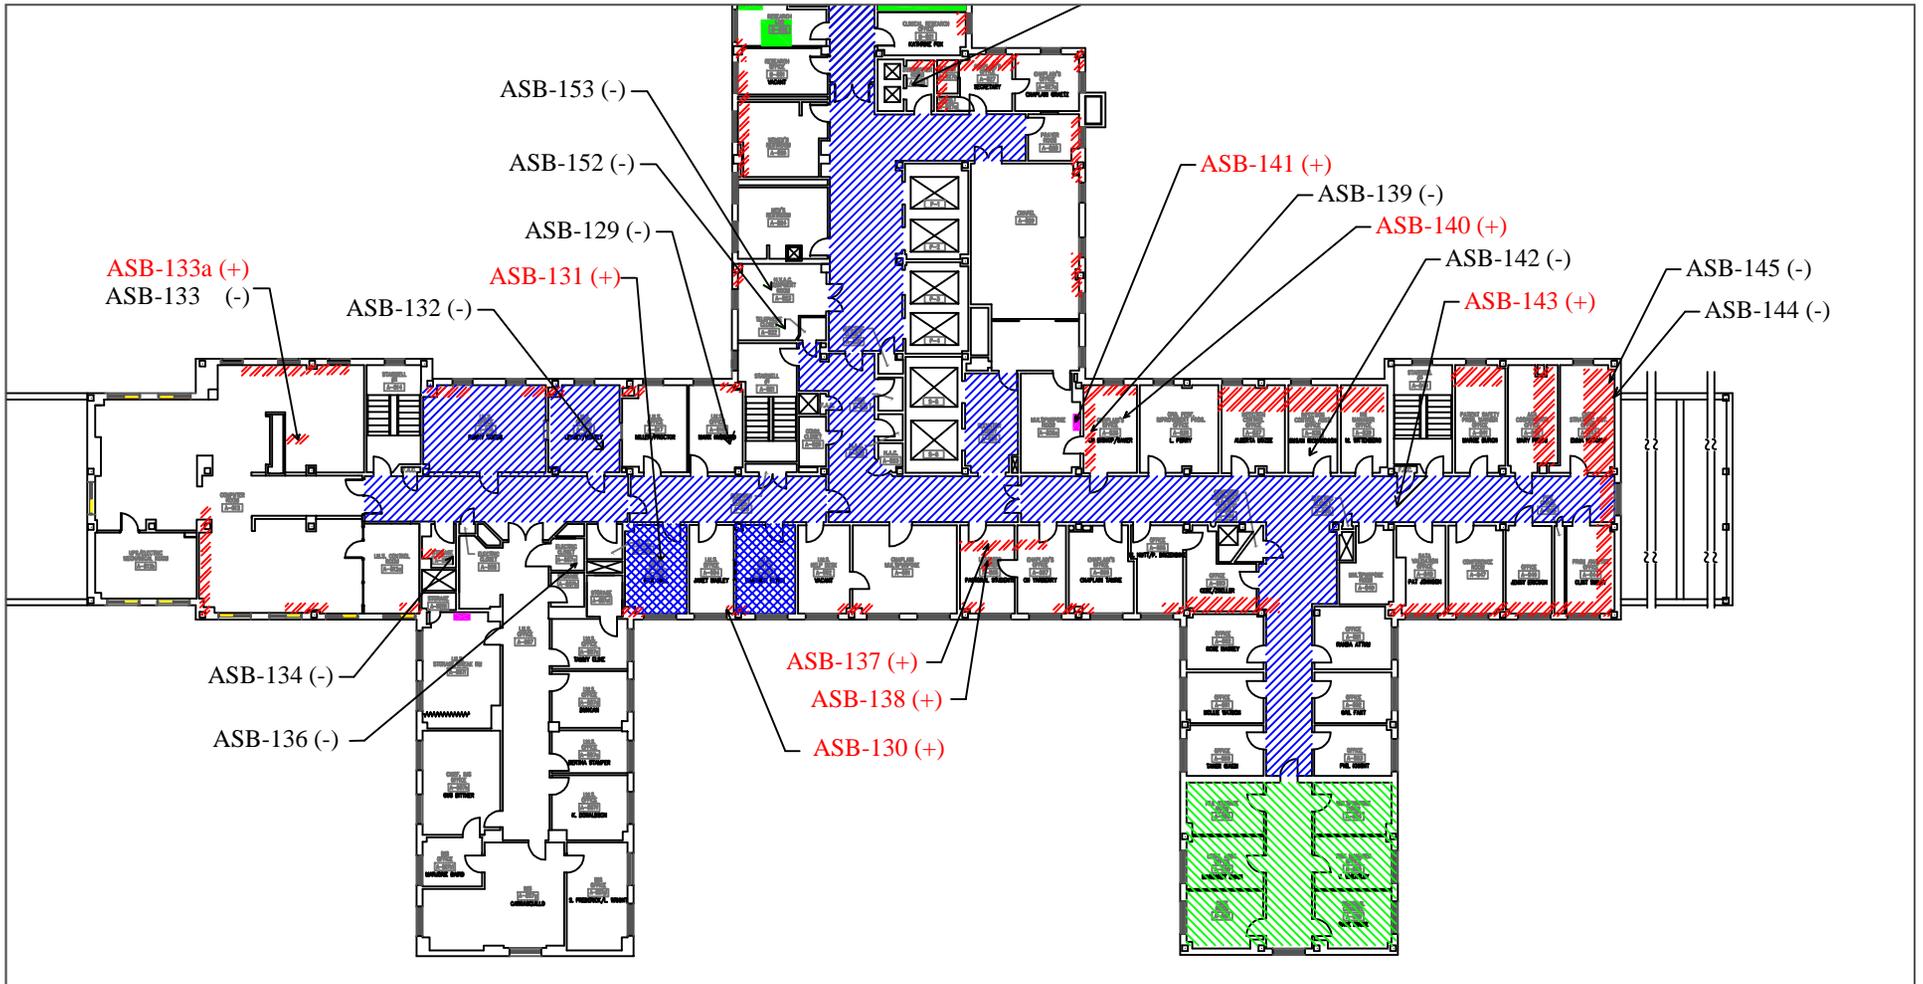

 ACM Pipe Insulation

 ACM Floor Tile & Mastic

 ACM Floor Tile with NON-ACM Mastic underneath

 ACM Floor Tile Mastic under NON-ACM Floor Tile

 ACM Sink Mastic/Undercoating

 ACM Counter Tops

*Douglas W. Peters and Associates, Inc.*  
*Environmental Health Management*  
 3701 Taylorsville Road, Suite 1  
 Louisville, Kentucky 40220  
 (502) 454-8530 Fax (502) 454-8528



## Louisville VAMC

Building 1 - 8th Floor, East  
 Asbestos Sample Locations