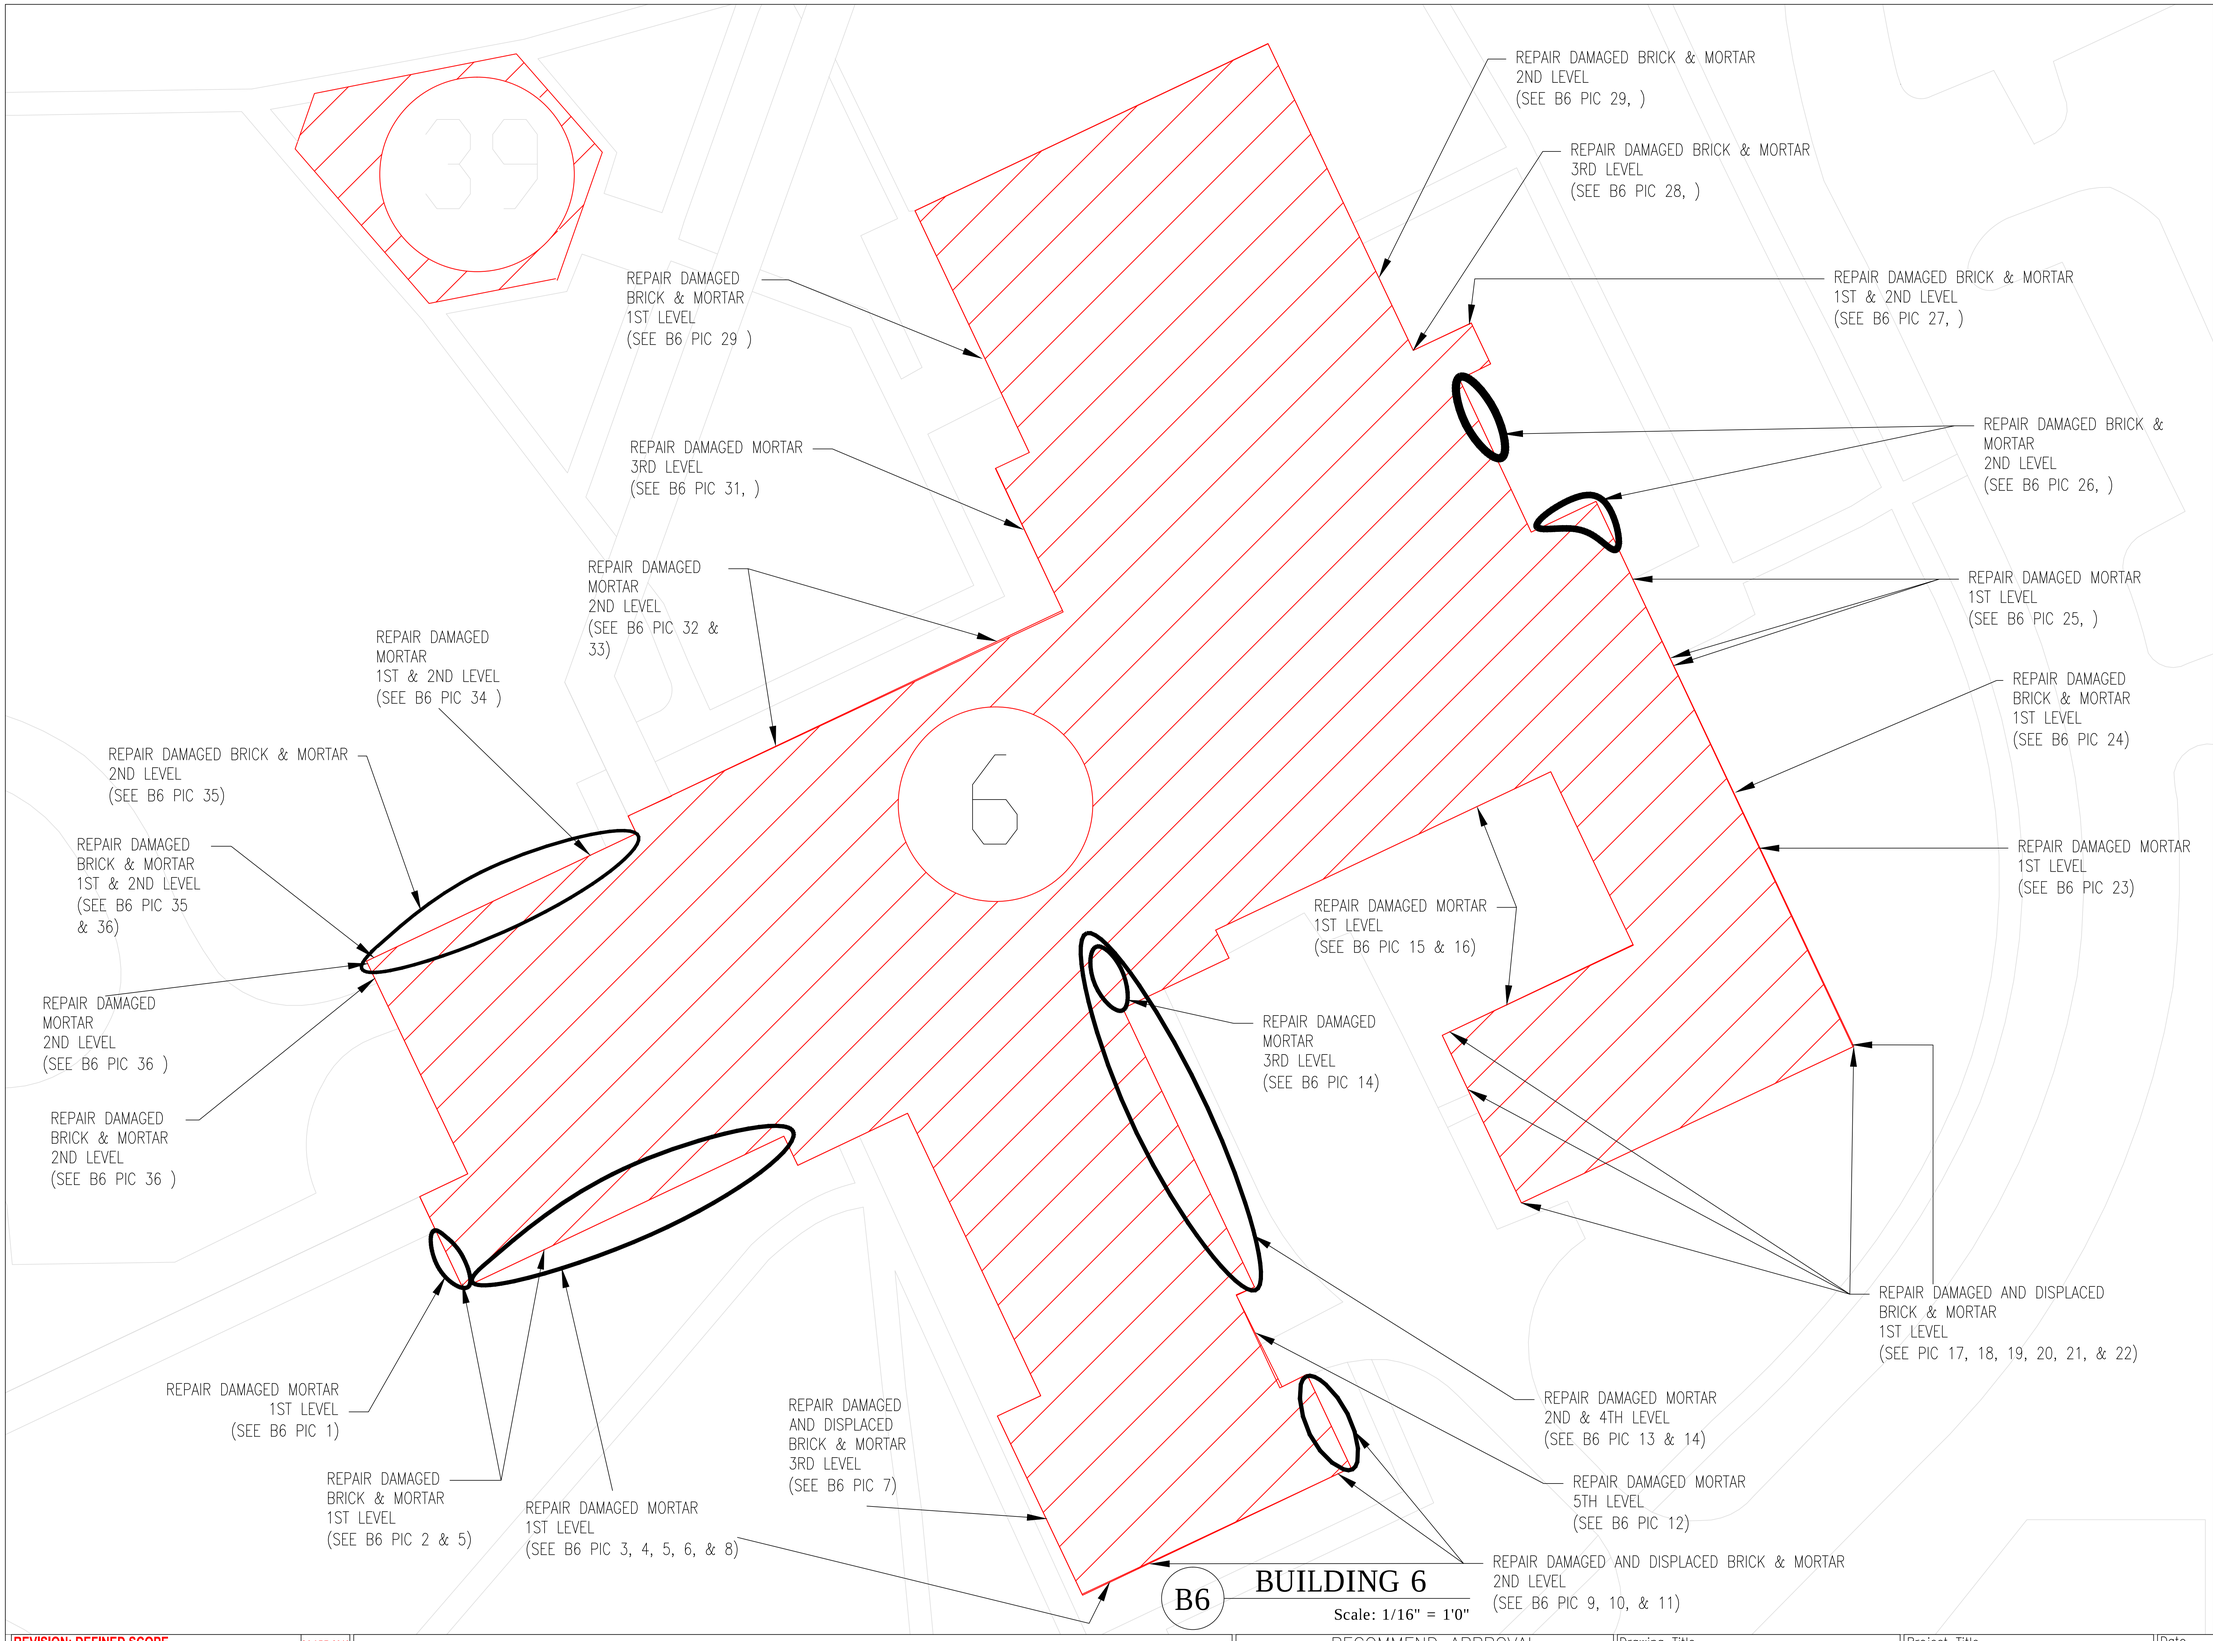

B6 BUILDING 6

Scale: 1/16" = 1'0"

GENERAL NOTES:

1. ALL LEVELS (FLOORS) ARE IDENTIFIED FROM THE EXTERIOR GROUND UNLESS NOTED OTHERWISE.
2. THE LEVELS REFERENCED MAY INCLUDE UPTO AN ADDITIONAL 6 FT TO THE ROOF.
3. MORTAR AND BRICK SHOULD MATCH THE EXISTING.
4. BORAL BRICK MOD 32 RED RANGE WIRECUT SHOULD BE USED TO MATCH THE EXISTING FACE BRICK.
5. DAMAGED BRICK AND MORTAR SHALL BE REMOVED AND REPLACED.
6. BRICK TO BE CLEANED AND EXISTING AREAS TO BE CLEAN AROUND WINDOWS
7. APPROXIMATELY 2,553 LINEAR FEET OF TUCKING + OR – 10%. CONTRACTOR TO VERIFY ON SITE
8. CONTRACTOR TO REPLACE BRICK AS REQUIRED, IF BRICK IS RE-USE IT WILL REQUIRED COR APPROVAL.

REVISION: DEFINED SCOPE	24 APR 2013
Revision	Date

RECOMMEND APPROVAL

REQUESTER	Date		
CHIEF OF SERVICE	Date	CHIEF OF STAFF	Date
ASSOC. DIR. PATIENT CARE SVC.	Date	ASSOC. DIR. for OPERATIONS	Date
APPROVAL BY: MEDICAL CENTER DIRECTOR			Date

Drawing Title: **TUCK POINTING PLAN FOR BUILDINGS 6**

Approved: Safety Manager/M&O Supervisor

Approved:Chief of Facilities Management Svr.

Project Title: **EXTERIOR MASONRY TUCK POINTING**

Building Number | Checked: JM | Drawn: ES

Location: W.G.(Bill) Hefner Medical Center, 1601 Brenner Ave, Salisbury NC 28144

Date: 4/23/2013

Project No.: 659-13-211

DRAWING NO.: GS-106

DWG. 6 OF 9

Department of Veterans Affairs