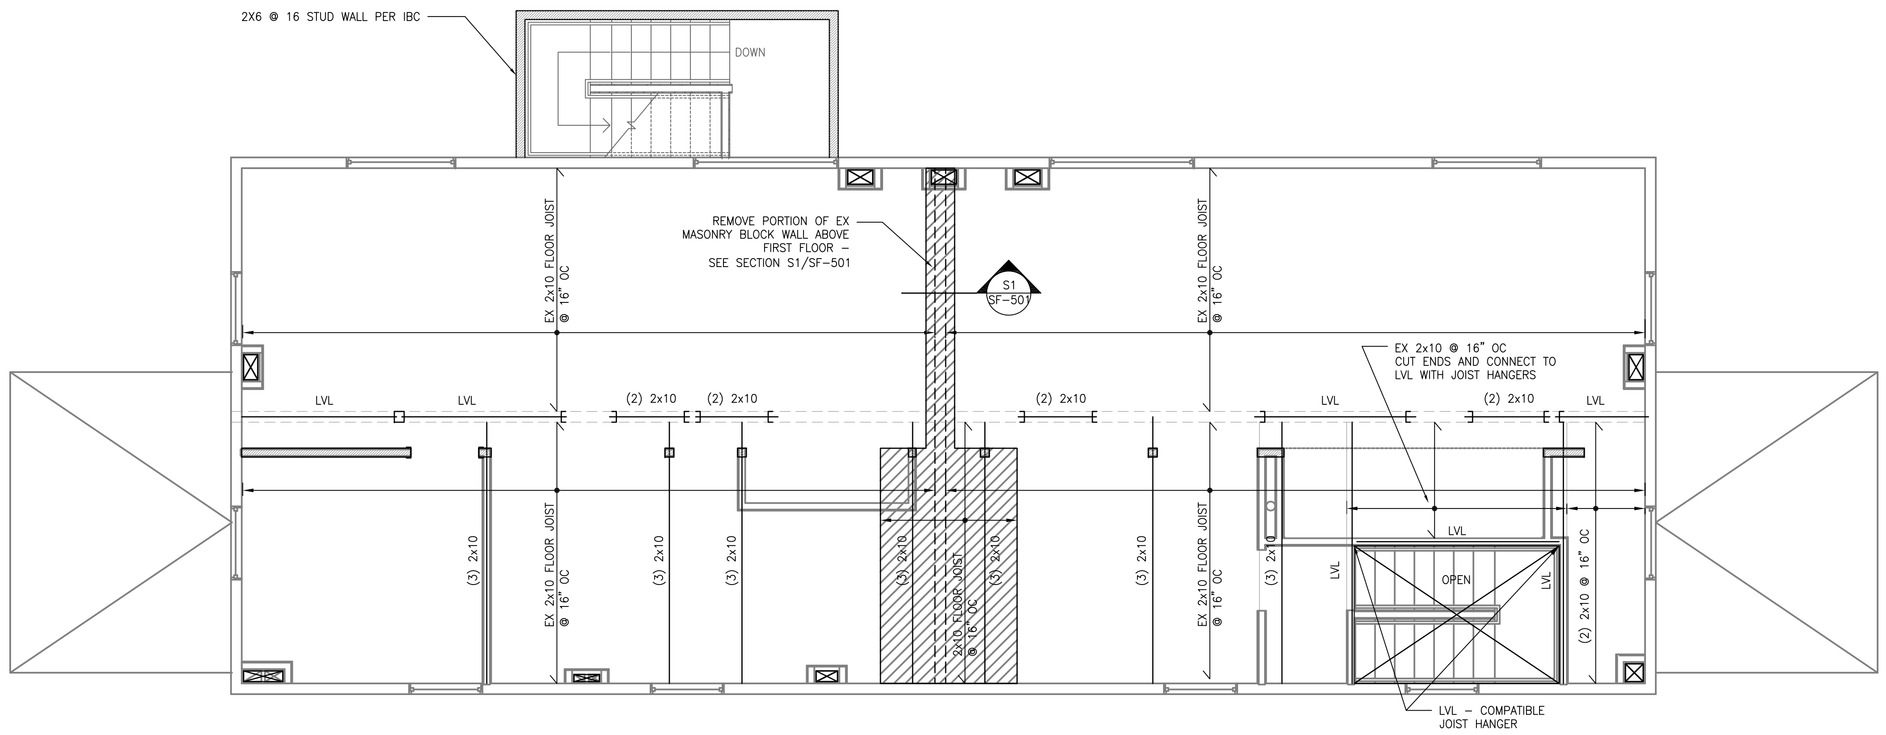

2 SECOND FLOOR FRAMING PLAN
SCALE: 1/4"=1'-0" DO NOT SCALE DRAWINGS

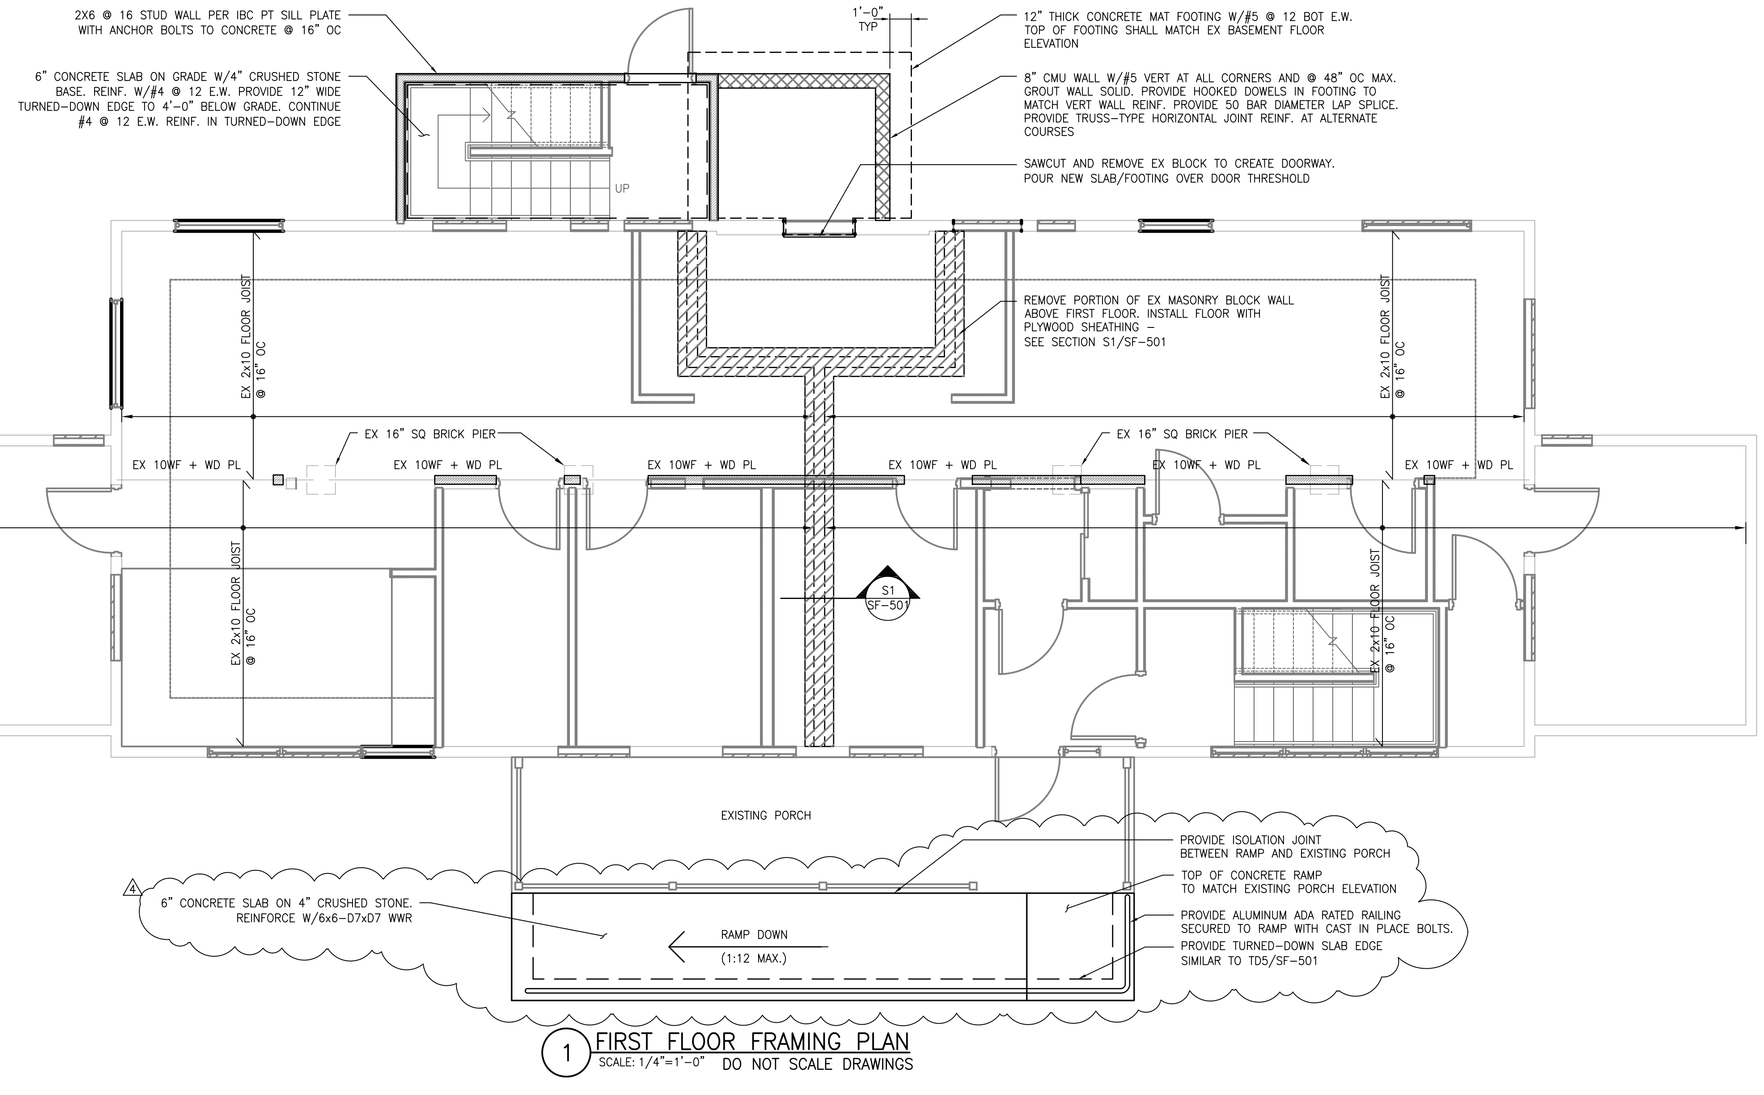

1 FIRST FLOOR FRAMING PLAN
SCALE: 1/4"=1'-0" DO NOT SCALE DRAWINGS

NOTES

1. EXISTING FIRST FLOOR ROUGH FLOOR ELEVATION SHALL BE DATUM ELEVATION 0'–0". ALL ELEVATIONS ARE REFERENCED FROM THIS ELEVATION UNO.
2. FINISHED FLOOR ELEVATION SHALL MATCH ADJACENT EXISTING FINISHED FLOOR ELEVATION UNO.
3. SEE DRAWING S–001 FOR GENERAL NOTES.
4. SEE DRAWING SF–501 FOR TYPICAL DETAILS AND SECTIONS.
5. COORDINATE ALL DIMENSIONS, OPENINGS, SLOPES AND DEPRESSIONS WITH ARCHITECTURAL DRAWINGS AND MECHANICAL DRAWINGS.
6. ═══ DENOTES WOOD FRAMED WALL. PROVIDE 2x4 STUDS @ 16" OC. PROVIDE SOLID BLOCKING AT MID–HEIGHT. CONSTRUCT PER IBC REQUIREMENTS.
7. CONTRACTOR IS RESPONSIBLE FOR PROVIDING TEMPORARY SHORING, SUPPORT AND BRACING OF EXISTING STRUCTURE DURING CONSTRUCTION. CONTRACTOR IS RESPONSIBLE FOR ANY DAMAGE THAT MAY OCCUR TO THE EXISTING STRUCTURE DURING CONSTRUCTION.
8. HEADERS ARE TO MATCH WIDTH OF STUD WALLS. PROVIDE PLYWOOD FLITCH PLATES AS REQUIRED.

PLAN NORTH
ACTUAL NORTH

BID DOCUMENTS

NO.	DESCRIPTION	DATE
4	ADDENDUM	4/30/13

CONSULTANTS:

PS&S

MILLER-REMICK CORPORATION
PROFESSIONAL ENGINEER

COMMONWEALTH OF PENNSYLVANIA REGISTERED PROFESSIONAL ENGINEER NICHOLAS C. MANNIX

ARCHITECT/ENGINEERS:

Miller-Remick LLC
M.E.P. & Structural Engineering
A Service Disabled Veteran Owned Small Business
1010 KINGS HIGHWAY SOUTH
BUILDING ONE – 1st FLOOR
CHERRY HILL, NEW JERSEY 08034
PHONE: (856)429-4000
FAX: (856)429-5002

Drawing Title: FRAMING PLANS FIRST AND SECOND FLOORS
Approved: Project Director
Project Title: **RENOVATE BUILDING #5**
Location: WILKES-BARRE VA MEDICAL CENTER, PENNSYLVANIA
Date: 01-10-2013 | Checked: NCM | Drawn: DS
Project Number: **693-11-107**
Building Number: 5
Drawing Number: SF-101
Dwg.# of 29

Office of Construction and Facilities Management
Department of Veterans Affairs

VA FORM 08-6231

three inches = one foot
one and one half inches = one foot
one inch = one foot
three quarters inch = one foot
one half inch = one foot
three eighths inch = one foot
one quarter inch = one foot
one eighth inch = one foot
P:\0499_DVA\1-0499-0009 Wilkes Barre Building 5\2_Cad\1_Current Submittal Phase\0_Structural\SF-101.dwg 4-30-13 11:09:24 AM GEustis