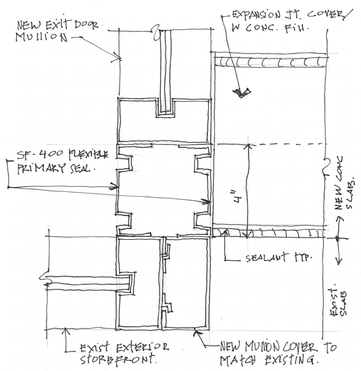

D1 EXPANSION JT DET AT EXIST STOREFRONT
3/4" = 1'-0"

NOTE: CONSTRUCTION SPECIALTIES, INC. FWS-600 IS BASIS OF DESIGN

D5 EXPANSION JOINT - CEILING, TYP
3" = 1'-0"

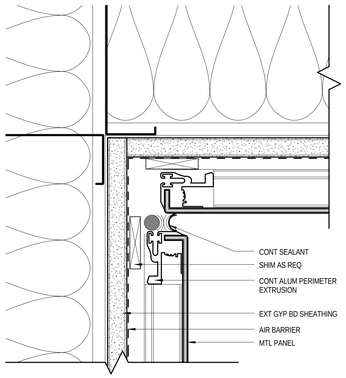

C4 INSIDE CORNER DETAIL, TYP
6" = 1'-0"

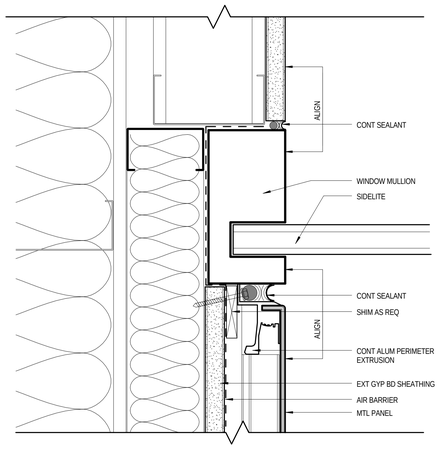

C6 WINDOW JAMB DETAIL, TYP
6" = 1'-0"

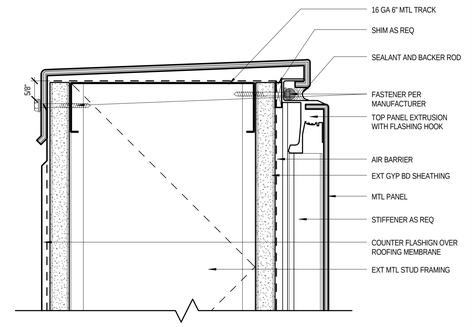

B8 PARAPET DETAIL, TYP
6" = 1'-0"

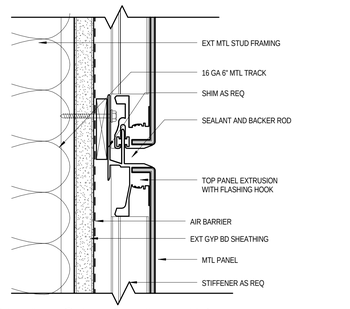

C8 HORIZONTAL JOINT DETAIL, TYP
6" = 1'-0"

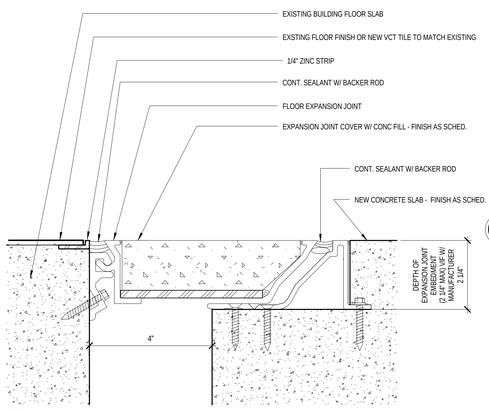

C1 EXPANSION JOINT AT FLOOR
6" = 1'-0"

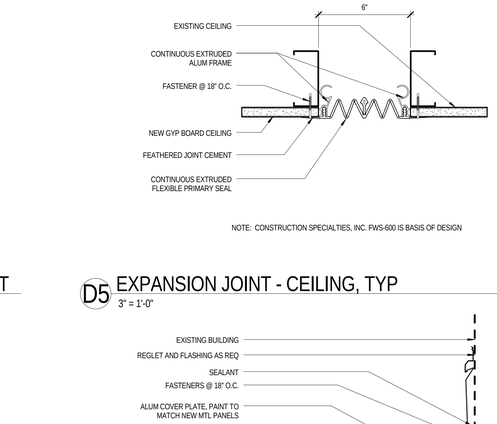

NOTE: CONSTRUCTION SPECIALTIES, INC. SRJW-600 IS BASIS OF DESIGN

C5 EXPANSION JOINT COVER - ROOF TO WALL, TYP
3" = 1'-0"

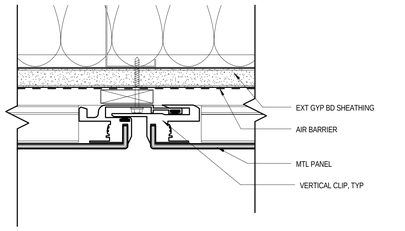

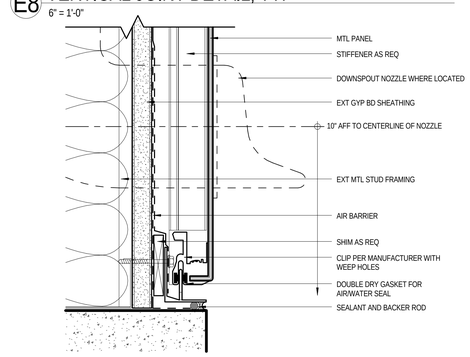

E8 VERTICAL JOINT DETAIL, TYP
6" = 1'-0"

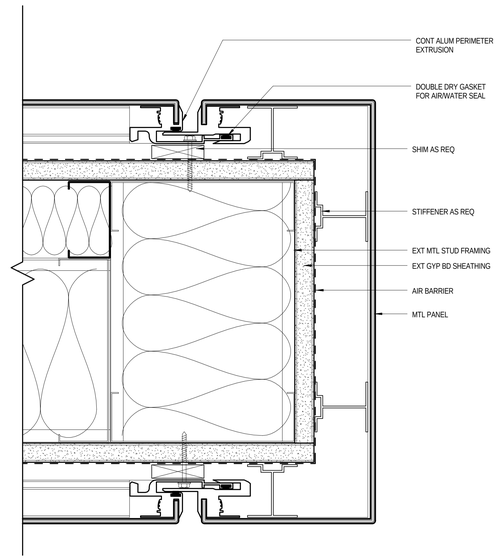

F6 OUTSIDE CORNER DETAIL, TYP
6" = 1'-0"

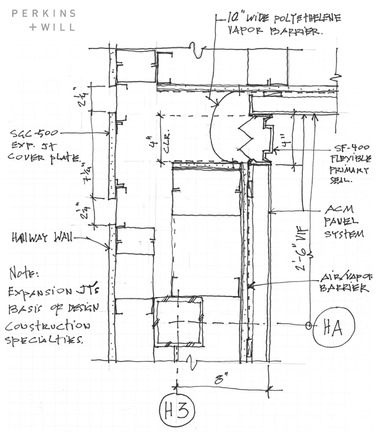

F1 EXPANSION JT DET AT ACM PANEL
3/4" = 1'-0"

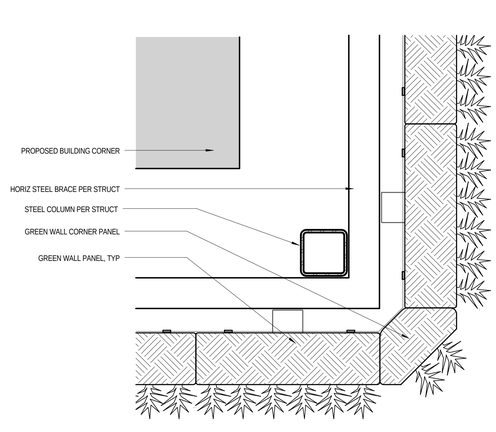

F2 GREEN WALL CORNER - PLAN VIEW, TYP
3" = 1'-0"

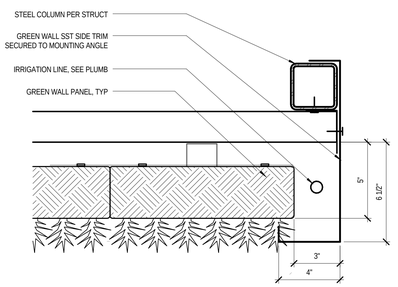

F4 GREEN WALL END PANEL- PLAN VIEW, TYP
3" = 1'-0"

A	Bid RFI Addendum	05-01-2013
#	Revision	Date

CONSULTANTS:

COST ESTIMATE
CUMMING
660 S. Figueroa St., Suite 900
Los Angeles, CA 90017
t 213.417.2360
f 213.408.4665

MEP ENGINEER
Glumac
617 West 7th St., Suite 500
Los Angeles, CA 90017
t 213.239.8866
f 213.239.8816

STRUCTURAL
Saiful - Bouquet
155 N. Lake Ave, Suite 600
Pasadena, CA 91101
t 626.304.2616
f 626.304.2676

LICENSED ARCHITECT — RUSSELL TRIBBLE — C 27279 — REG. 11-30-13 — STATE OF CALIFORNIA

ARCHITECT/ENGINEERS:

ARCHITECT
Perkins+Will
617 West 7th St., Suite 1200
Los Angeles, CA 90017
t 213.270.8400
f 213.270.8410

PERKINS +WILL

Drawing Title: COVERED WALKWAY GLAZING DETAILS

Approved: Project Director: Approver

Project Title: VETERANS AFFAIRS LONG TERM CARE CONVERSION SCI BUILDING 150

Location: LONG BEACH, CALIFORNIA

Date: FEBRUARY 22, 2013 | Checked: Checker | Drawn: Author

Project Number: 600-12-138 (PW#712016.001)

Building Number: –

Drawing Number: AS-510

Dwg of

Office of Construction and Facilities Management

Department of Veterans Affairs

100% FINAL CONSTRUCTION DOCUMENTS
FULLY SPRINKLERED BUILDING

5/2/2013 2:29:08 PM C:\temp\712016_vatitloc-walkway_Rsstacy.rvt

VA FORM 08-6231