


one eighth inch = one foot
one quarter inch = one foot
one half inch = one foot
three eighths inch = one foot
one inch = one foot
one and one half inches = one foot
three inches = one foot

5/22/2013 6:11:13 PM c:\pwworking\VA\LTCA\VA_Bldg.dwg

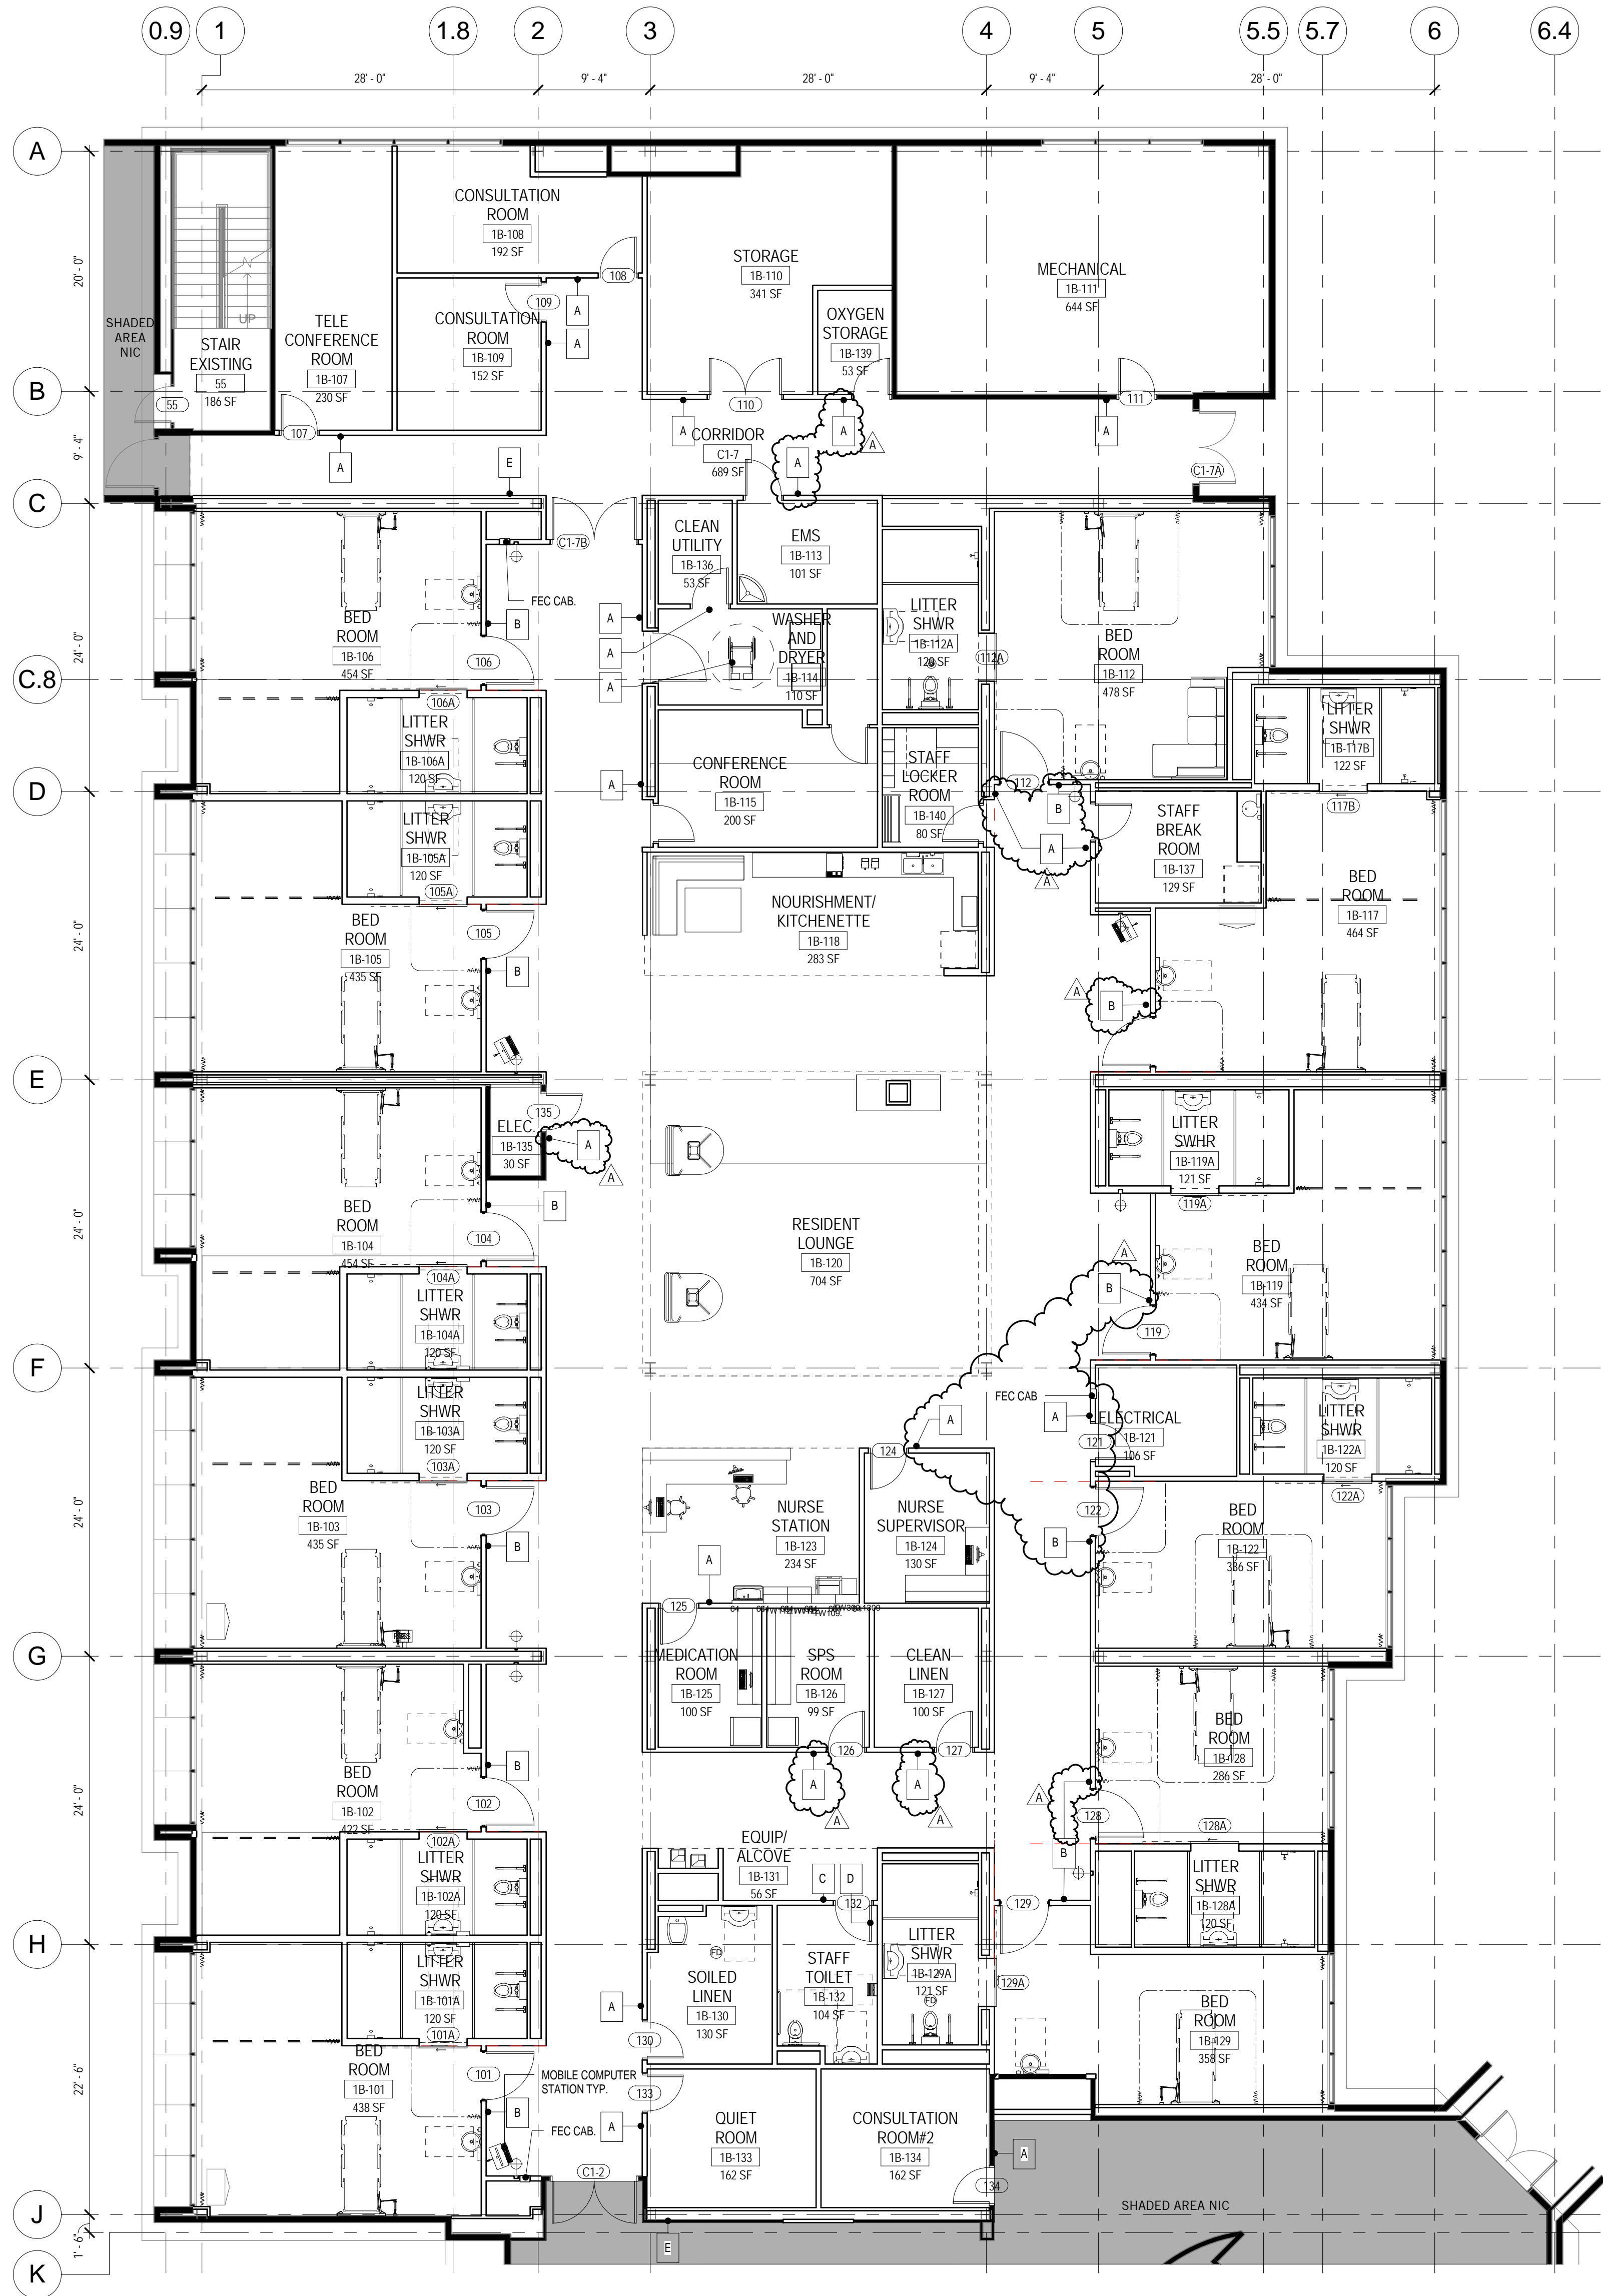

GRAPHICS AND SIGNAGE LEGEND

- 1210
EXAM
ROOM NUMBER / ROOM NAME
- 1210
EXAM
ROOM NUMBER / ROOM NAME
- PERSONAL IDENTIFICATION SECTION
- GENDER DOOR SIGN
- ROOM NAME / GENDER / ADA
- SUITE IDENTIFICATION
UNIT NAME
ACCESS INFORMATION

GRAPHICS AND SIGNAGE GENERAL NOTES:

1. SIGNAGE TO BE TAKE-FORM VIVID OR EQUIVALENT TYPICAL FOR INTERIOR SIGNAGE.
2. VERIFY ROOM NUMBERS AND ROOM TITLES PRIOR TO ORDERING SIGNAGE.

Scale: As indicated

CONSULTANTS:

COST ESTIMATE
CUMMING
600 S. Figueroa St., Suite 600
Los Angeles, CA 90017
1213.417.2360
1213.408.4665

MEP ENGINEER
Glumac
617 West 7th St., Suite 500
Los Angeles, CA 90017
1213.239.8866
1213.239.8816

STRUCTURAL
Saitul - Bouquet
155 N. Lake Ave., Suite 600
Pasadena, CA 91101
626.304.2616
626.304.2676

ARCHITECT/ENGINEERS:

ARCHITECT
Perkins + Will
617 West 7th St., Suite 1200
Los Angeles, CA 90017
1213.270.8400
1213.270.8410

**PERKINS
+ WILL**

Drawing Title
LEVEL 01 OVERALL GRAPHIC AND SIGNAGE
PLAN

Approved: Project Director
Approver

Project Title
VETERANS AFFAIRS
LONG TERM CARE CONVERSION
SCI BUILDING 150

Location
LONG BEACH, CALIFORNIA

Date
FEBRUARY 22, 2013

Checked
Checker

Drawn
Author

Project Number
600-12-138
(PVI#712016.000)
Building Number
—
Drawing Number
AG-101
Dwg of

Office of
Construction
and Facilities
Management

Department of
Veterans Affairs