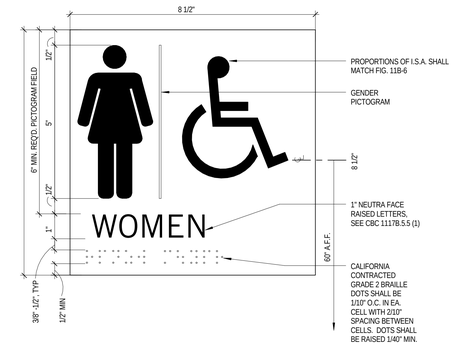

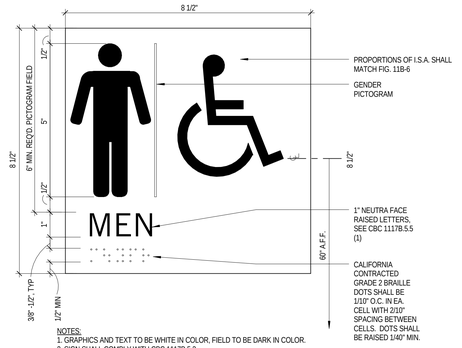

NOTES:
1. GRAPHICS AND TEXT TO BE WHITE IN COLOR, FIELD TO BE DARK IN COLOR.
2. SIGN SHALL COMPLY WITH CBC 1117B.5.2.
3. TACTILE RESTROOM SIGN LOCATED ON LATCH SIDE OF DOOR IN UPPER CASE, SAN SERIF LETTERS, CALIFORNIA GRADE 2 BRAILLE

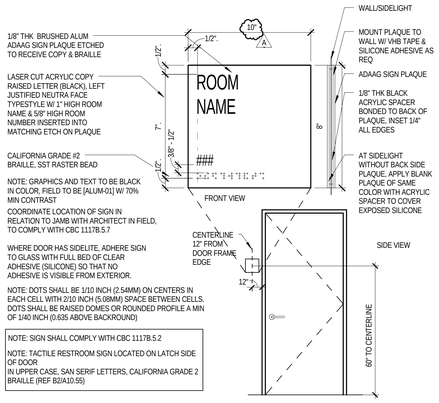

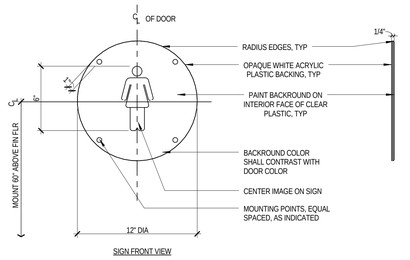

WOMEN ACCESSIBLE DOOR SYMBOL

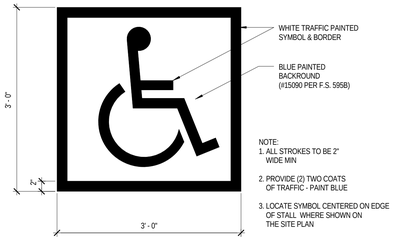

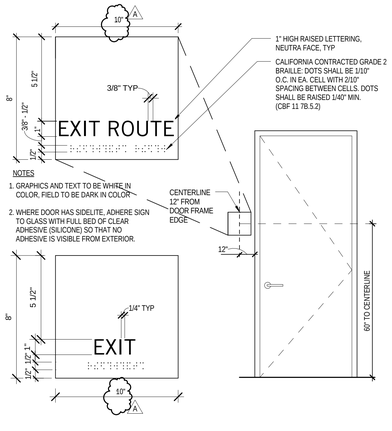

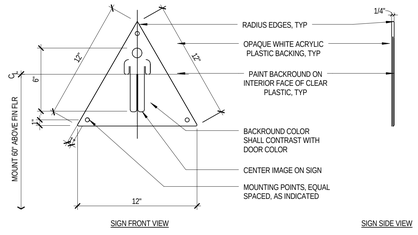

MEN ACCESSIBLE DOOR SYMBOL

SYMBOL NOTES:
1. GRAPHIC AND BORDER TO BE WHITE IN COLOR. CONTRAST BETWEEN CHARACTERS & BACKGROUND MUST BE 70% MIN
2. SYMBOL SHALL BE DISTINCTLY DIFFERENT FROM DOOR IN COLOR AND CONTRAST
3. PROVIDE DIRECTIONAL SIGNS WHEN REQ'D
4. ATTACH SYMBOLS USING ADHESIVE AND FLATHEAD WOOD SCREWS
5. CENTER SYMBOL ON DOOR WIDTH.
6. ISA SYMBOL REQUIRED ON DOOR, WALL OR SEPARATE SIGN. REQUIRED NOT TO BE RAISED FROM GROUND (TYP. OF DOOR SIGN)

F4 INT'L SYMBOL OF ACCESSIBILITY (ISA)1
1" = 1'-0"

#	Revision	Date
A	Bid RFI Addendum	05/01/2013

CONSULTANTS:

COST ESTIMATE
CUMMING
660 S. Figueroa St., Suite 900
Los Angeles, CA 90017
t 213.417.2360
f 213.408.4665

MEP ENGINEER
Glumac
617 West 7th St., Suite 500
Los Angeles, CA 90017
t 213.239.8866
f 213.239.8816

STRUCTURAL
Saiful - Bouquet
155 N. Lake Ave, Suite 600
Pasadena, CA 91101
t 626.304.2616
f 626.304.2676

LICENSED ARCHITECT — ROBERT TRIPPET — C-29811 — REN. 11-30-14 — STATE OF CALIFORNIA

ARCHITECT/ENGINEERS:

ARCHITECT
Perkins+Will
617 West 7th St., Suite 1200
Los Angeles, CA 90017
t 213.270.8400
f 213.270.8410

PERKINS +WILL

Drawing Title: GRAPHICS AND SIGNAGE DETAILS

Approved: Project Director: Approver

Project Title: VETERANS AFFAIRS LONG TERM CARE CONVERSION SCI BUILDING 150

Location: LONG BEACH, CALIFORNIA

Date: FEBRUARY 22, 2013 | Checked: Checker | Drawn: Author

Project Number: 600-12-138 (PW#712016.000)

Building Number: –

Drawing Number: AG-501 Dwg of

Office of Construction and Facilities Management

Department of Veterans Affairs

100% FINAL CONSTRUCTION DOCUMENTS
FULLY SPRINKLERED BUILDING

5/2/2013 6:16:27 PM c:\temp\ARCH_VA_LTCU VA_lesacaj.rvt

VA FORM 08-6231