


1. Removed bollards	5/7/13
Revisions	Date

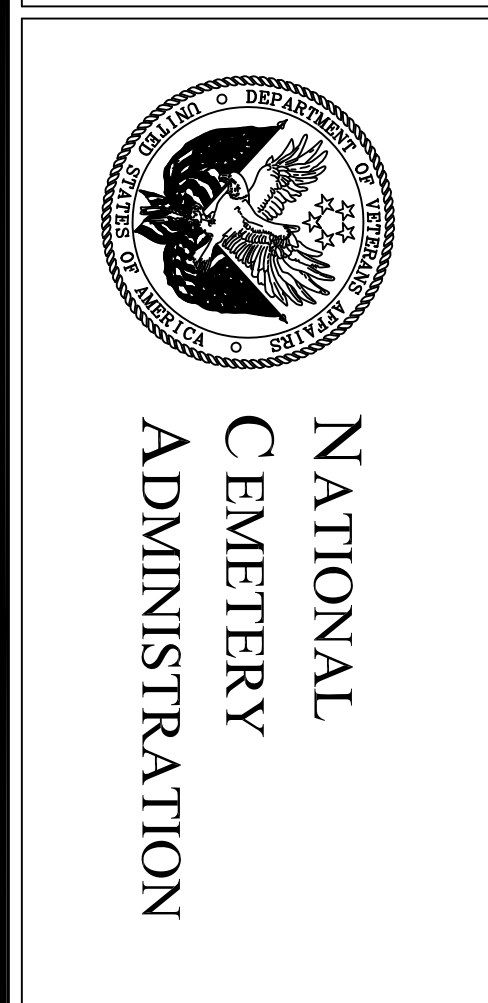

Drawing Title	Project Title	Date
FOUNDATION PLAN	CONSTRUCT MATERIAL STO. BINS	05/07/2013
Approved: Division Chief	Building Number	Project No.
Approved: Service Director	Location	904-13-101
	Checked	Drawn
	CFC	CFC
		Dwg. 6 Of 7

FINAL FOR CONSTRUCTION
May 7, 2013