




8 PLAN DETAIL
3" = 1'-0"

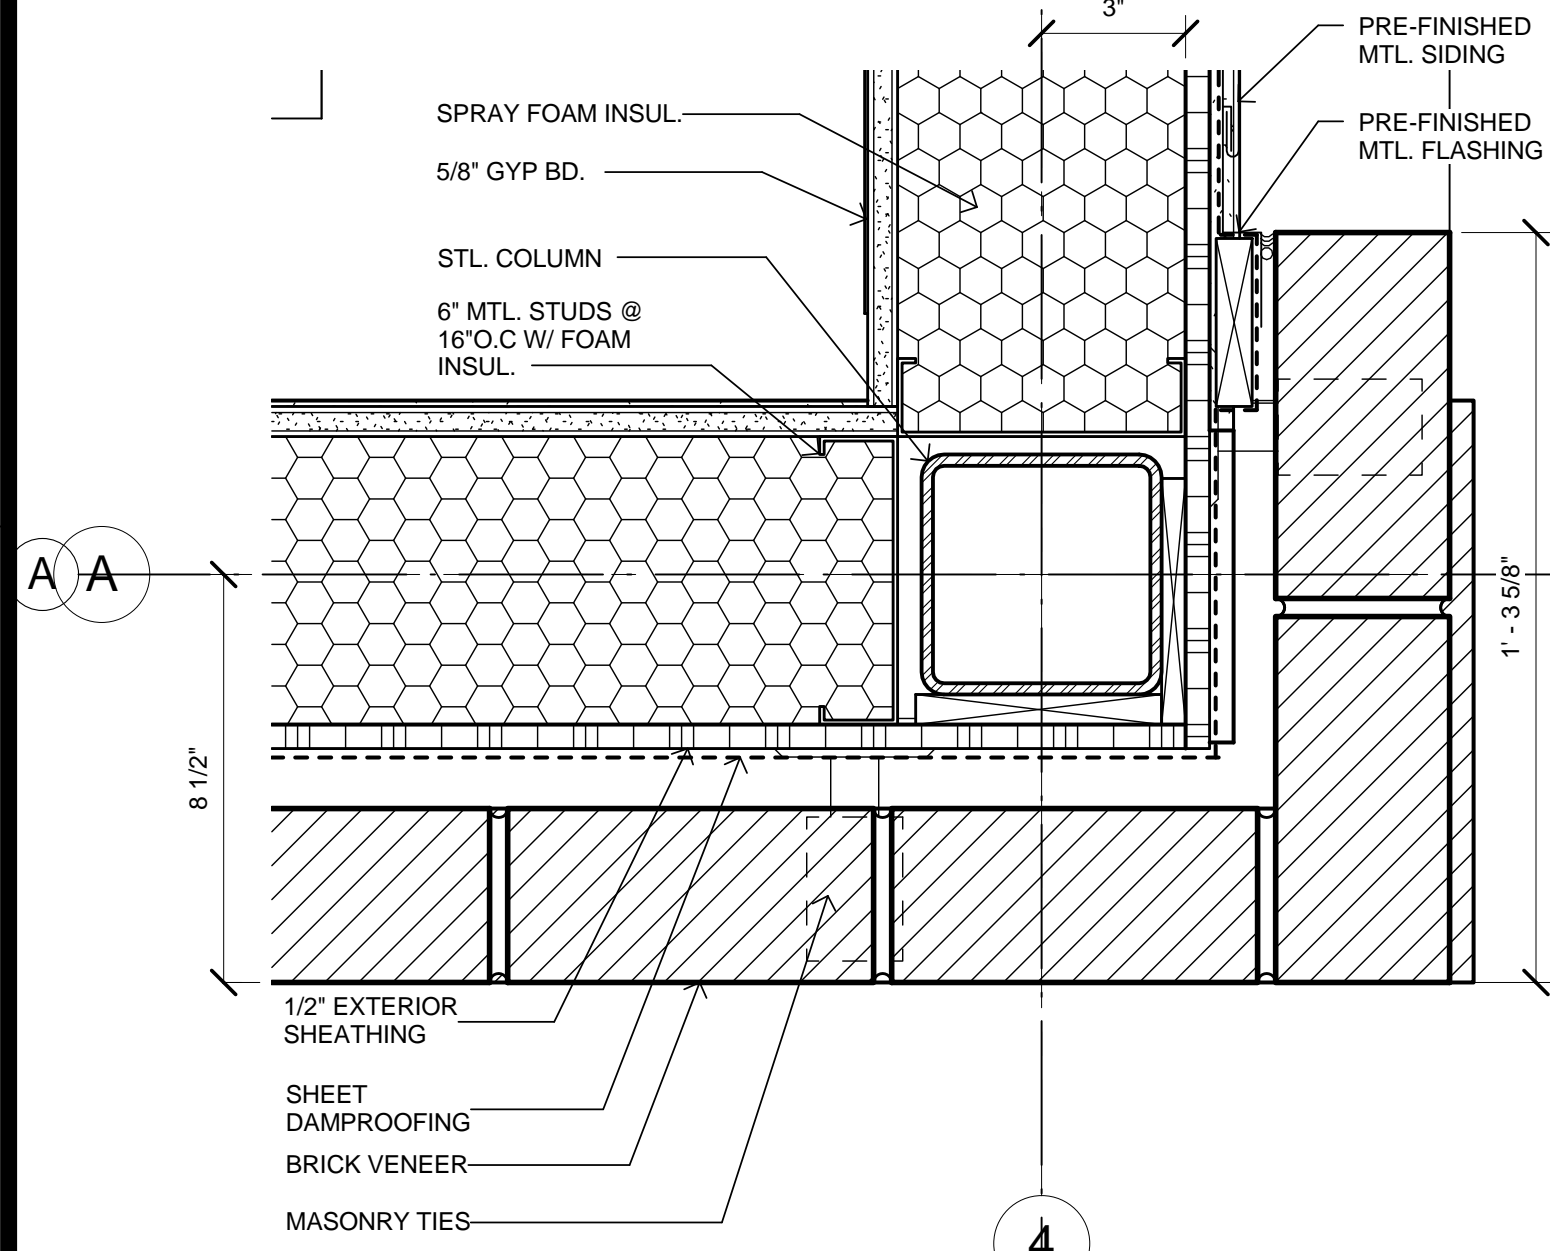


9 PLAN DETAIL
3" = 1'-0"

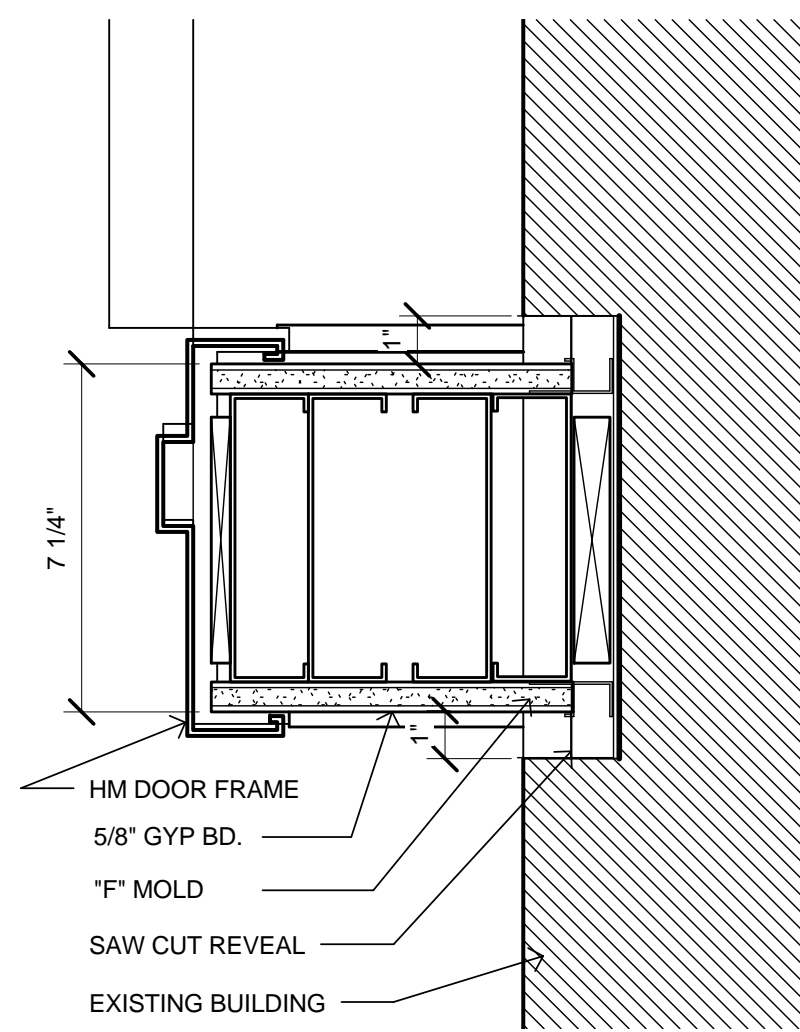


10 PLAN DETAIL
3" = 1'-0"

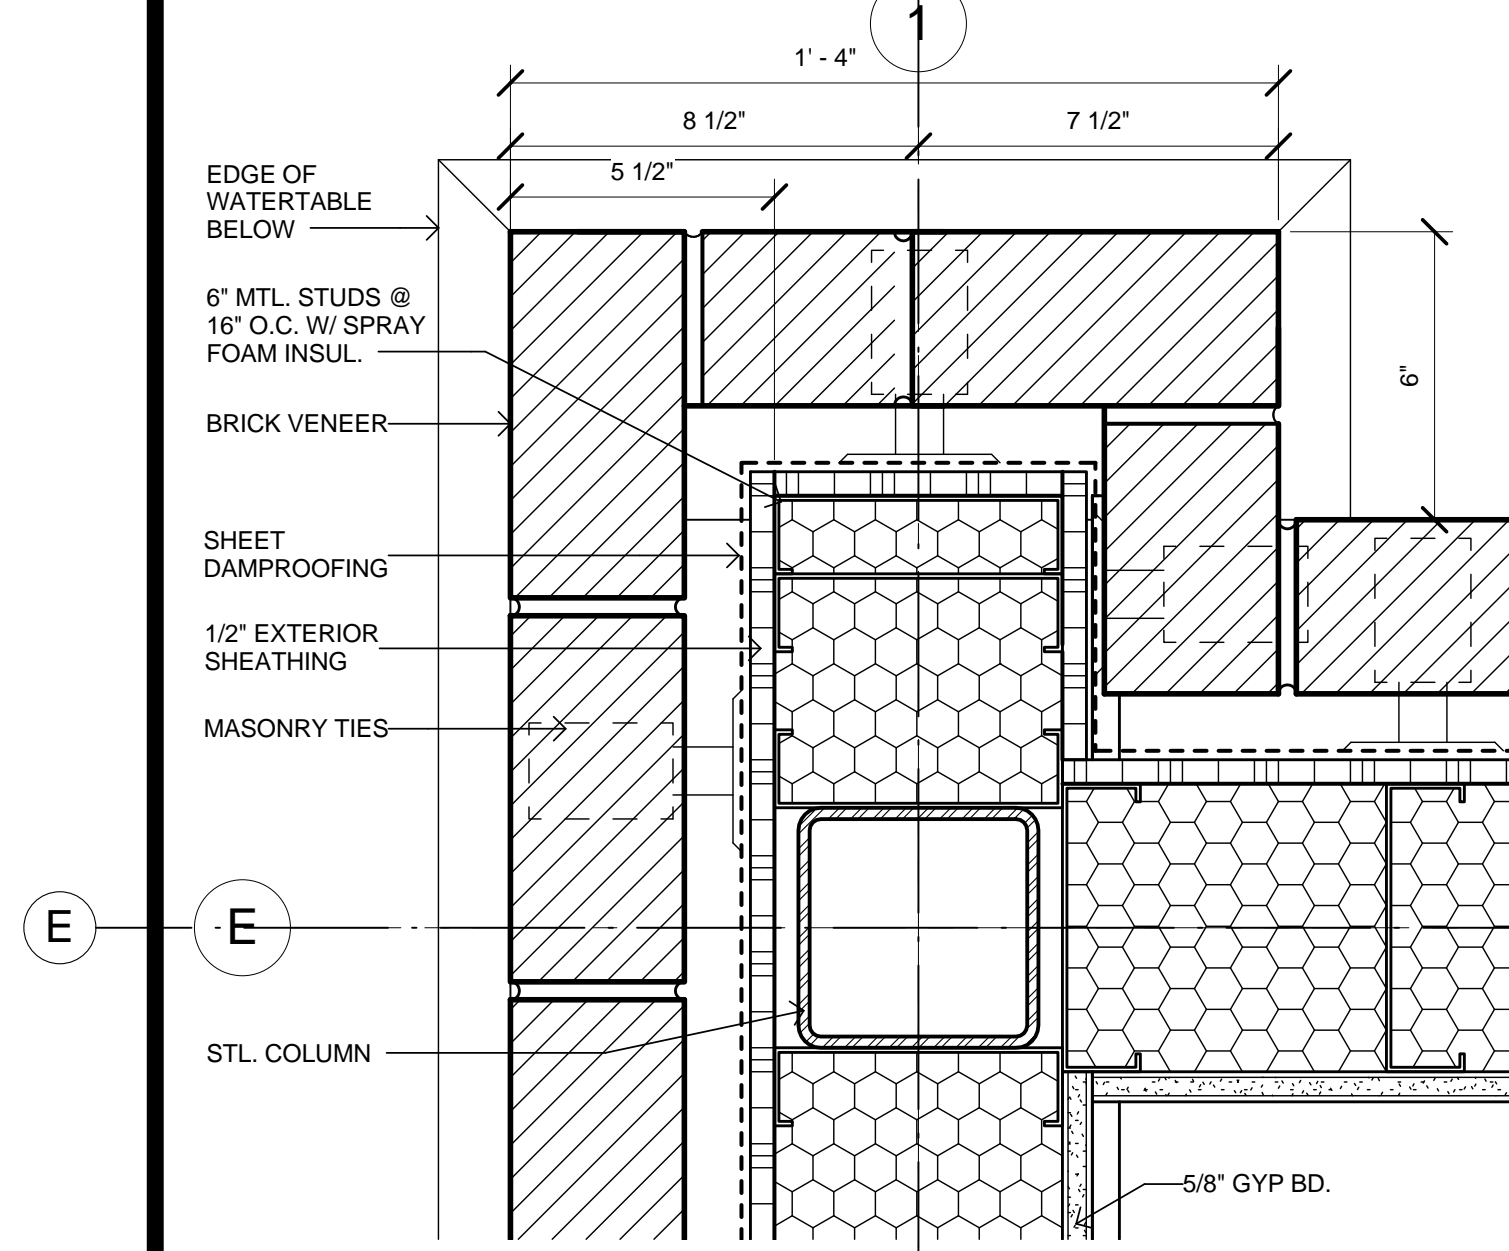


11 PLAN DETAIL
3" = 1'-0"

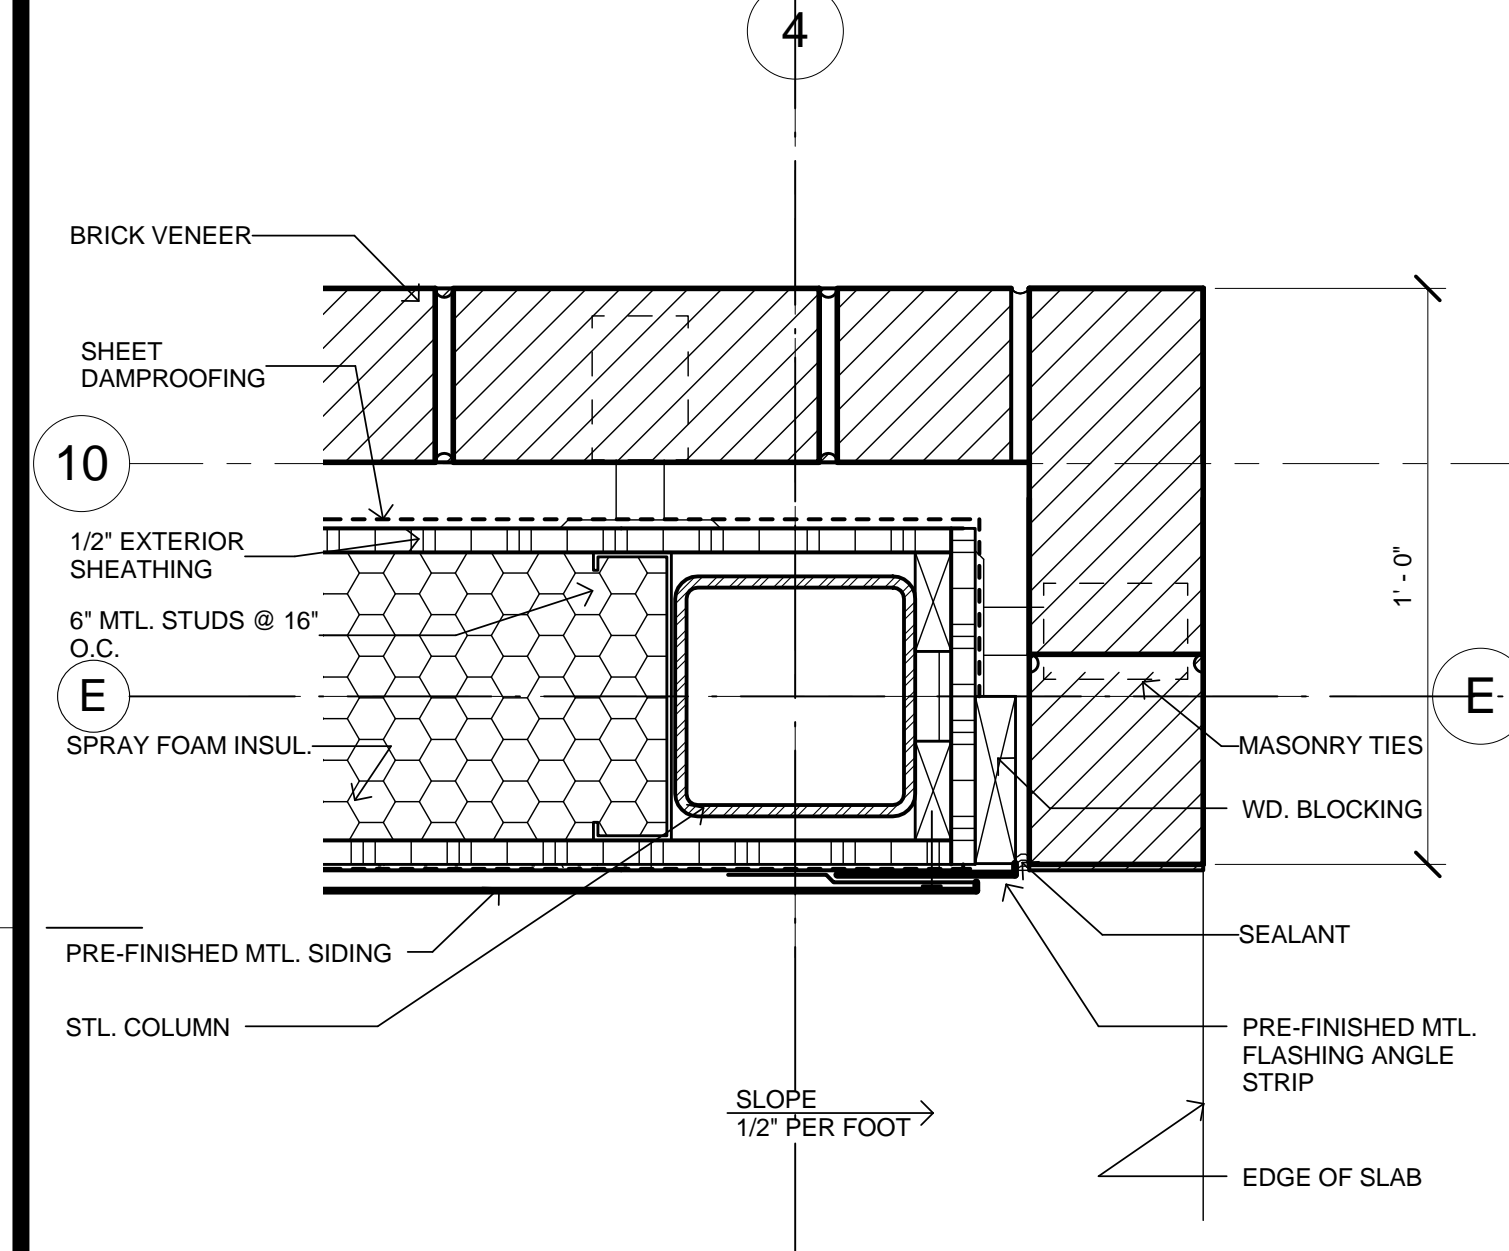


12 PLAN DETAIL
3" = 1'-0"

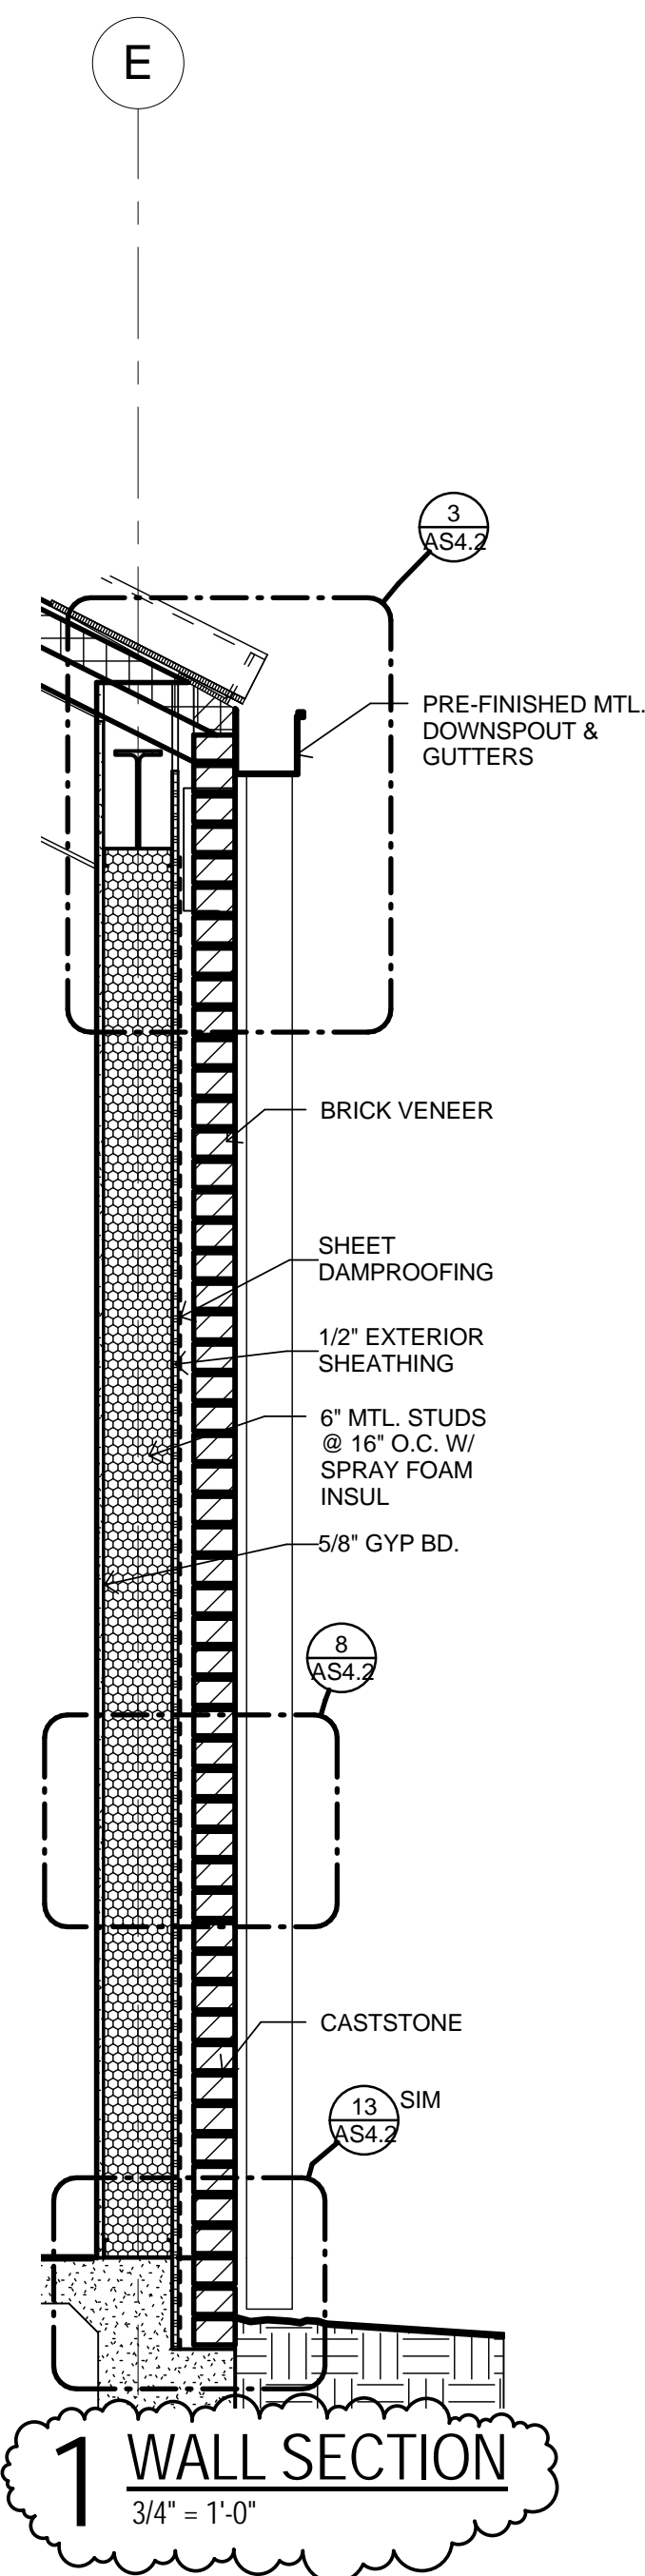


1 WALL SECTION
3/4" = 1'-0"

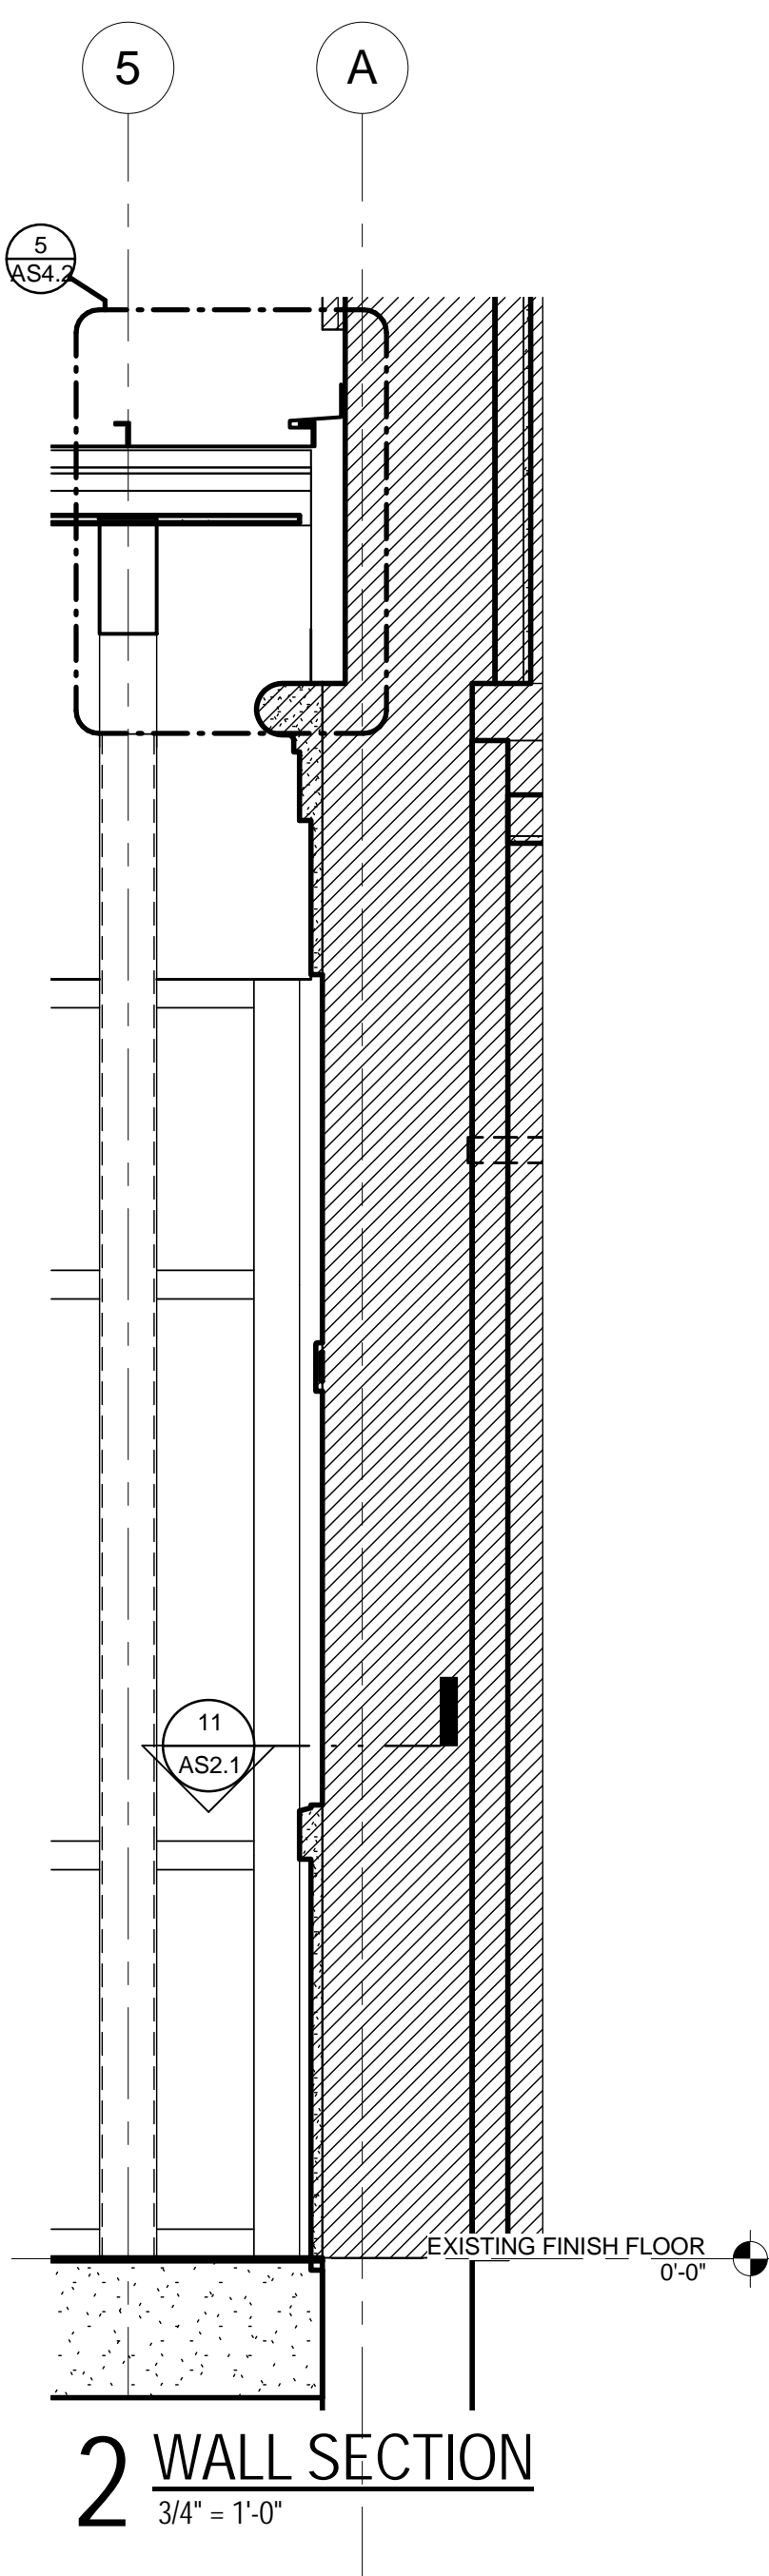


2 WALL SECTION
3/4" = 1'-0"

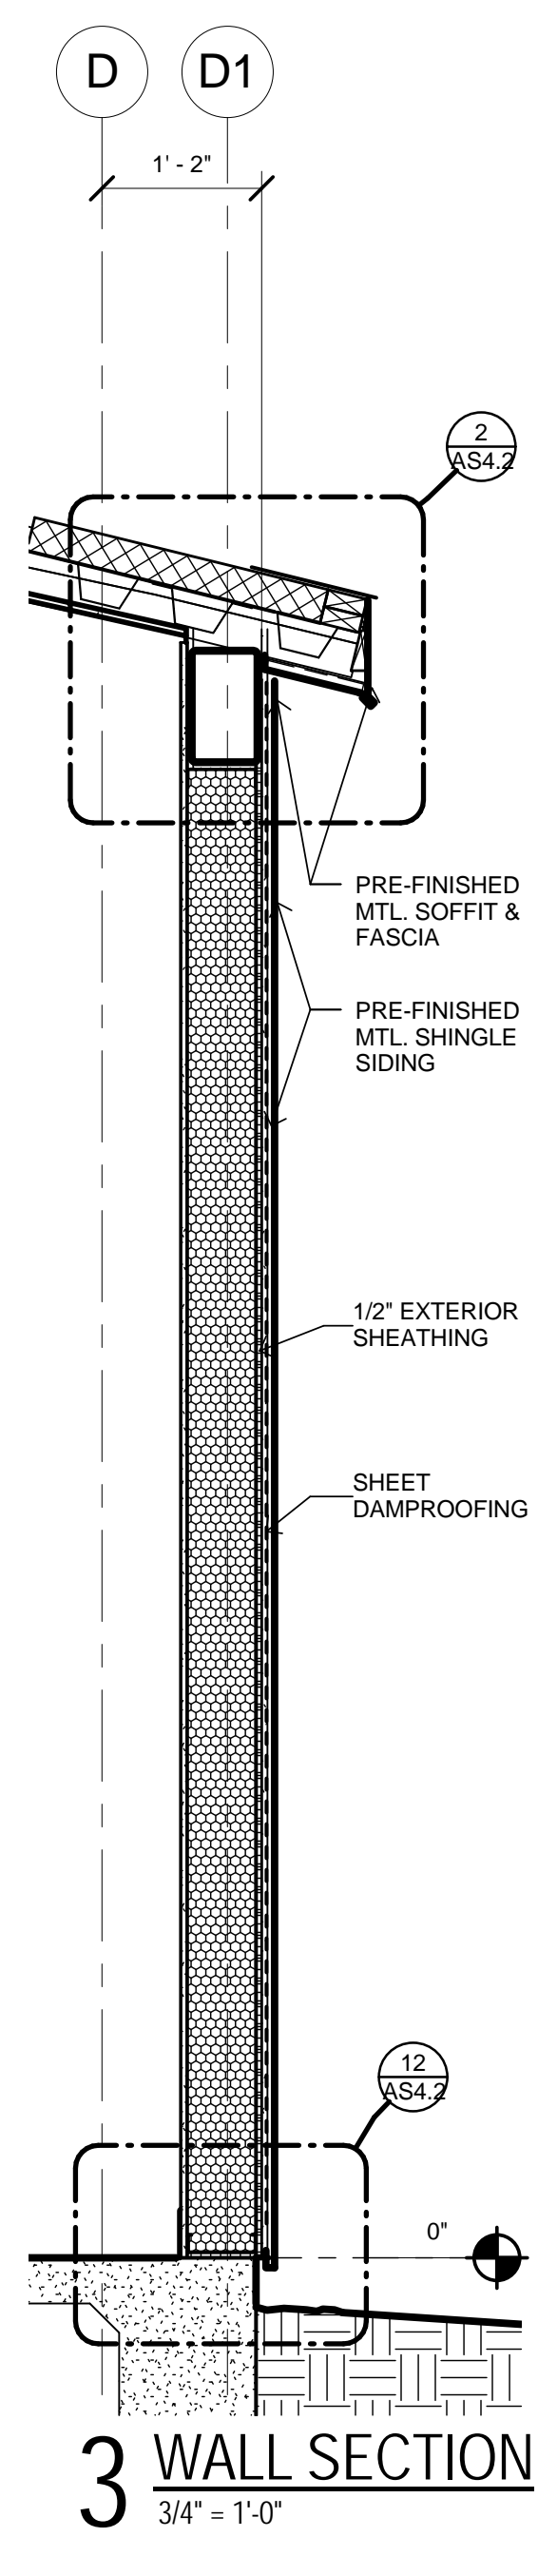


3 WALL SECTION
3/4" = 1'-0"

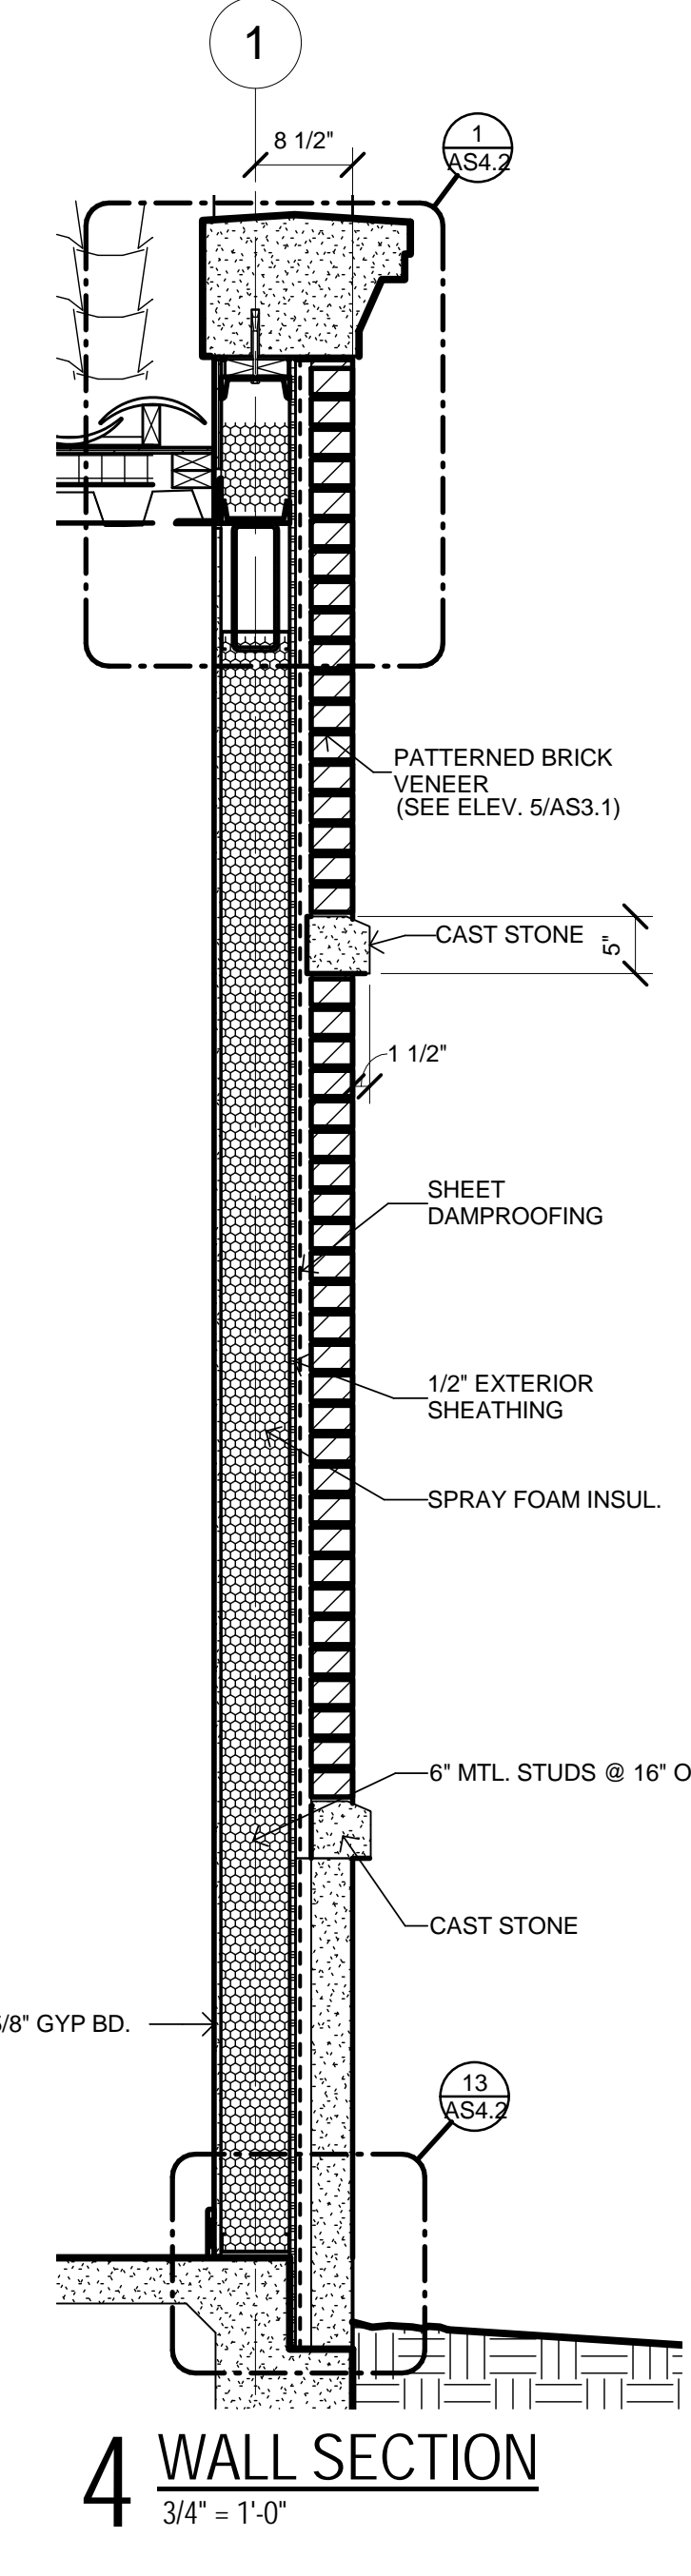

4 WALL SECTION
3/4" = 1'-0"

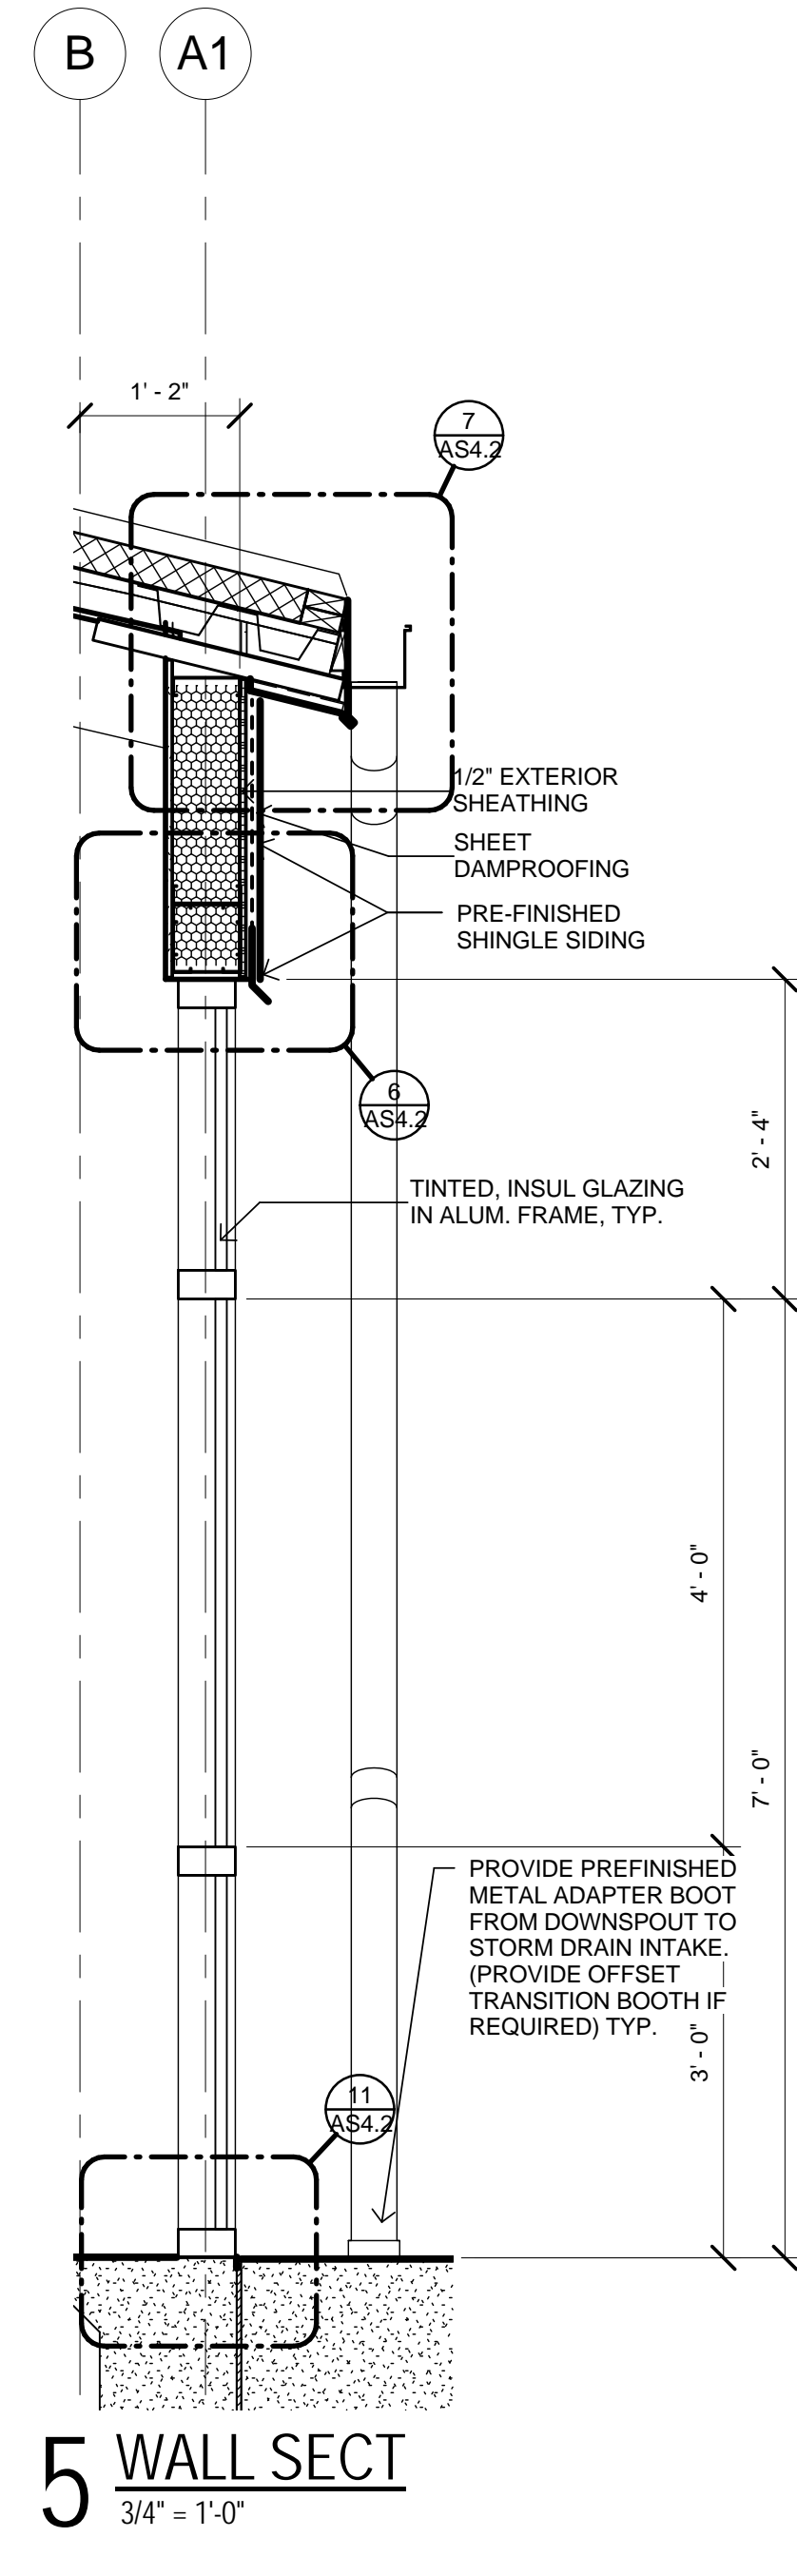


5 WALL SECT
3/4" = 1'-0"

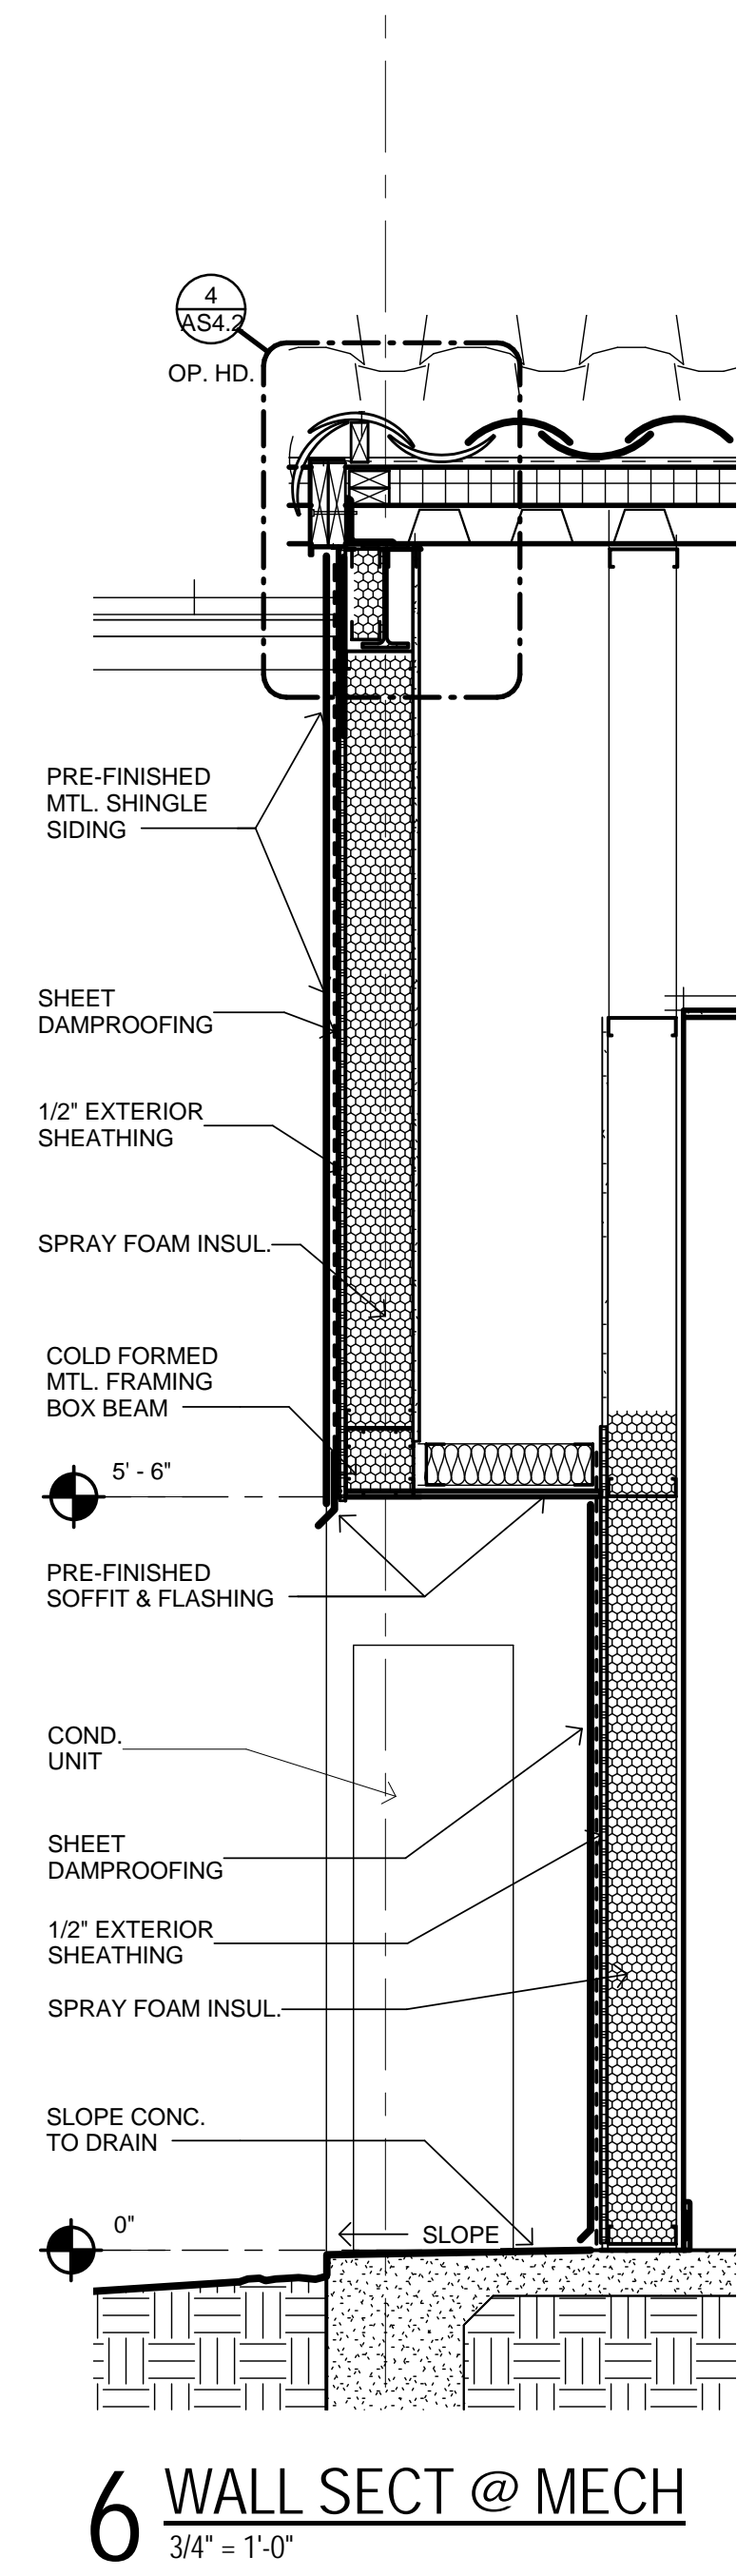

6 WALL SECT @ MECH
3/4" = 1'-0"

AMENDMENT NUMBER ONE	5-8-13
Revisions:	Date:

CONSULTANTS:

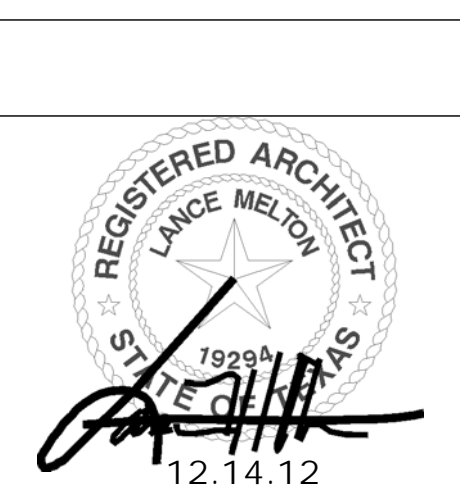

ARCHITECT/ ENGINEERS
WINGTON HOOKER JEFFRY P.C. ARCHITECTS
500 N. Central Expressway Suite 300 Piano, Texas 75074
P : 972.665.0657 F : 972.665.0656

DRAWING TITLE:
WALL SECTIONS / DETAILS
PROJECT MANAGER:

Project Title:
V.A. C.O.E. DATA STORAGE CENTER ADDITION
Location:
4800 MEMORIAL DRIVE WACO, TEXAS 76710
Date:
BID SET: 12.14.12

Project Number
674A4-12-707
Building Number
93
Drawing Number
AS4.1
Dwg. of

CENTRAL TEXAS VETERANS HEALTHCARE SYSTEM
Department of Veterans Affairs