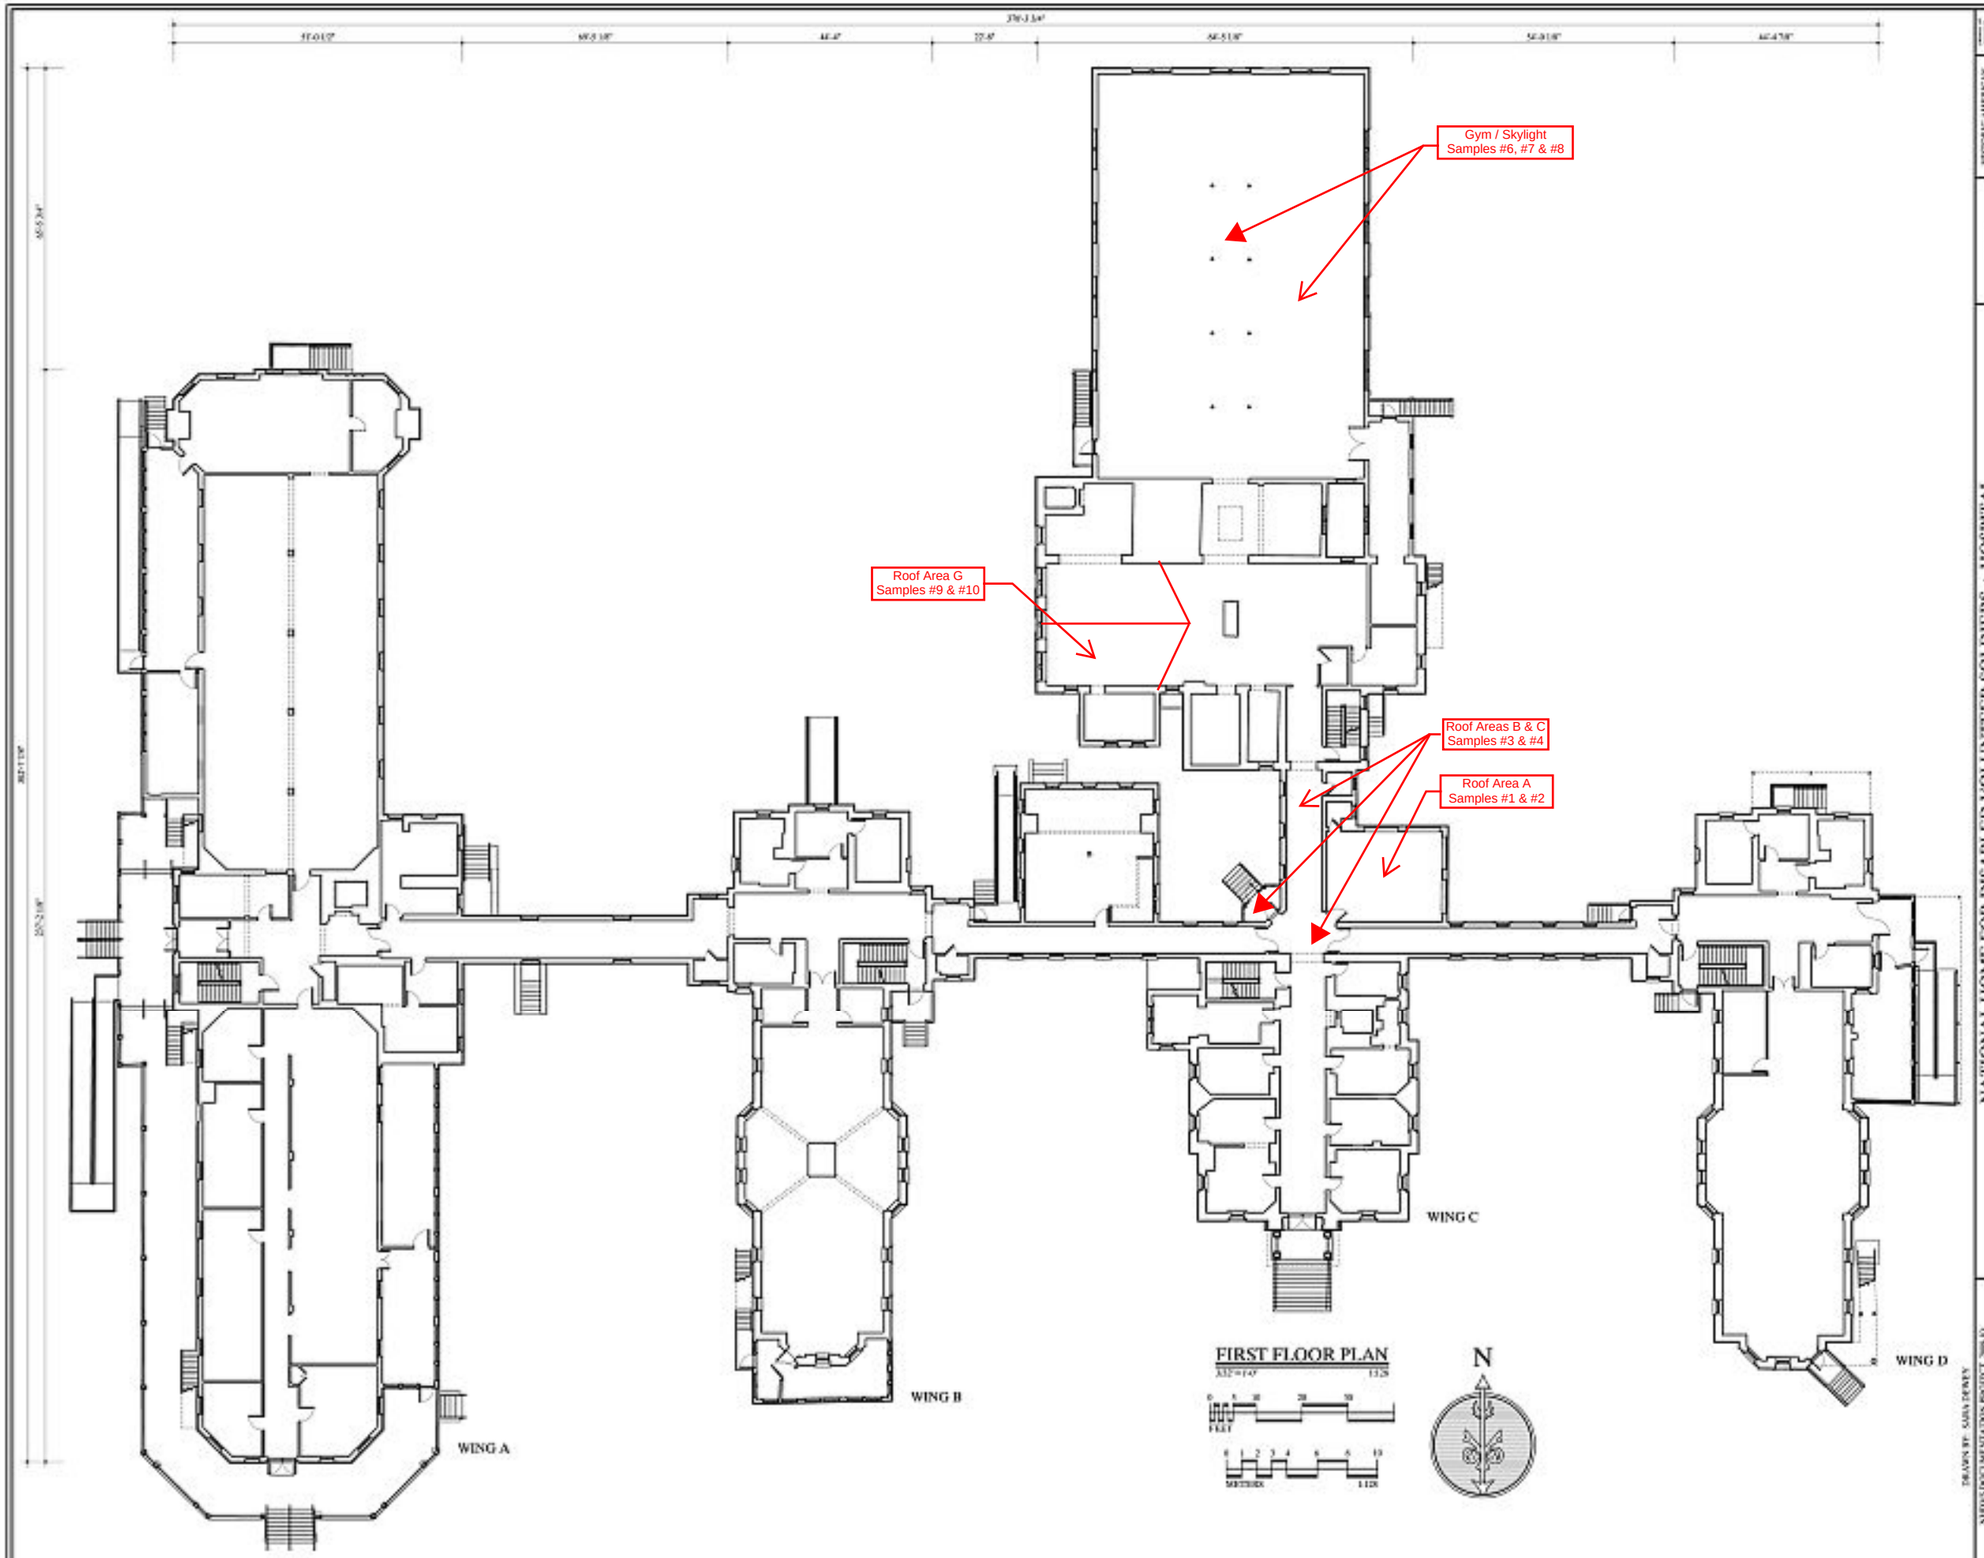
Gym / Skylight
Samples #6, #7 & #8
Roof Area G
Samples #9 & #10
Roof Areas B & C
Samples #3 & #4
Roof Area A
Samples #1 & #2
WING A
WING B
WING C
WING D
FIRST FLOOR PLAN
N
NATIONAL HOME FOR DISABLED VOLUNTEER SOLDIERS - HOSPITAL