




Replace
w/
Fire Doors.

Replace
w/
Fire Doors

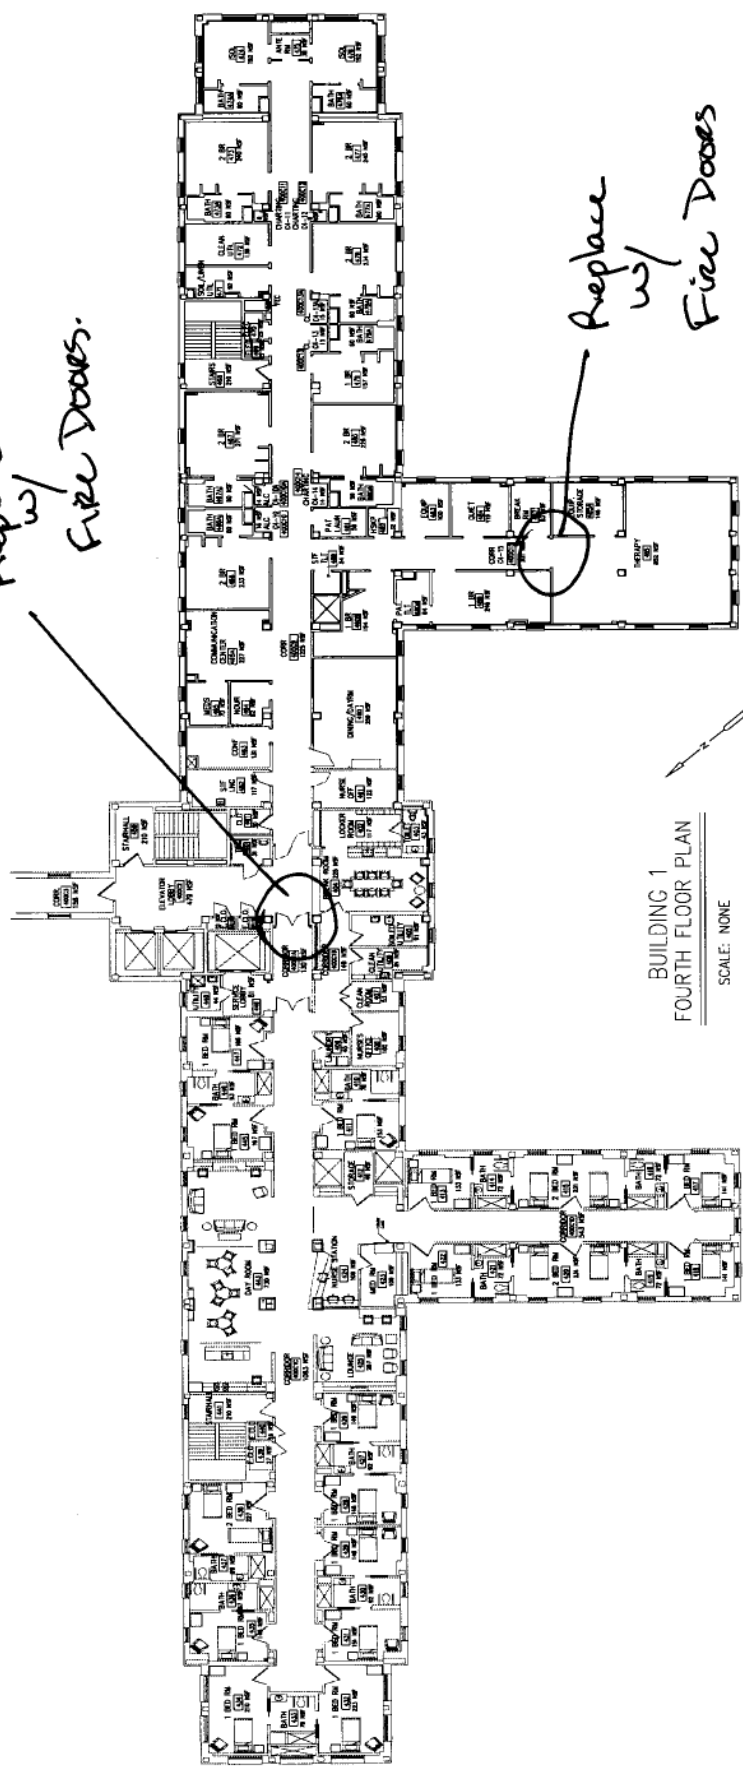

BUILDING 1
FOURTH FLOOR PLAN
SCALE: NONE

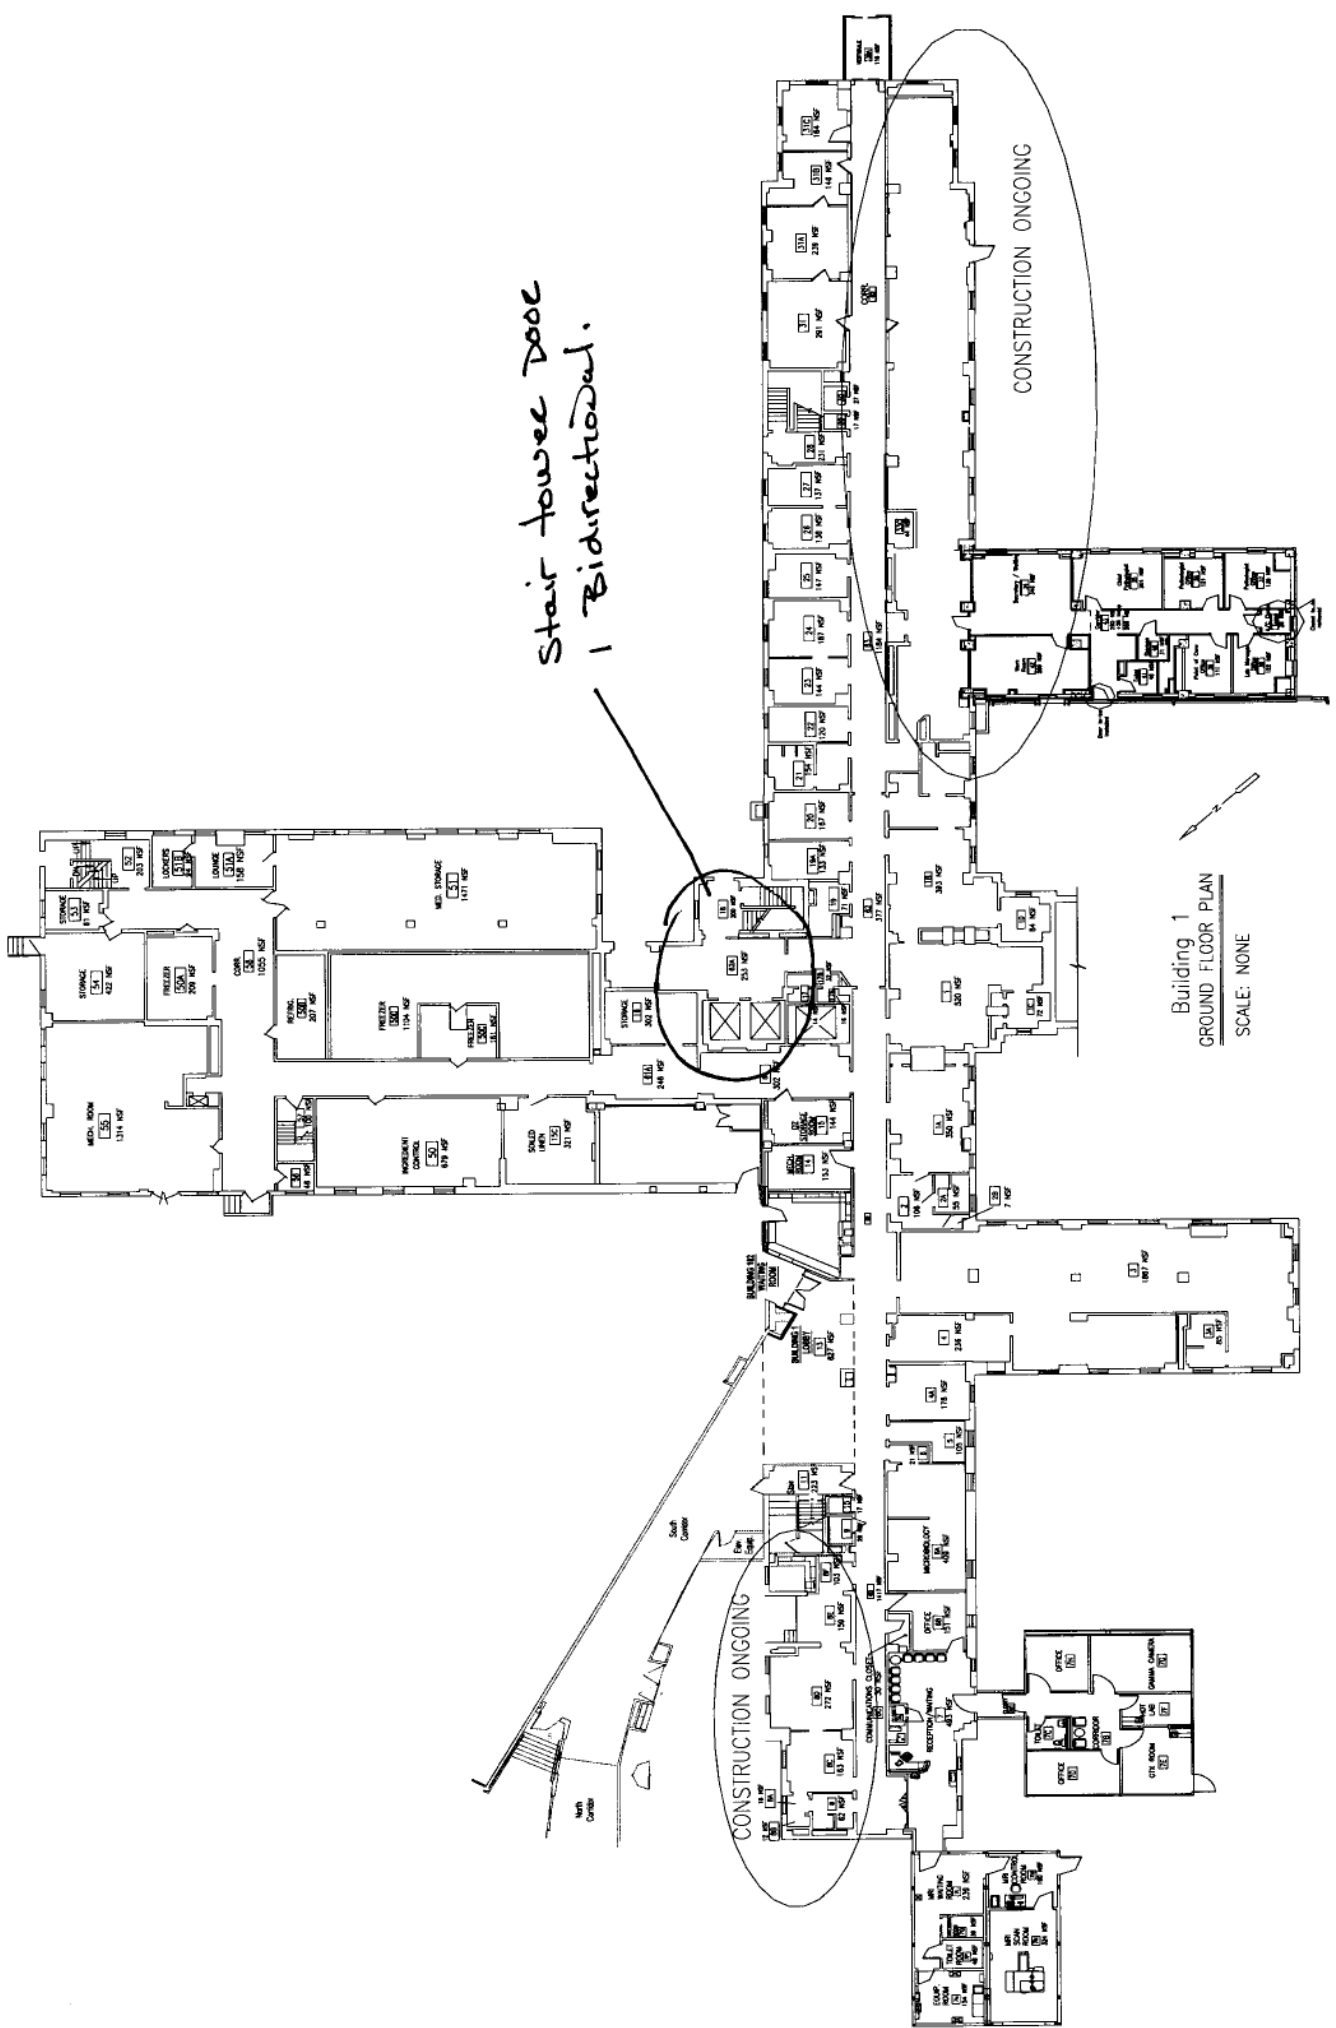

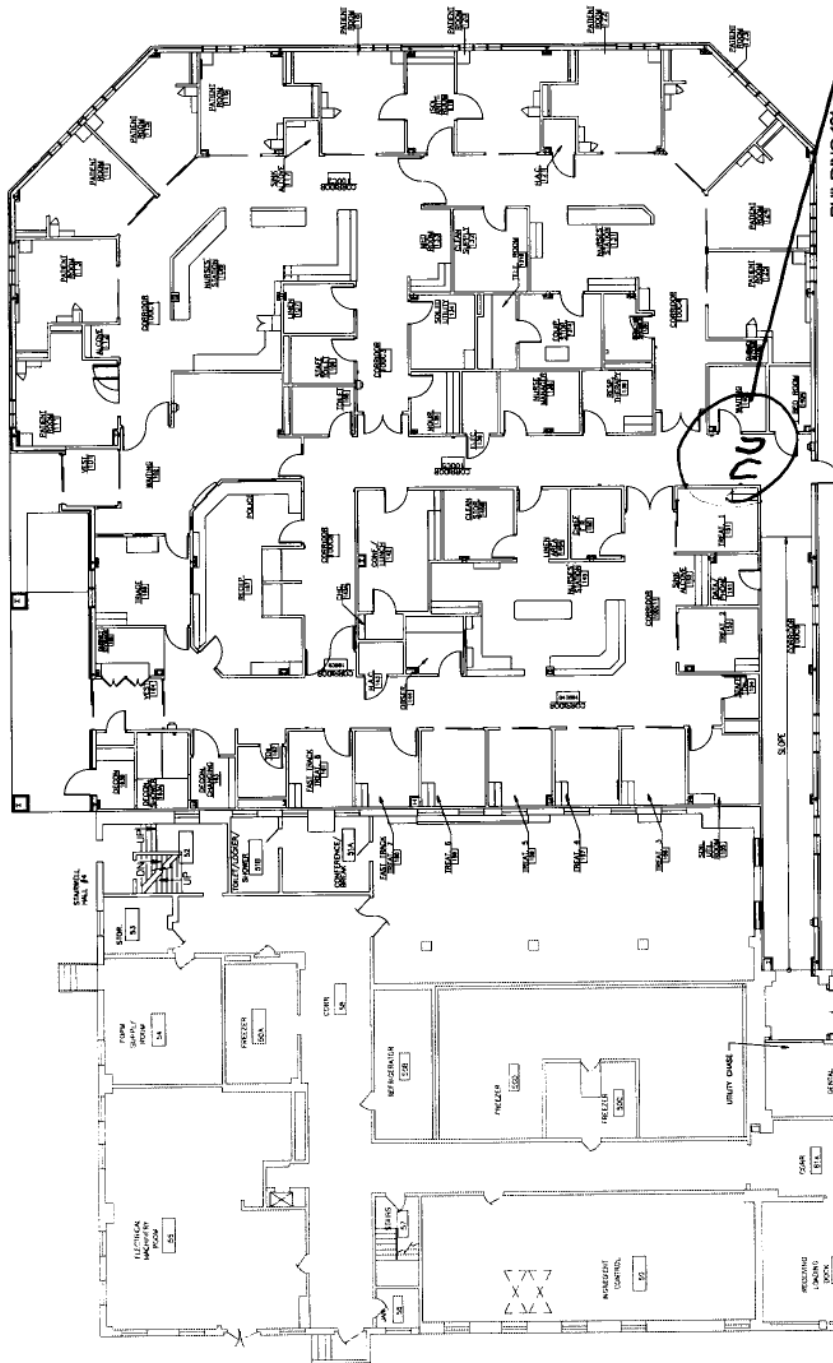

BUILDING 101
FIRST FLOOR PLAN
SCALE 1/8"=1'-0"

Bidirectional

