

1 DEMO ROOF PLAN - AREA 2D
SCALE: 1/8" = 1'-0"

2 NEW WORK ROOF PLAN - AREA 2D
SCALE: 1/8" = 1'-0"


MECHANICAL DEMO KEYED NOTES:

- 1 REMOVE ISOLATION ROOM EXHAUST FAN SEP-2-1D AND MAKING BOX. RELOCATE CURB AND FAN SUPPORT RAILS. REPAIR ROOF AS DIRECTED BY ARCHITECT.
- 2 EXISTING ROOF HOOD TO REMAIN.

MECHANICAL KEYED NOTES:


- 1 NEW LOCATION OF RELOCATED FAN. PROVIDE NEW EXHAUST RAILS. SIMILAR TO EXISTING RAILS. INSULATED CURB AT THE DUCT PENETRATION.
- 2 PROVIDE 42" HIGH EXHAUST CURB. PROVIDE 18" HIGH ROOF EXHAUST FANS. RE-ARCHITECTURAL DETAILS.
- 3 ROOF MOUNT EXHAUST FAN SEP-2-3D ON 18" HIGH ROOF. PROVIDE 18" HIGH ROOF EXHAUST FANS. RE-ARCHITECTURAL DETAILS FOR CURB INSTALLATION.
- 4 INSERT A 14 GA. STAINLESS STEEL SPOOL PIECE BETWEEN FAN AND NOZZLE. PROVIDE LENGTH TO EXTEND NOZZLE OUTLET TO 10' ABOVE ROOF. FIELD VERIFY SIZE.

- GENERAL NOTES (THIS SHEET ONLY):
1. THE EXISTING MECHANICAL LAYOUTS INDICATED ON THESE DOCUMENTS ARE BASED ON FIELD SURVEY DATA AND ARE NOT TO BE CONSIDERED AS A GUARANTEE OF ACCURACY. IT SHALL BE THE CONTRACTOR'S RESPONSIBILITY TO VERIFY ALL CONDITIONS AND MAKE SURE THE INFORMATION IS CORRECT. ANY CONDITIONS DIFFERENT TO THOSE INDICATED SHALL BE INCORPORATED INTO THE CONSTRUCTION DOCUMENTS. NOTE ANY UNCOVERED SYSTEMS MUST BE CAREFULLY IDENTIFIED PRIOR TO MODIFICATIONS.
 2. CONTRACTOR SHALL COORDINATE HIS WORK WITH THE OTHER TRADES AND INCLUDE ANY MODIFICATIONS NEEDED TO ACCOMMODATE THEIR WORK.

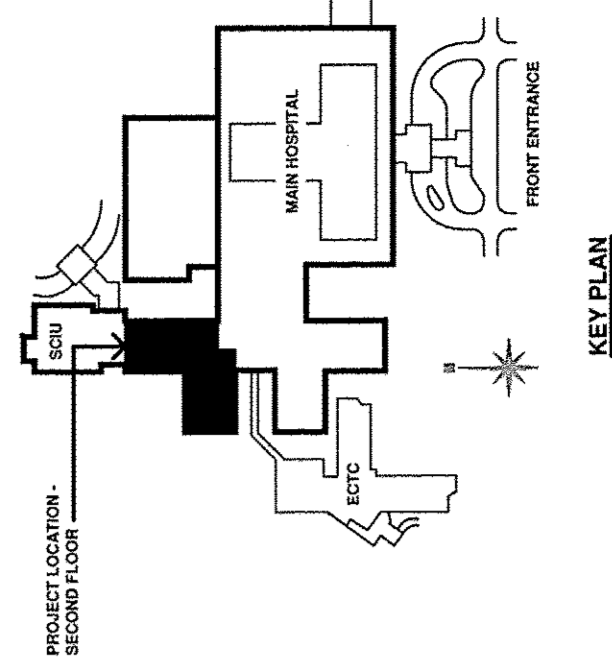

**CLEARY
ZIMMERMANN
ENGINEERS**

1344 S. RICHARDS ROAD
SAN ANTONIO, TEXAS 78204
TX, REG. # F-9357
12093, cz
T 210.447.6100 / F 210.447.6101
ClearyZimmermann.com

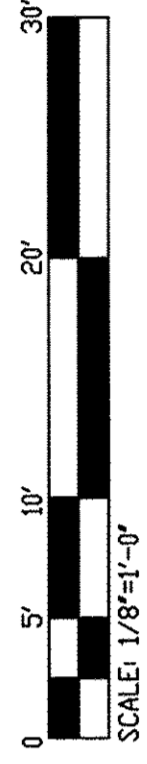

Revisions		Date
AMENDMENT #1		5/10/13

NOTE: THE RESIDENT ENGINEER MUST BE NOTIFIED 24 HOURS IN ADVANCE OF ANY COMPROMISE IN THE FIRE SUPPRESSION OR SMOKE DETECTION SYSTEMS. A COPY OF THE INTERIM LIFE SAFETY MEASURES MUST BE OBTAINED AND FOLLOWED DURING CONSTRUCTION.



5605 N. New Braunfels, Suite 201 • San Antonio, Texas 78217 • (210) 842-8400 • Fax (210) 842-8484 • Fax

McCALL & ASSOCIATES-AIA-ARCHITECTS
ARCHITECTURE • PLANNING • DESIGN • VISUALIZATION

Approved: Assistant Director	Approved: Chief of Staff	Approved: Chief, Engineering
Approved: Service Chief	Approved: Service Chief	Approved: Service Chief
Approved: Chief, Medical	Approved: Chief, Lab	Approved: Chief, Infection Control
Approved: Chief, IT	Approved: Chief, M&D	Approved: Chief, Police
Approved: Chief, Safety	Approved: Chief	Approved: Chief

Drawing Title		Project Title		Date
MECHANICAL ROOF PLAN DEMO & NEW WORK		SICU MODIFICATIONS SECOND FLOOR		07-25-12
		Building Number		Project No.
		1		671-232B
		Checked		Drawing No.
		C.S.		H1-3
		Drafter		Dwg 9 of 14
		Location		
		San Antonio, Texas		

