BOUNDARY SHEET

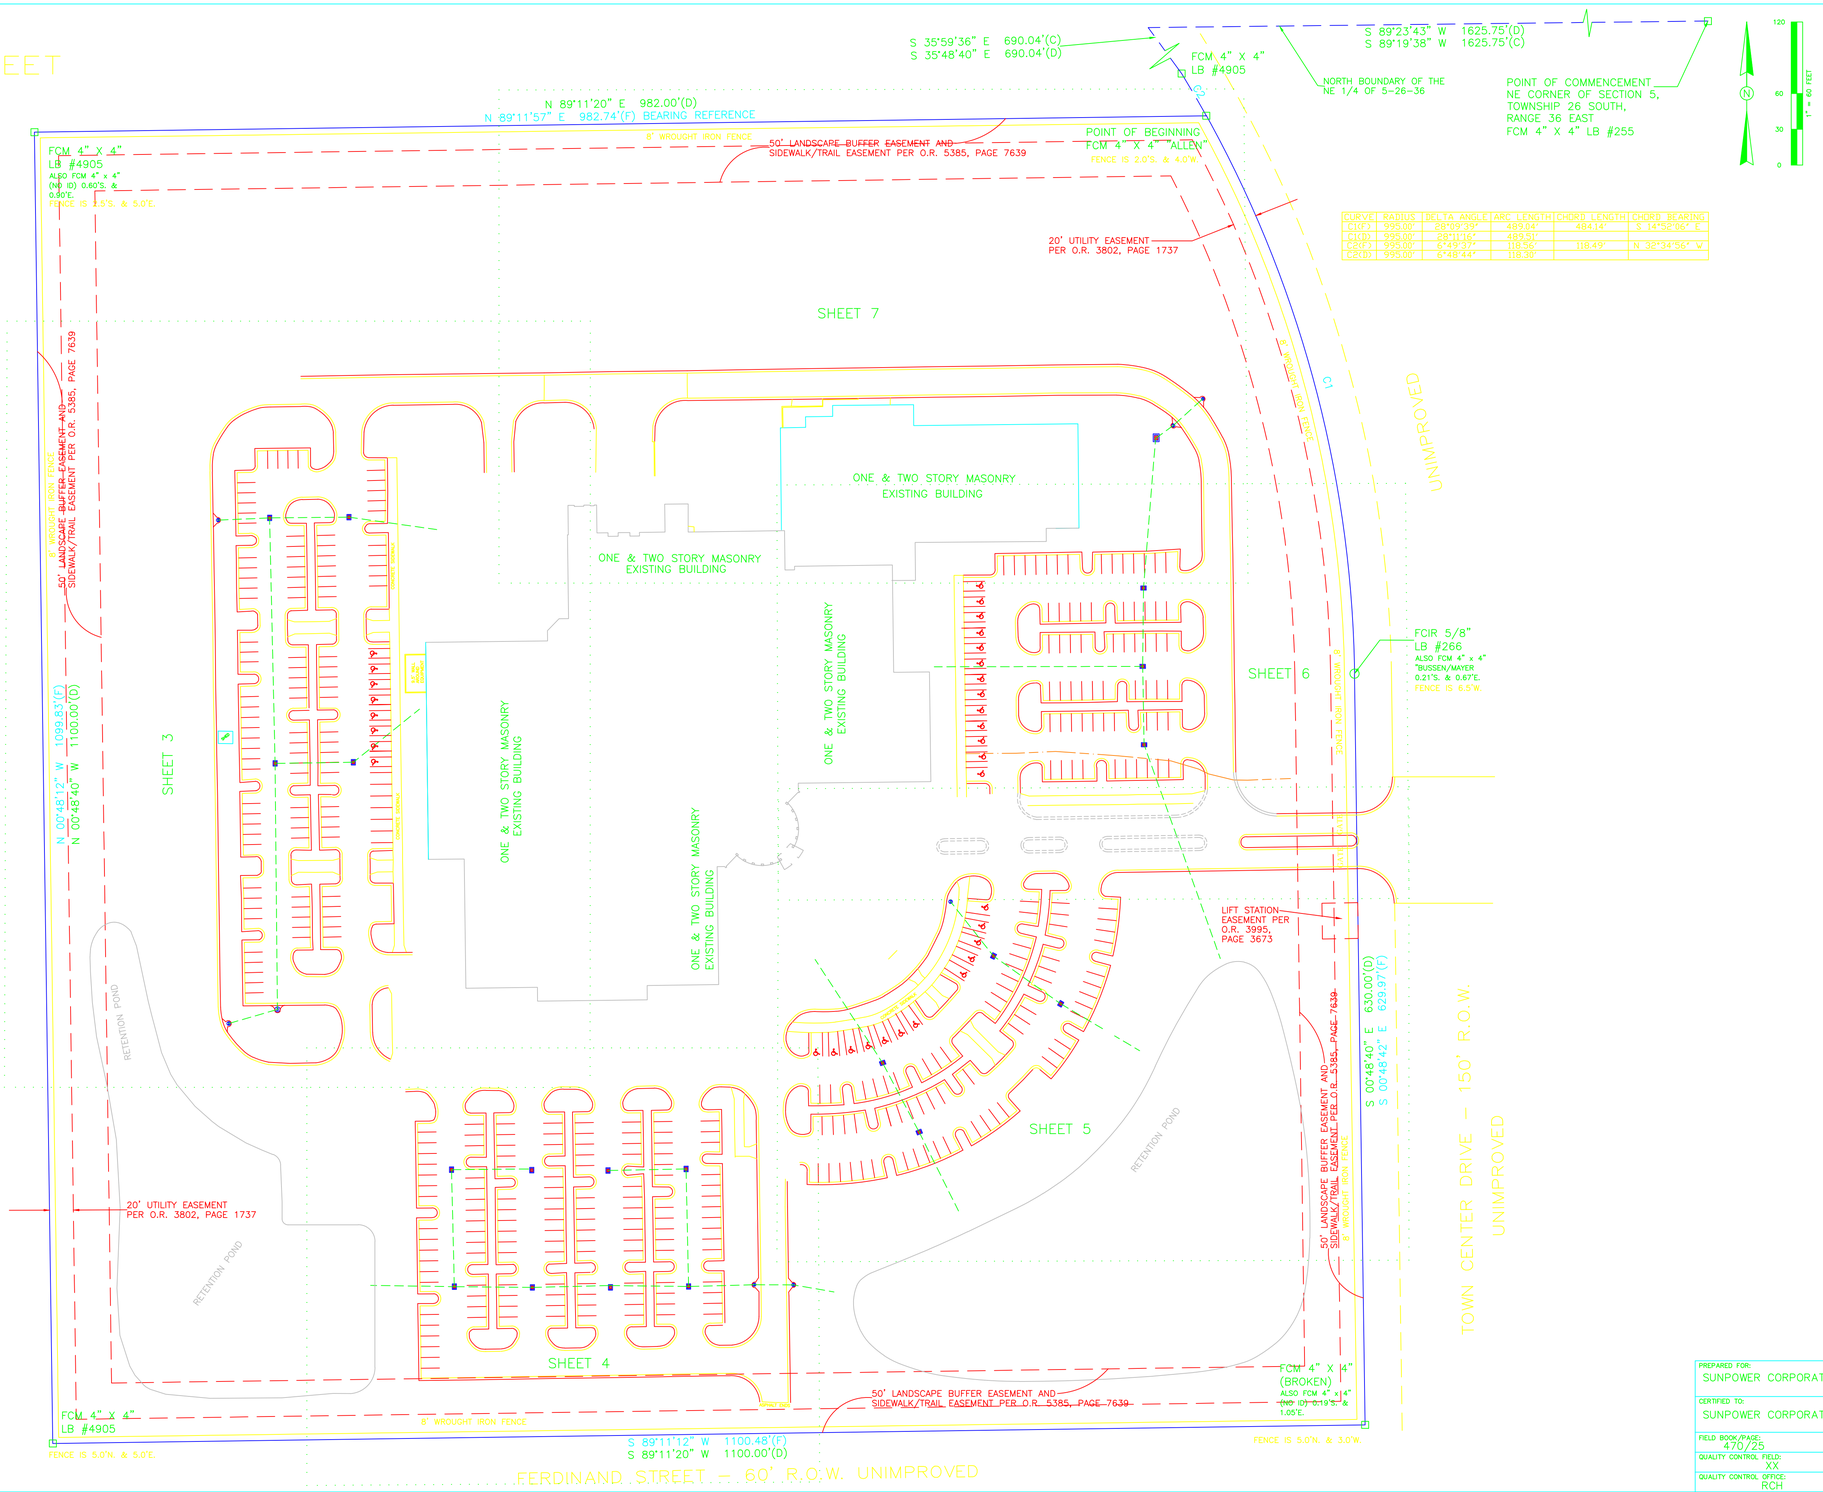

CURVE	RADIUS	DELTA ANGLE	ARC LENGTH	CHORD LENGTH	CHORD BEARING
C1(F)	995.00'	28°09'39"	489.04'	484.14'	S 14°52'06" E
C1(D)	995.00'	28°11'16"	489.51'		
C2(F)	995.00'	6°49'37"	118.56'	118.49'	N 32°34'56" W
C2(D)	995.00'	6°48'44"	118.30'		

ALL VISIBLE FIXED IMPROVEMENTS LYING WITHIN THE BOUNDARY WERE NOT LOCATED THIS DATE. ONLY IMPROVEMENTS IN THE LIMITS OF TOPOGRAPHIC SURVEY AS REQUESTED BY CLIENT ARE SHOWN.

C:\Users\VHAORLDumonM\appdata\local\temp\AcPublish_6676\02788000 1BNDYTOPO.DWG (SHEET 2 BOUNDARY) VHAORLDumonM May 15, 2013 - 8:53am

HAMILTON
ENGINEERING & SURVEYING, INC.
31 NORTH NEWPORT AVENUE, SUITE 100
TAMPA, FL 33606
LB #7013
TEL (813) 250-3535
FAX (813) 250-3636

SHEET TITLE:
MAP OF BOUNDARY & PARTIAL TOPOGRAPHIC SURVEY

VIERA VA CLINIC
2900 VETERAN'S WAY, VIERA, FLORIDA
BREVARD COUNTY

PREPARED FOR: SUNPOWER CORPORATION	DRAWN BY: RHF / PARTY CHIEF: VINCE
CERTIFIED TO: SUNPOWER CORPORATION	JOB #: 02788.0001
FIELD BOOK/PAGE: 470/25	SEC TWP RNG: 5-26-36
QUALITY CONTROL FIELD: XX	SURVEY DATE: 01/22/2011
QUALITY CONTROL OFFICE: RCH	NOT VALID WITHOUT ALL SHEETS 2 OF 7