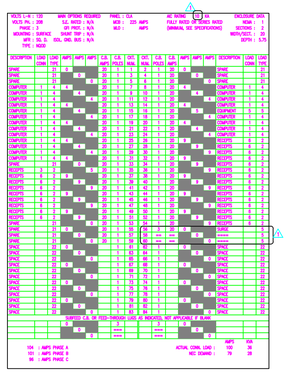

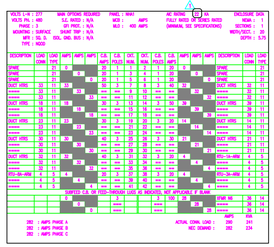

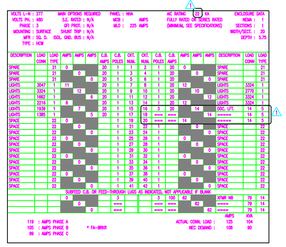

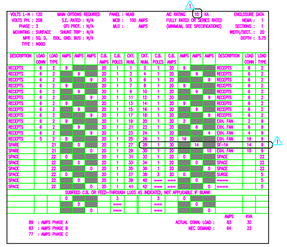

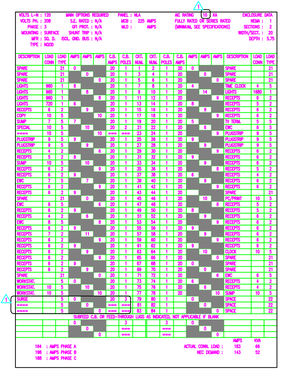

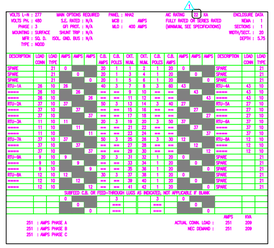


**Baker**

Baker/Mellon Stuart Const. , Inc.
111 North Orange Avenue
Suite 625
Orlando, Florida 32801

KBJ ARCHITECTS

KBJ Architects, Inc.
*AAC00001*
510 North Julia Street
Jacksonville, Florida 32202


| No. | Date | Revisions |
|---|---|---|
| 1 | 08/27/98 | PLAN REVISIONS |

Notes:

Seal

Drawing Title
ZONE A
PANEL SCHEDULES

Approved: Area Project Manager

Project Title
VA OUTPATIENT CLINIC
BREVARD COUNTY

Location
BREVARD COUNTY, FLORIDA

| Drawn | Checked | Date |
|---|---|---|
| MJR | CW/HP | 7-30-98 |

VA Project Number
623-097

E&A Project Number
98006

Building Number

Drawing Number
E7.2

FINAL SUBMITTAL

Office of Facilities Management

Department of Veterans Affairs


KLG/PAKE
900 SOUTH NORTH PLANE DRIVE
SUITE 201
LAKELAND, FL 33803
Phone (407) 894-4922
Fax (407) 894-4923
E-mail klgfla@msn.com


FL98001