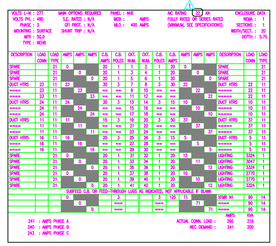

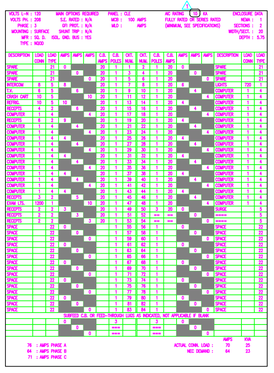

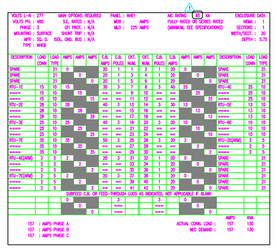

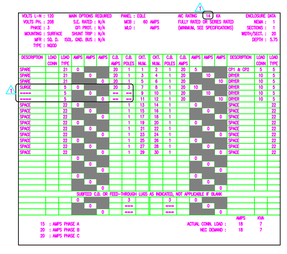

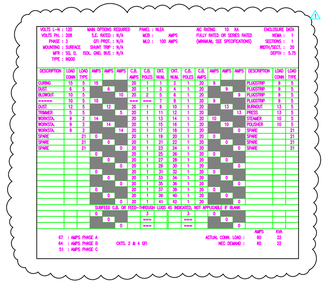

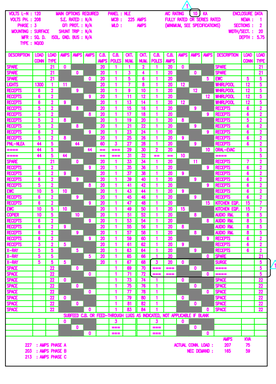

Baker

Baker/Mellon Stuart Const. , Inc.
111 North Orange Avenue
Suite 625
Orlando, Florida 32801

KBJ ARCHITECTS

KBJ Architects, Inc.
AAC000011
510 North Julia Street
Jacksonville, Florida 32202

Date	Revisions
06/17/98	Δ PLAN REVISIONS

Seal

Notes:

Drawing Title
ZONE 'E'
PANEL SCHEDULES

Approved: Area Project Manager

Project Title
VA OUTPATIENT CLINIC
BREVARD COUNTY

Location
BREVARD COUNTY, FLORIDA

Date: 7-30-98

Checked: DW/MP

Drawn: MJR

VA Project Number: 673-087

A&E Project Number: 93006

Building Number:

Drawing Number: E7.6

FINAL SUBMITTAL

Office of Facilities Management

Department of Veterans Affairs

KLG/PAKS
950 SOUTH GEORGE RANE BOOTH
DRIVE SW
CLEVELAND, TN 37311
Phone (423) 559-9002
Fax (423) 559-9009
E-mail klgtn@aol.com

FL98001