



GENERAL NOTES:

1) REFER TO SHEET E0.1 FOR GENERAL NOTES.

2) REFER TO SPECIFICATIONS.

3) SCA = AVAILABLE SHORT CIRCUIT AMPERES (RMS SYMETRICAL) ⚠

KEY NOTES:

1. PROVIDE PRIMARY SURGE PROTECTION, CURRENT TECHNOLOGY #MP-PLUS 277/480-3GY-DF.
2. PROVIDE SECONDARY SURGE PROTECTION, CURRENT TECHNOLOGY #SF50
3. PROVIDE GENERATOR START CIRCUITS PER GENERATOR MANUFACTURER'S RECOMMENDATION.
4. #3/0 CU. GROUND ELECTRODE TO BUILDING STEEL PER NEC 250.
5. #3/0 CU. GROUND ELECTRODE TO METAL COLD WATER PIPING PER NEC 250.
6. #3/0 CU. GROUND ELECTRODE TO DRIVEN GROUND RODS PER NEC 250.
7. CURRENT TECHNOLOGY SF150-277/480-2GY-DF.
8. PROVIDE NEMA- WIREWAY, SIZE AS REQUIRED. PROVIDE FUSED DISCONNECT (50A & 100A).
9. 4000 AMP BREAKER WITH 3800AMP RATING PLUG.
10. PROVIDE ENGRAVED SIGN "SERVICE #1".
11. PROVIDE ENGRAVED SIGN "SERVICE #2".

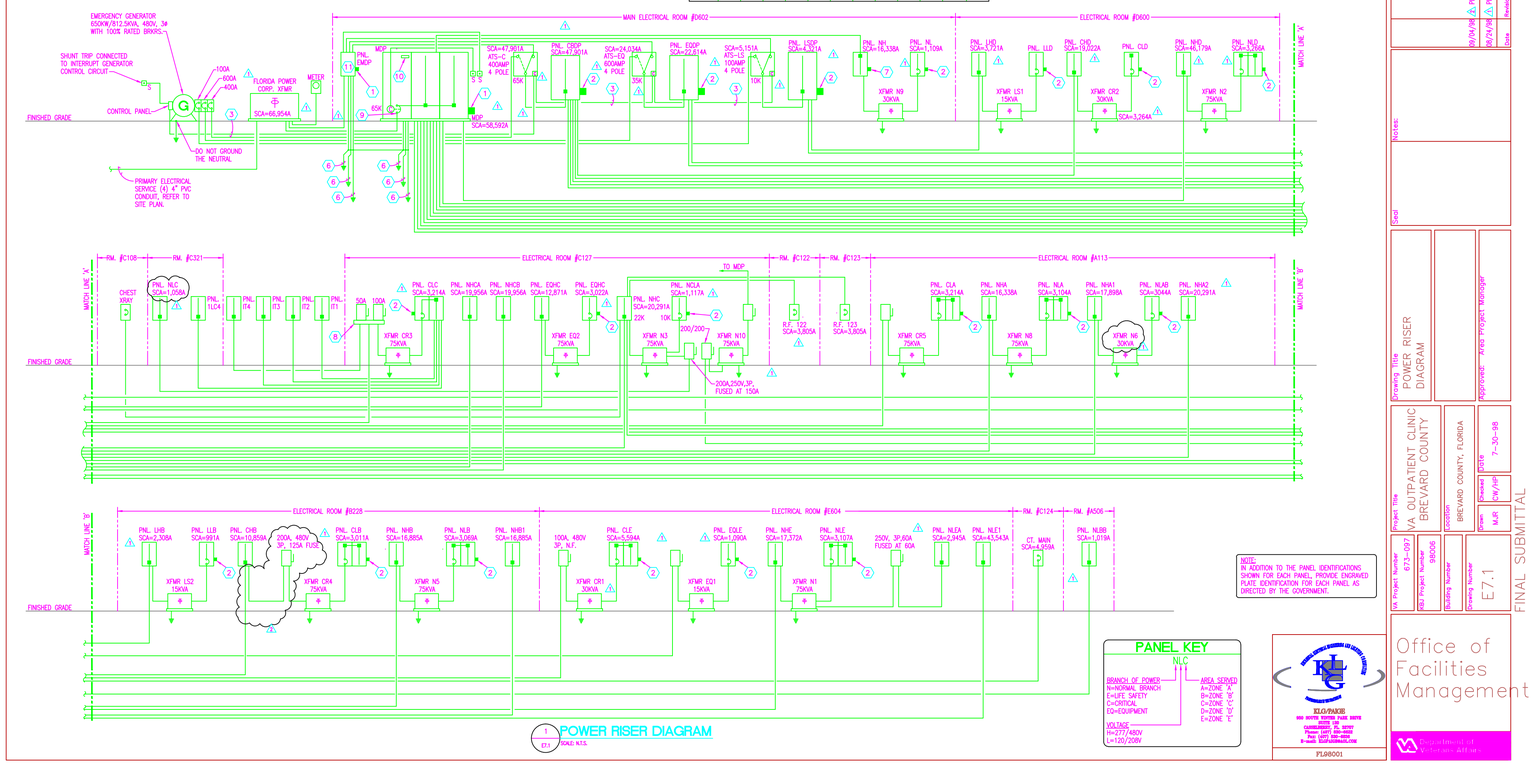

NOTE:
IN ADDITION TO THE PANEL IDENTIFICATIONS SHOWN FOR EACH PANEL, PROVIDE ENGRAVED PLATE IDENTIFICATION FOR EACH PANEL AS DIRECTED BY THE GOVERNMENT.

PANEL KEY

NLC

BRANCH OF POWER
N=NORMAL BRANCH
E=LIFE SAFETY
C=CRITICAL
ED=EQUIPMENT

VOLTAGE
H=277/480V
L=120/208V

AREA SERVED
A=ZONE 'A'
B=ZONE 'B'
C=ZONE 'C'
D=ZONE 'D'
E=ZONE 'E'

KLG/PAGE
FL#0001

Baker
Baker/Mellon Stuart Const. , Inc.
111 North Orange Avenue
Suite 625
Orlando, Florida 32801

KBJ ARCHITECTS
KBJ Architects, Inc.
AAC00001
510 North Julia Street
Jacksonville, Florida 32202

No.	Date	Revisions
2	09/04/98	PLAN REVISIONS
1	08/24/98	PLAN REVISIONS

Seal

Notes:

Drawing Title: POWER RISER DIAGRAM

Approved: Area Project Manager

Project Title: VA OUTPATIENT CLINIC
Location: BREVARD COUNTY, FLORIDA

Date	7-30-98
Reviewed	DW/MP
Drawn	MJR

VA Project Number: 673-007
A&E Project Number: 96006
Building Number:
Drawing Number: E7.1

FINAL SUBMITTAL

Office of Facilities Management

Department of Veterans Affairs