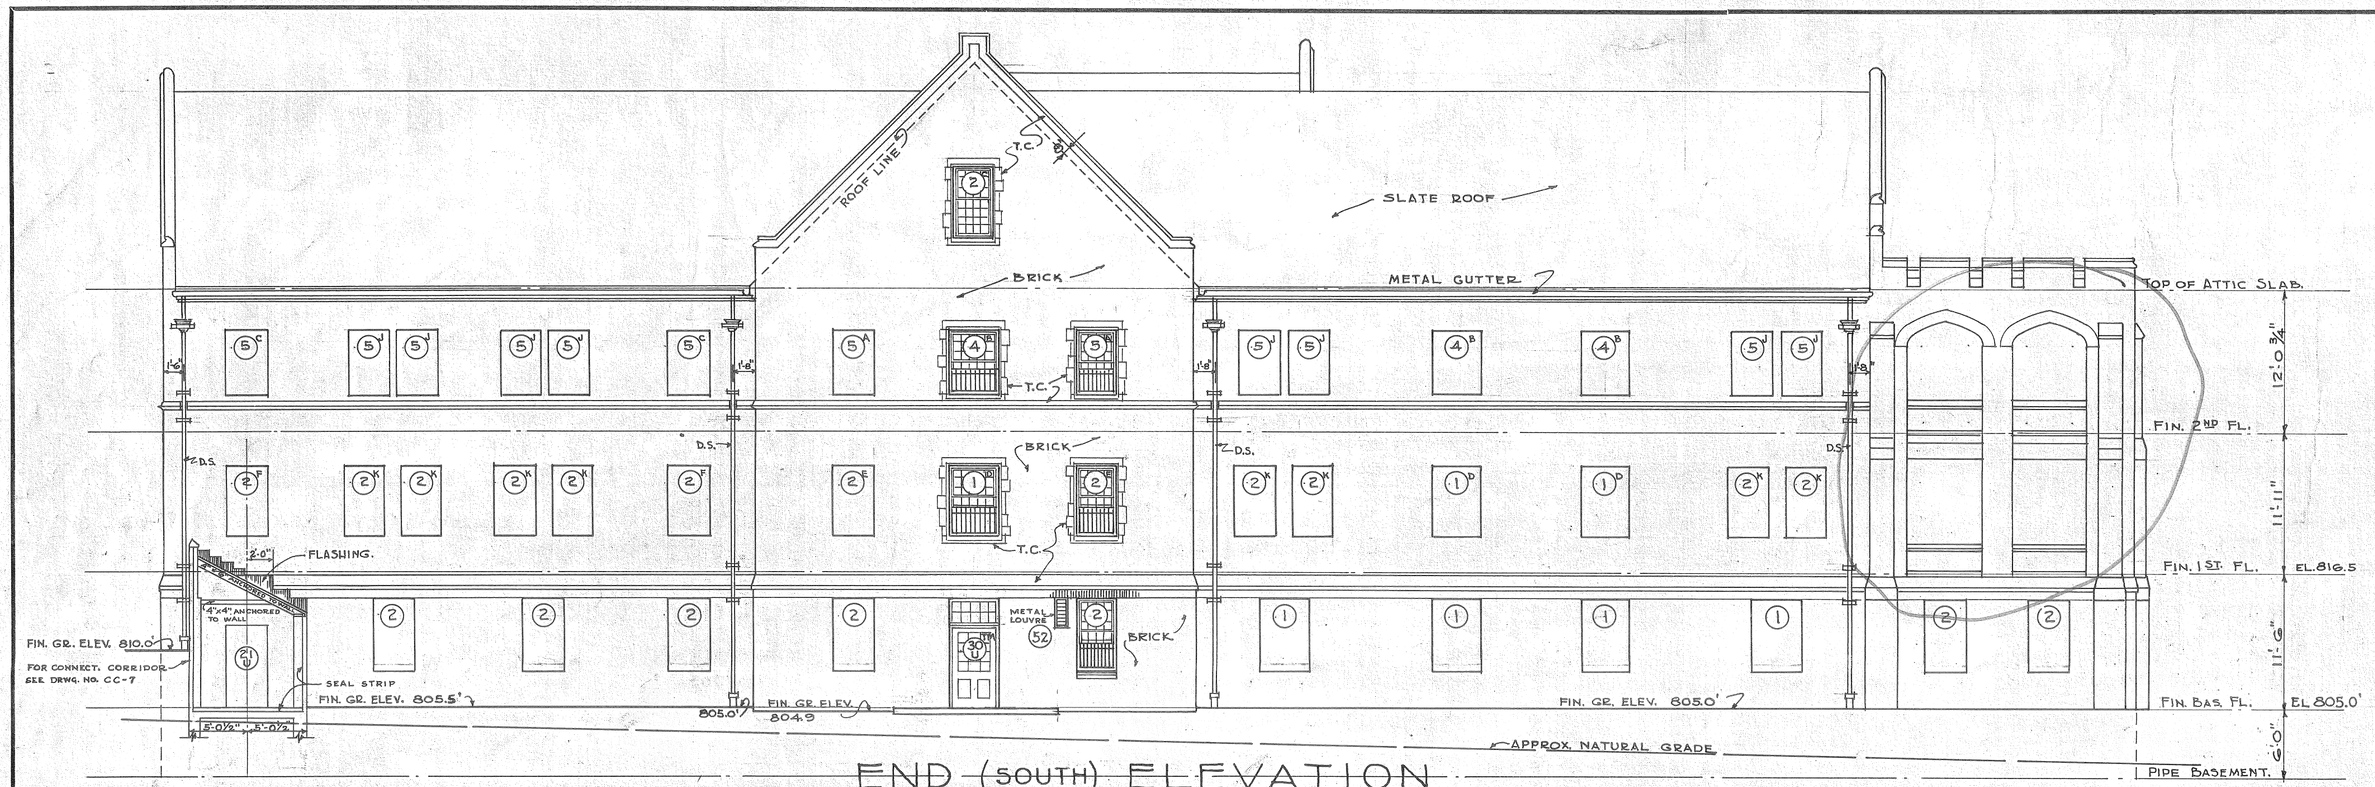

END (SOUTH) ELEVATION

SCALE 1/8" = 1'-0"

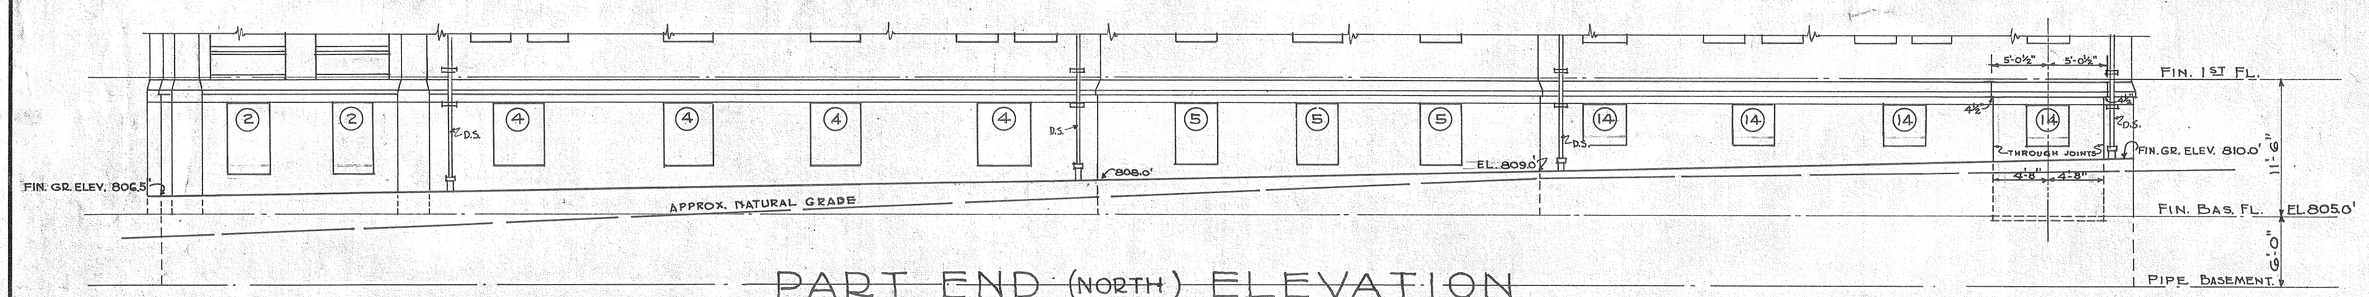

PART END (NORTH) ELEVATION

SCALE 1/8" = 1'-0"

NOTE - THIS ELEVATION ABOVE FIRST FLOOR IS SIMILAR TO END (SOUTH) ELEVATION.

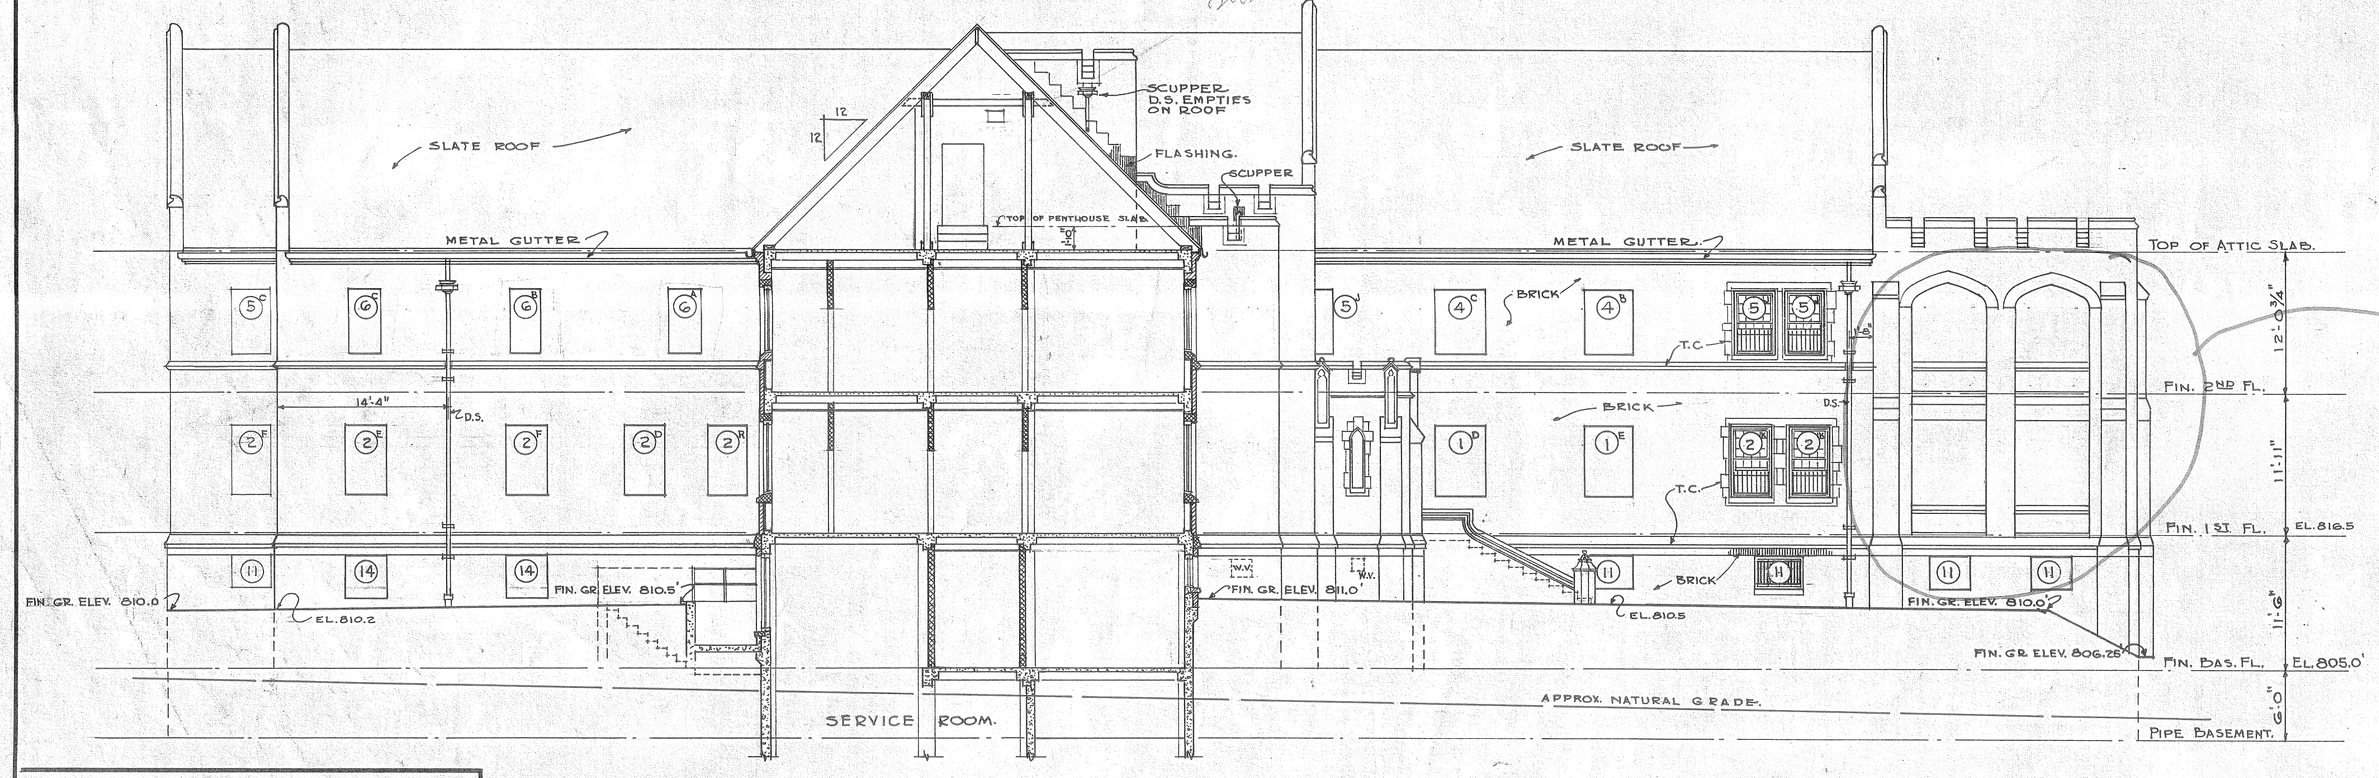

SECTION ON LINE "X X"

SCALE 1/8" = 1'-0"

ELEVATIONS OF ACUTE BUILDING No 36

TO BE USED IN CONJUNCTION WITH STRIP ELEVATIONS OF ACUTE BUILDING No 37.

SEE SHEET No 37-2

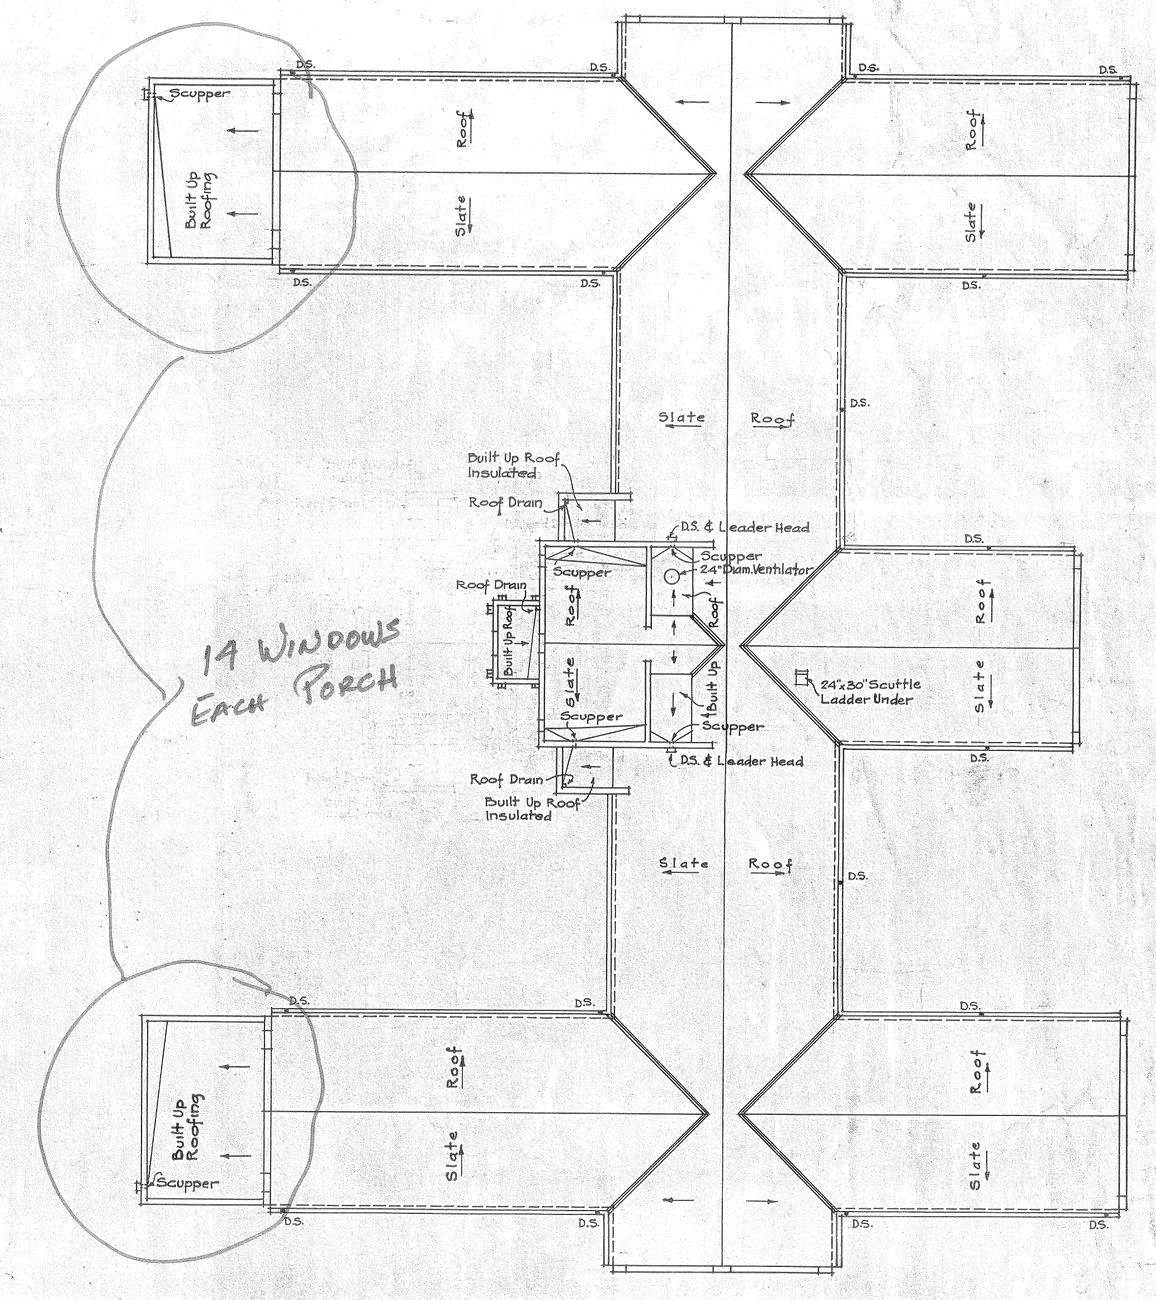

14 WINDOWS EACH PORCH

ROOF PLAN FOR ACUTE BUILDINGS No 36 & 37

SCALE 1/8" = 1'-0"

1/16"

REPLACE 14 WINDOWS, EACH PORCH - 7 INSERTS ON EACH 2nd FLOOR OVER WINDOWS.

PROJECT #528A5-09-519

2-6-2-0424

ARCH

FOR ARCHITECTURAL DETAILS SEE DRWGS. Nos 34-6 TO 34-10

FOR MISCELLANEOUS DETAILS SEE DRWGS. Nos 91 TO 94

VETERANS ADMINISTRATION
WASHINGTON, D. C.

APPROVED Frank T. Hines Administrator

George E. Jones Assistant Administrator

J. V. Tripp Director of Construction

W. J. Talbot Chief, Technical Division

ACUTE BUILDINGS Nos. 36 & 37.

VETERANS ADMINISTRATION

CANANDAIGUA, N.Y.

	REVISIONS	NUMBER
Drawn JENKINSON FRANCE		36-5
Traced JENKINSON FRANCE		
Sec. Chf. DLC		
Date APRIL 1, 1944		SHEET 5 OF 26
Sub-division Chief R. E. Guard		Proj. No. 2230

RETURN TRACINGS TO PLAN FILES

FILE FOLDER NO. 2-1